SURVEY OF PROPERTY

INCORPORATED VILLAGE OF EAST HAMPTON Town Of East Hampton Suffolk County. New York

SCALE: 1" = 20°

AREA: 5.682 sq.ft. or 0.1304 acres

Certified only to:

Sea Salt Hamptons. LLC AJS66. LLC Mano, LLC

LINE BEARING DISTANCE N 89° 05 '50 E 21.02

indicates found iron pina indicates found iron pipe. indicates set drill hole. indicates set 12" iron pin. indicates street light."

### NOTES:

- Unauthorized alteration or addition to a survey map bearing a licensed land surveyors seal is a violation of section 7209. sub-division 2 of the N.Y. State Education Law.
- Only copies from the original of this survey marked with an original of the land surveyor's embossed seal or inked seal shall be considered to be valid
- Certifications indicated hereon signify that this survey was prepared in accordance with the existing Code of Practice for Land Surveys adopted by the N.Y. State Association of Professional Land Surveys. Said certifications N. 1. State Association of Frotessional Lana Jurveyors. Jaia certifications shall run only to the person for whom the survey is prepared, and on his behalf to the Title company, governmental agency and Lending institution listed hereon, and to the assignees of the lending institution. Certifications are not transferable to additional institutions or subsequent owners.
- Underground improvements or encroachments, if any, are not shown hereon.
- The existence of right of ways, wetlands and/or easements of record, if any, not shown are not guaranteed.
- All natural features shown on survey, including but not limited to Bluff Crest. Clearing, and Wetlands should be verified with the appropriate regulatory agency.

### COVERAGE CALCULATIONS

Permitted: 1.636 sq.ft. (20% of Lot Area + 500 sq.ft.) Existing: 1.231 sq.ft.

# MAXIMUM GROSS FLOOR AREA OF PRINCIPAL DWELLING:

Permitted: 1.568 sq.ft. (10% of Lot Area + 1000 sq.ft. (20.000 sq.ft. max.)) Existing ground floor: 757 sq.ft. (2nd floor not measured)

## MAXIMUM GROSS FLOOR AREA OF ACCESSORY BUILDINGS:

Permitted: 313 sq.ft. (2% of Lot Area + 200 sq.ft.) Existing ground floor: 375 sq.ft. (2nd floor not measured)

(As Per East Hampton Village Code)

October 18. 2014: Update & recertify
August 6. 2012: Update
June 17. 2010: Plot setbacks & coverage calculations

SCTM No. 301-002-2-16

October 17. 2008: Revise certifications October 13. 2008: Update

Surveyed: August 4. 1997 David L. Saskas N.Y.S. Lic. No. 049960

Saskas Surveying Company, P.C. 124 Cedar Street East Hampton. New York 11937 SURVEYING (631) 324-6917 FAX 329-4768

103p64A



Not a valid copy unless marked with original land surveyor's embossed seal & signature

P.\GXD\Maps\1\103p64a,gxd = 07/03/2017 = 10:27 AM -- Scale 1 : 240,00

INCORPORATED VILLAGE OF EAST HAMPTON

Town Of East Hampton Suffolk County, New York

SCALE: | " = 20 '

AREA: 5.682 sq.ft. or 0.1304 acres

Certified only to:

Sea Salt Hamptons. LLC

AJS66, LLC

Mano. LLC

LINE BEARING DISTANCE N 89° 05' 50 E 21.02

indicates found iron pin. indicates found iron pipe 0 indicates set drill hole. indicates set 12" iron pina indicatés street light.

#### NOTES:

- Unauthorized alteration or addition to a survey map bearing a licensed land surveyors seal is a violation of section 7209, sub-division 2 of the N.Y. State Education Law
- Only copies from the original of this survey marked with an original of the land surveyor's embossed seal or inked seal shall be considered to be valid
- Certifications indicated hereon signify that this survey was prepared in accordance with the existing Code of Practice for Land Surveys adopted by the N.Y. State Association of Professional Land Surveyors. Said certifications shall run only to the person for whom the survey is prepared, and on his behalf to the Title company, governmental agency and Lending institution listed hereon, and to the assignees of the lending institution. Certifications are not transferable to additional institutions or subsequent owners.
- Underground improvements or encroachments, if any, are not shown hereon.
- The existence of right of ways. wetlands and/or easements of record. if any. not shown are not guaranteed.
- All natural features shown on survey, including but not limited to Bluff Crest, Clearing, and Wetlands should be verified with the appropriate regulatory agency.

### COVERAGE CALCULATIONS

Permitted: 1.636 sq.ft. (20% of Lot Area + 500 sq.ft.) Existing: 1.231 sq.ft.

## MAXIMUM GROSS FLOOR AREA OF PRINCIPAL DWELLING:

Permitted: 1.568 sq.ft. (10% of Lot Area + 1000 sq.ft. (20.000 sq.ft. max.)) Existing ground floor: 757 sq.ft. (2nd floor not measured)

# MAXIMUM GROSS FLOOR AREA OF ACCESSORY BUILDINGS:

Permitted: 313 sq.ft. (2% of Lot Area + 200 sq.ft.) Existing ground floor: 375 sq.ft. (2nd floor not measured)

(As Per East Hampton Village Code)

Not a valid copy unless marked with original land surveyor's embossed seal & signature


SCTM No. 301-002-2-16

October 18. 2014: Update & recertify August 6. 2012: Update June 17. 2010: Plot setbacks & coverage calculations October 17. 2008: Revise certifications October 13. 2008: Update

Surveyed: August 4. 1997 David L. Saskas N.Y.S. Lic. No. 049960

Saskas Surveying Company. P.C 124 Cedar Street East Hampton. New York 11937 5 URVEYING (631) 324-6917 FAX 329-4768

103p64A

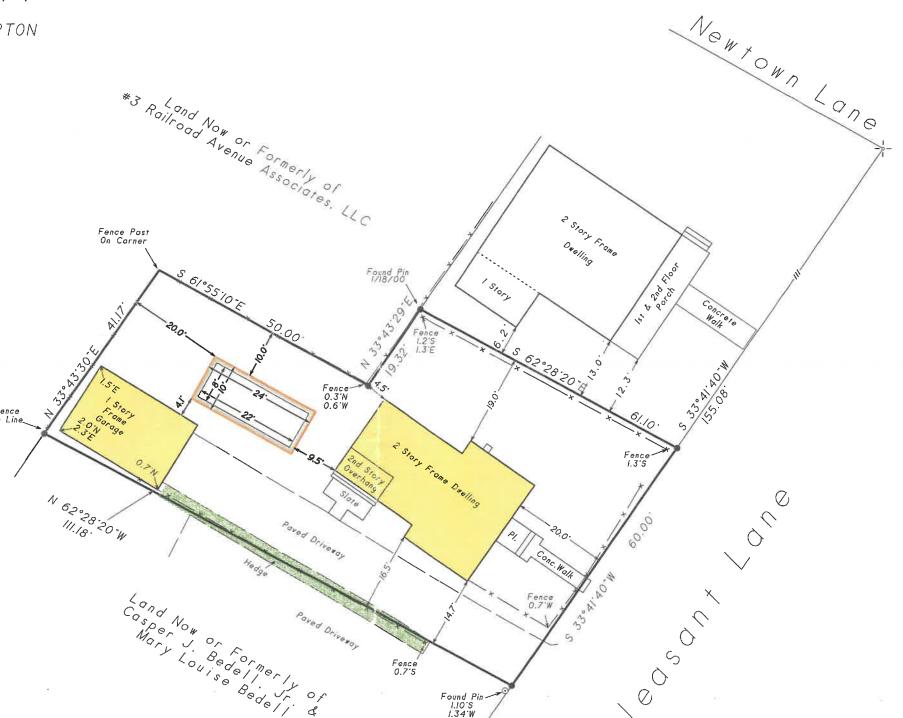

■P:\GXD\Maps\1\103p64a.gxd – 12/12/2017 – 03:04 PM – Scale 1 : 240■