


MAPLE STREET

PULASKI (PROSPECT AVENUE)

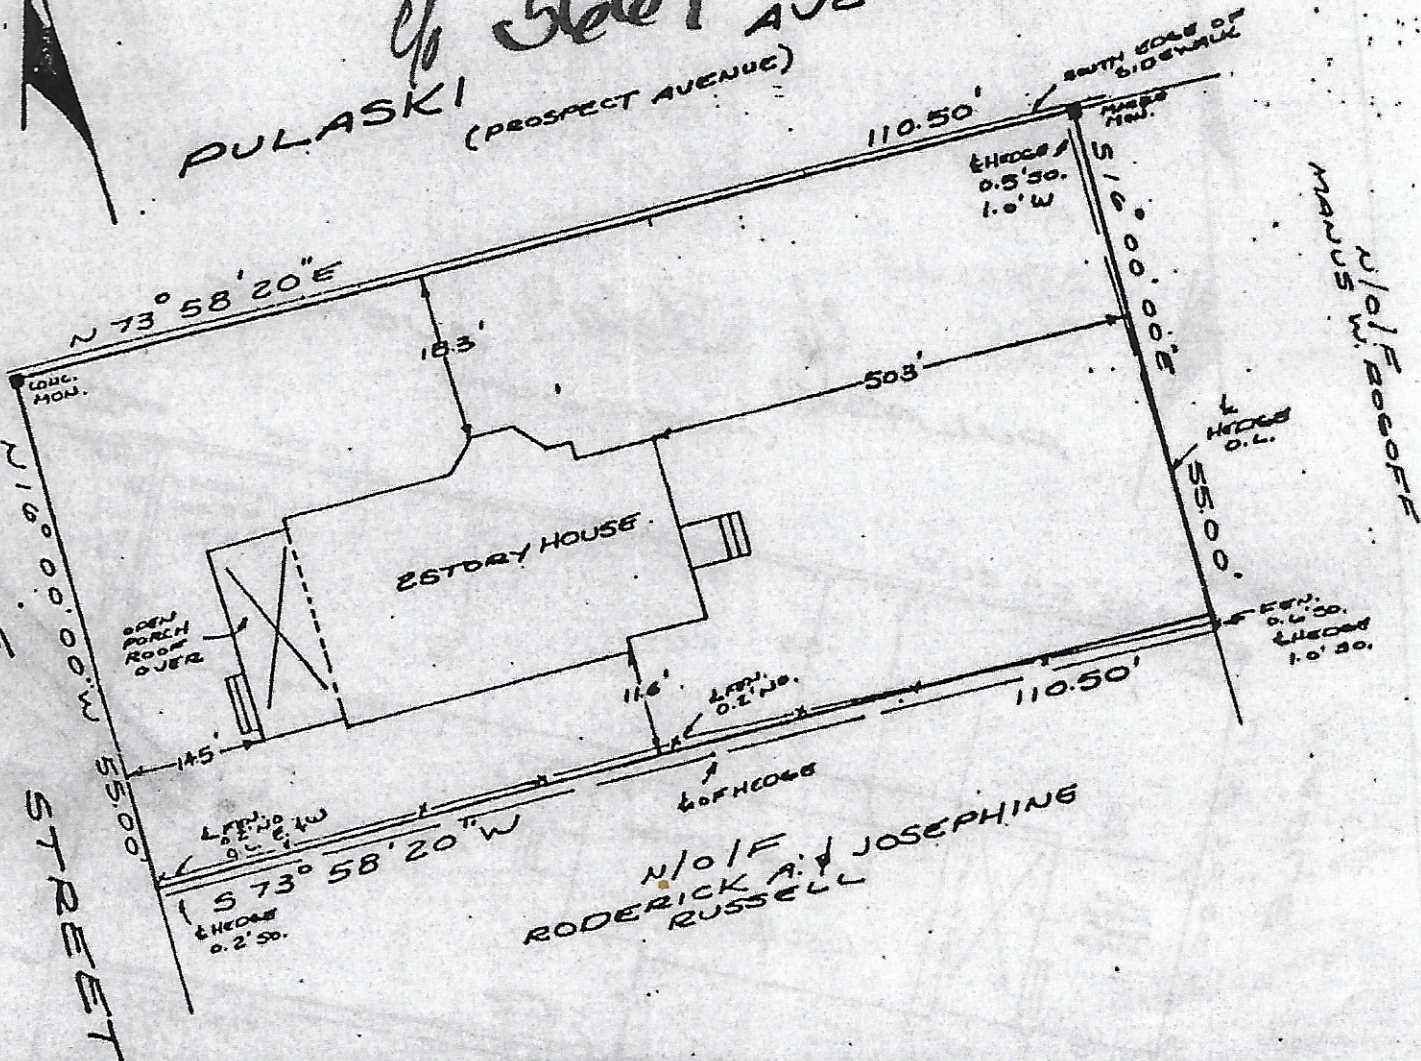

RODERICK A. JOSEPHINE
RUSSELL

MAP OF PROPERTY
for
DAVID & DIANE STEVENS
'SITATE'

INC. VILLAGE OF SOUTHAMPTON
TOWN OF SOUTHAMPTON
SUFFOLK COUNTY, N.Y.
SCALE 1" = 20'

AREA = 6078 SQ. FT.
(0.140 AC.)

CERTIFIED TO:
THE CHICAGO TITLE INSURANCE COMPANY
OMNI ABSTRACT CORP.
DAVID & DIANE STEVENS



SURVEYED BY N. 49548-2, 1987

LESTER HOLDEN L.S. NO. 49548

UNAUTHORIZED ALTERATION OR ADDITION
TO THIS SURVEY IS A VIOLATION OF
SECTION 7209 OF THE NEW YORK STATE
EDUCATION LAW.

COPIES OF THIS SURVEY MAP NOT BEARING
THE LAND SURVEYOR'S GREEN INKED SEAL OR
ENCLOSURE SEAL SHALL NOT BE CONSIDERED
TO BE A VALID TRUE COPY.

GUARANTEES INDICATED HEREON SHALL RUN
ONLY TO THE PERSON FOR WHOM THE SURVEY
IS PREPARED, AND ON HIS BEHALF TO THE
TITLE COMPANY GOVERNMENTAL AGENCY AND
LENDING INSTITUTION LISTED HEREON, AND
TO THE ASSIGNEES OF THE LENDING INSTI-
TUTION. GUARANTEES ARE NOT TRANSFERABLE
TO ADDITIONAL INSTITUTIONS OR SUBSEQUENT

SUFFOLK COUNTY TAX MAP
DISTRICT 0904
SECTION 005.00
BLOCK 04.00
PARCEL 014.000