

Water Main (Approx.)
R09020192
Meadows East

Barn Lane

R: 55.00'
L: 34.24'

L: 68.28'
R: 225.00'

w.m.

L: 115.32'

61.3'

51.00' E
51.00' E


Gravel Drive

Gravel Drive W

elec. meter

250.93'

Lot 9

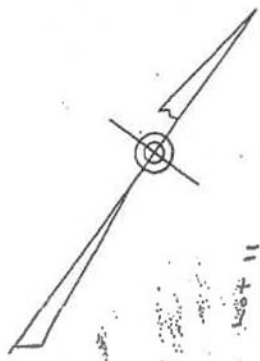

11
7.50'

Cleared Area =
29,314% or 62.5%

40.2'
271.31'
23-59-26
26-52-27

40.2'

104.2

119.6

44.3

S 67.52-59 W

N/F Walter CL

144.59'



SURVEY OF PROPERTY
SITUATE :