


€ : Fine Cash
€ : Cash

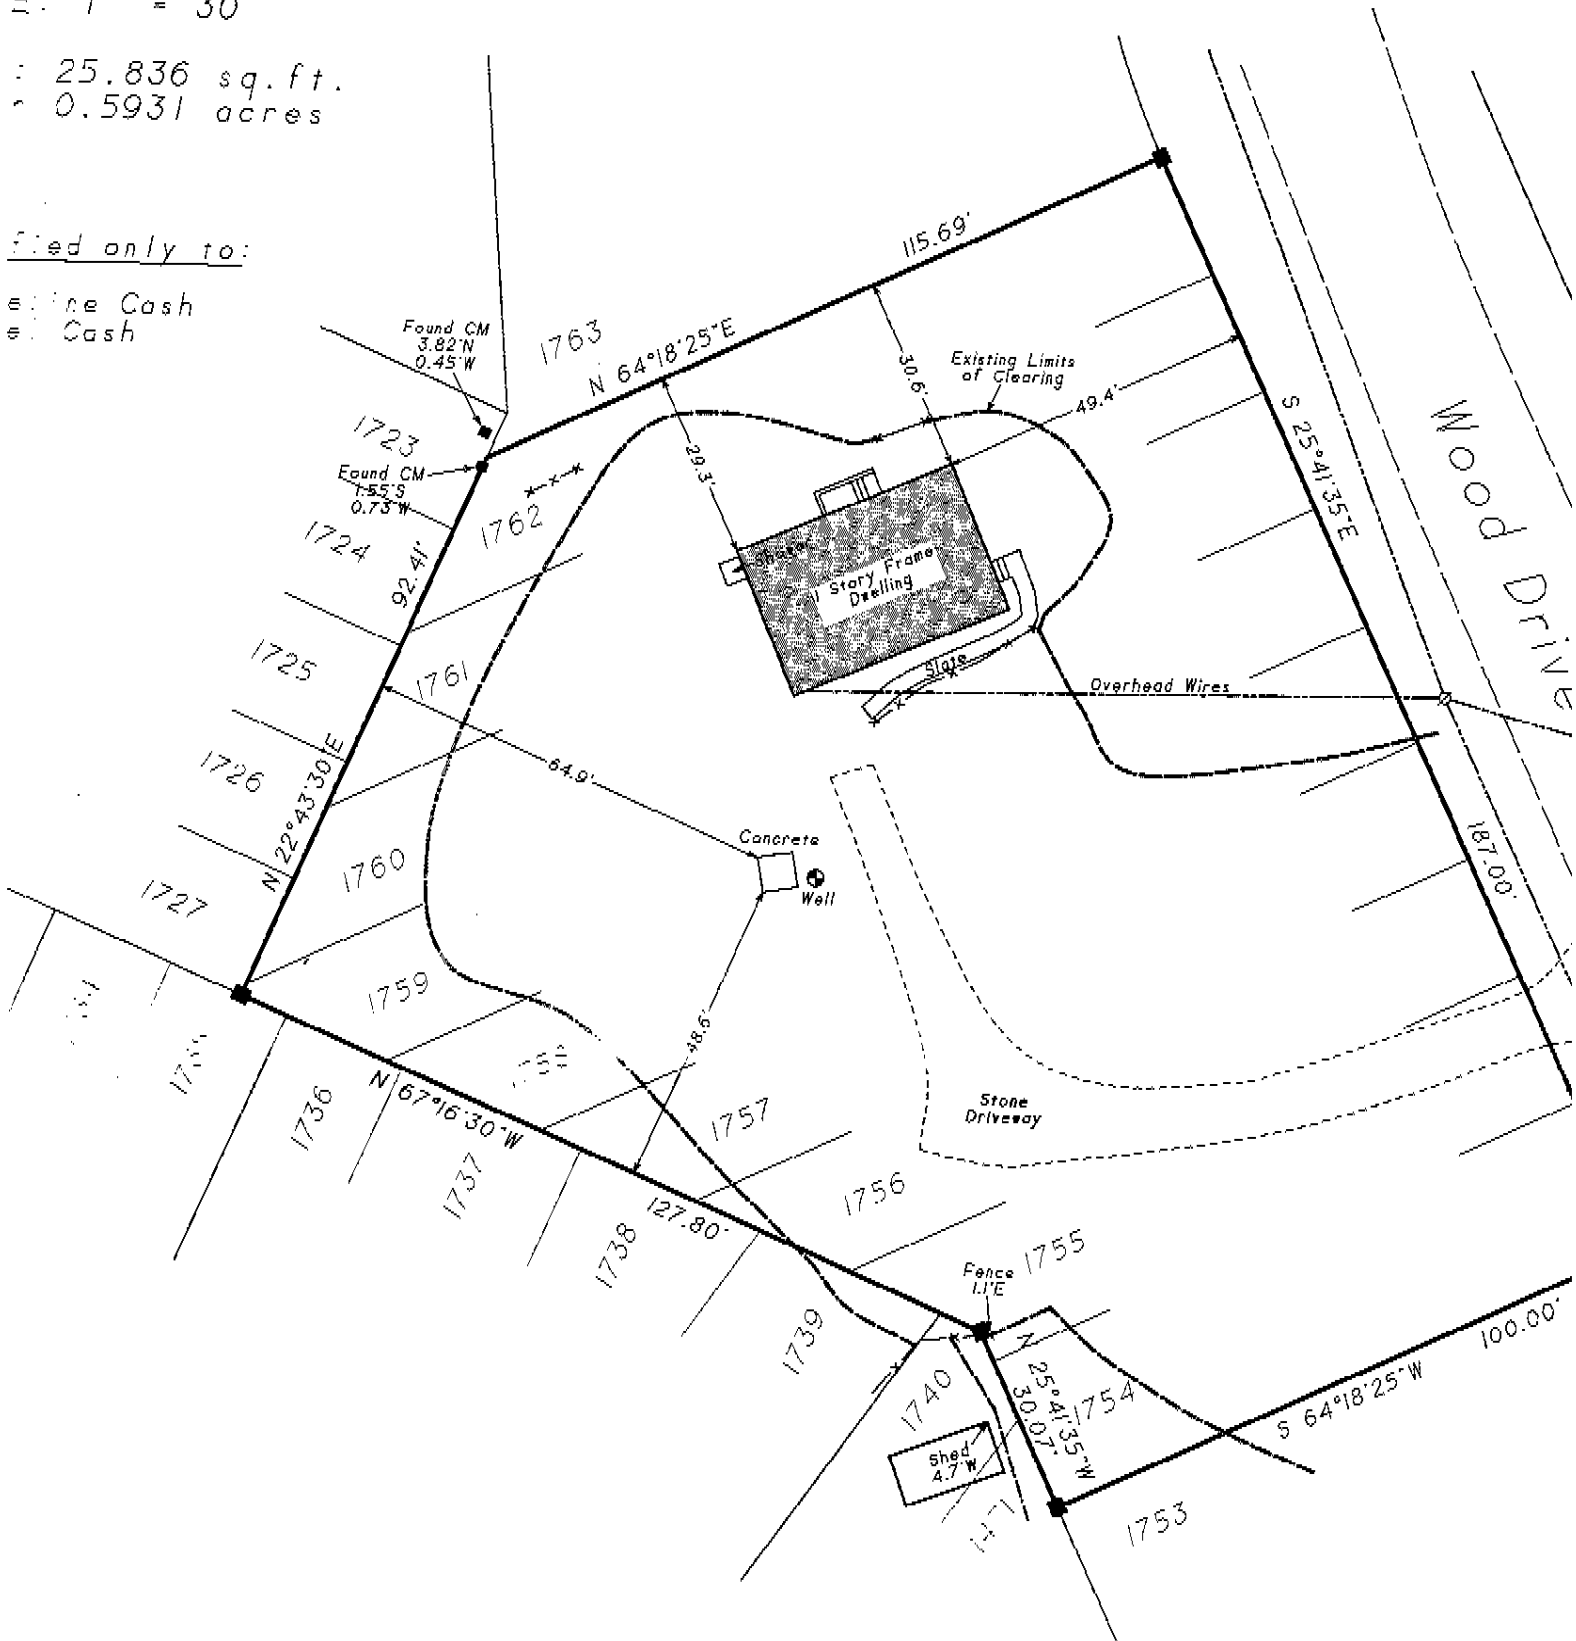

CALCULATION:

limits of Clearing: 18.004 sq.ft.
Limits of Clearing: 16.459 sq.ft.
($16.459 \times 25\% + 10.000$ sq.ft.)

Severe Roc