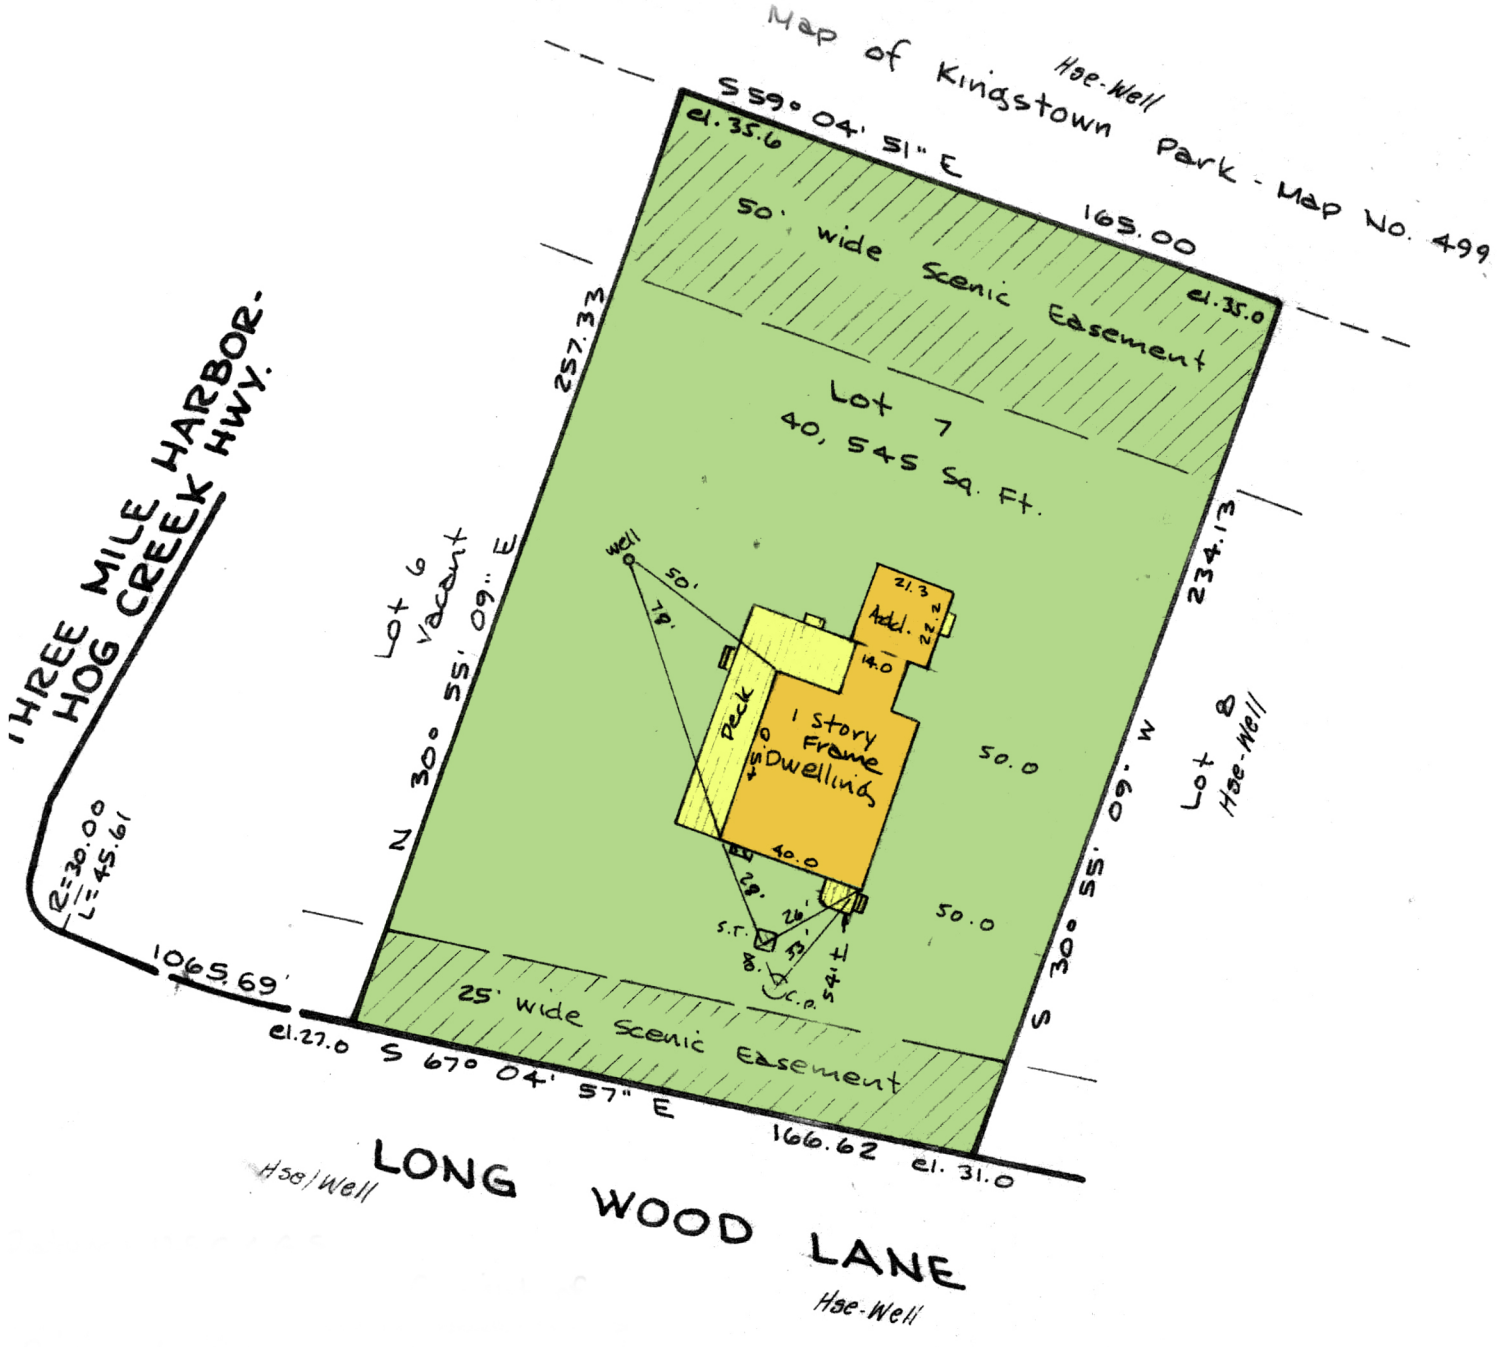
Map of Kingstown Park - Map No. 499
Hse-Well
S 59° 04' 51" E
165.00
el. 35.6
el. 35.0
50' wide Scenic Easement
257.33
Lot 7
40,545 Sq. Ft.
Lot 6 Vacant
N 30° 55' 09" E
234.13
S 30° 55' 09" W
Lot 8 Hse-Well
THREE MILE HARBOR-HOG CREEK HWY.
R=30.00
L=45.61
1065.69'
el. 27.0
S 67° 04' 57" E
166.62
el. 31.0
25' wide Scenic Easement
Hse/Well
LONG WOOD LANE
Hse-Well
Well
50'
78'
21.3
Add. 22.2
14.0
Deck
1 Story Frame Dwelling
40.0
50.0
50.0
28'
26'
S.T.
13'
8'
C.P.
54'