


SURVEYED FOR: ANTHONY & SANDRA HALLINGER
PROPERTY LOCATED AT MONTAUK
LOT No. 4

MAP OF CULLODEN POINT
FILED: DECEMBER 21, 1995: FILE NO 9785
TOWN OF EAST HAMPTON
SUFFOLK COUNTY, NEW YORK
S.C.T.M. # 300-009-01-8.6
AREA = 50.854 SF = 1.167 AC
SCALE: 1"=40'

NOTE: THE EXISTENCE OF RIGHT OF WAYS,
WETLANDS AND/OR EASEMENTS OF RECORD
IF ANY, NOT SHOWN ARE NOT GUARANTEED.

UNAUTHORIZED ALTERATION OR ADDITION TO THIS SURVEY IS A VIOLATION
OF SECTION 7289 OF THE NEW YORK STATE EDUCATION LAW.
COPIES OF THIS SURVEY MAP NOT BEARING THE LAND SURVEYORS INKED
OR EMBOSSED SEAL SHALL NOT BE CONSIDERED TO BE A VALID TRUE COPY.
GUARANTEES OR CERTIFICATIONS INDICATED HEREON SHALL RUN ONLY TO
THE PERSON FOR WHOM THE SURVEY IS PREPARED, AND ON HIS BEHALF TO
THE TITLE COMPANY, GOVERNMENTAL AGENCY AND LENDING INSTITUTION
LISTED HEREON, AND TO THE ASSIGNEES OF THE LENDING INSTITUTION,
GUARANTEES OR CERTIFICATIONS ARE NOT TRANSFERABLE TO ADDITIONAL
INSTITUTIONS OR SUBSEQUENT OWNERS.

CERTIFIED TO:
ANTHONY HALLINGER
SANDRA HALLINGER

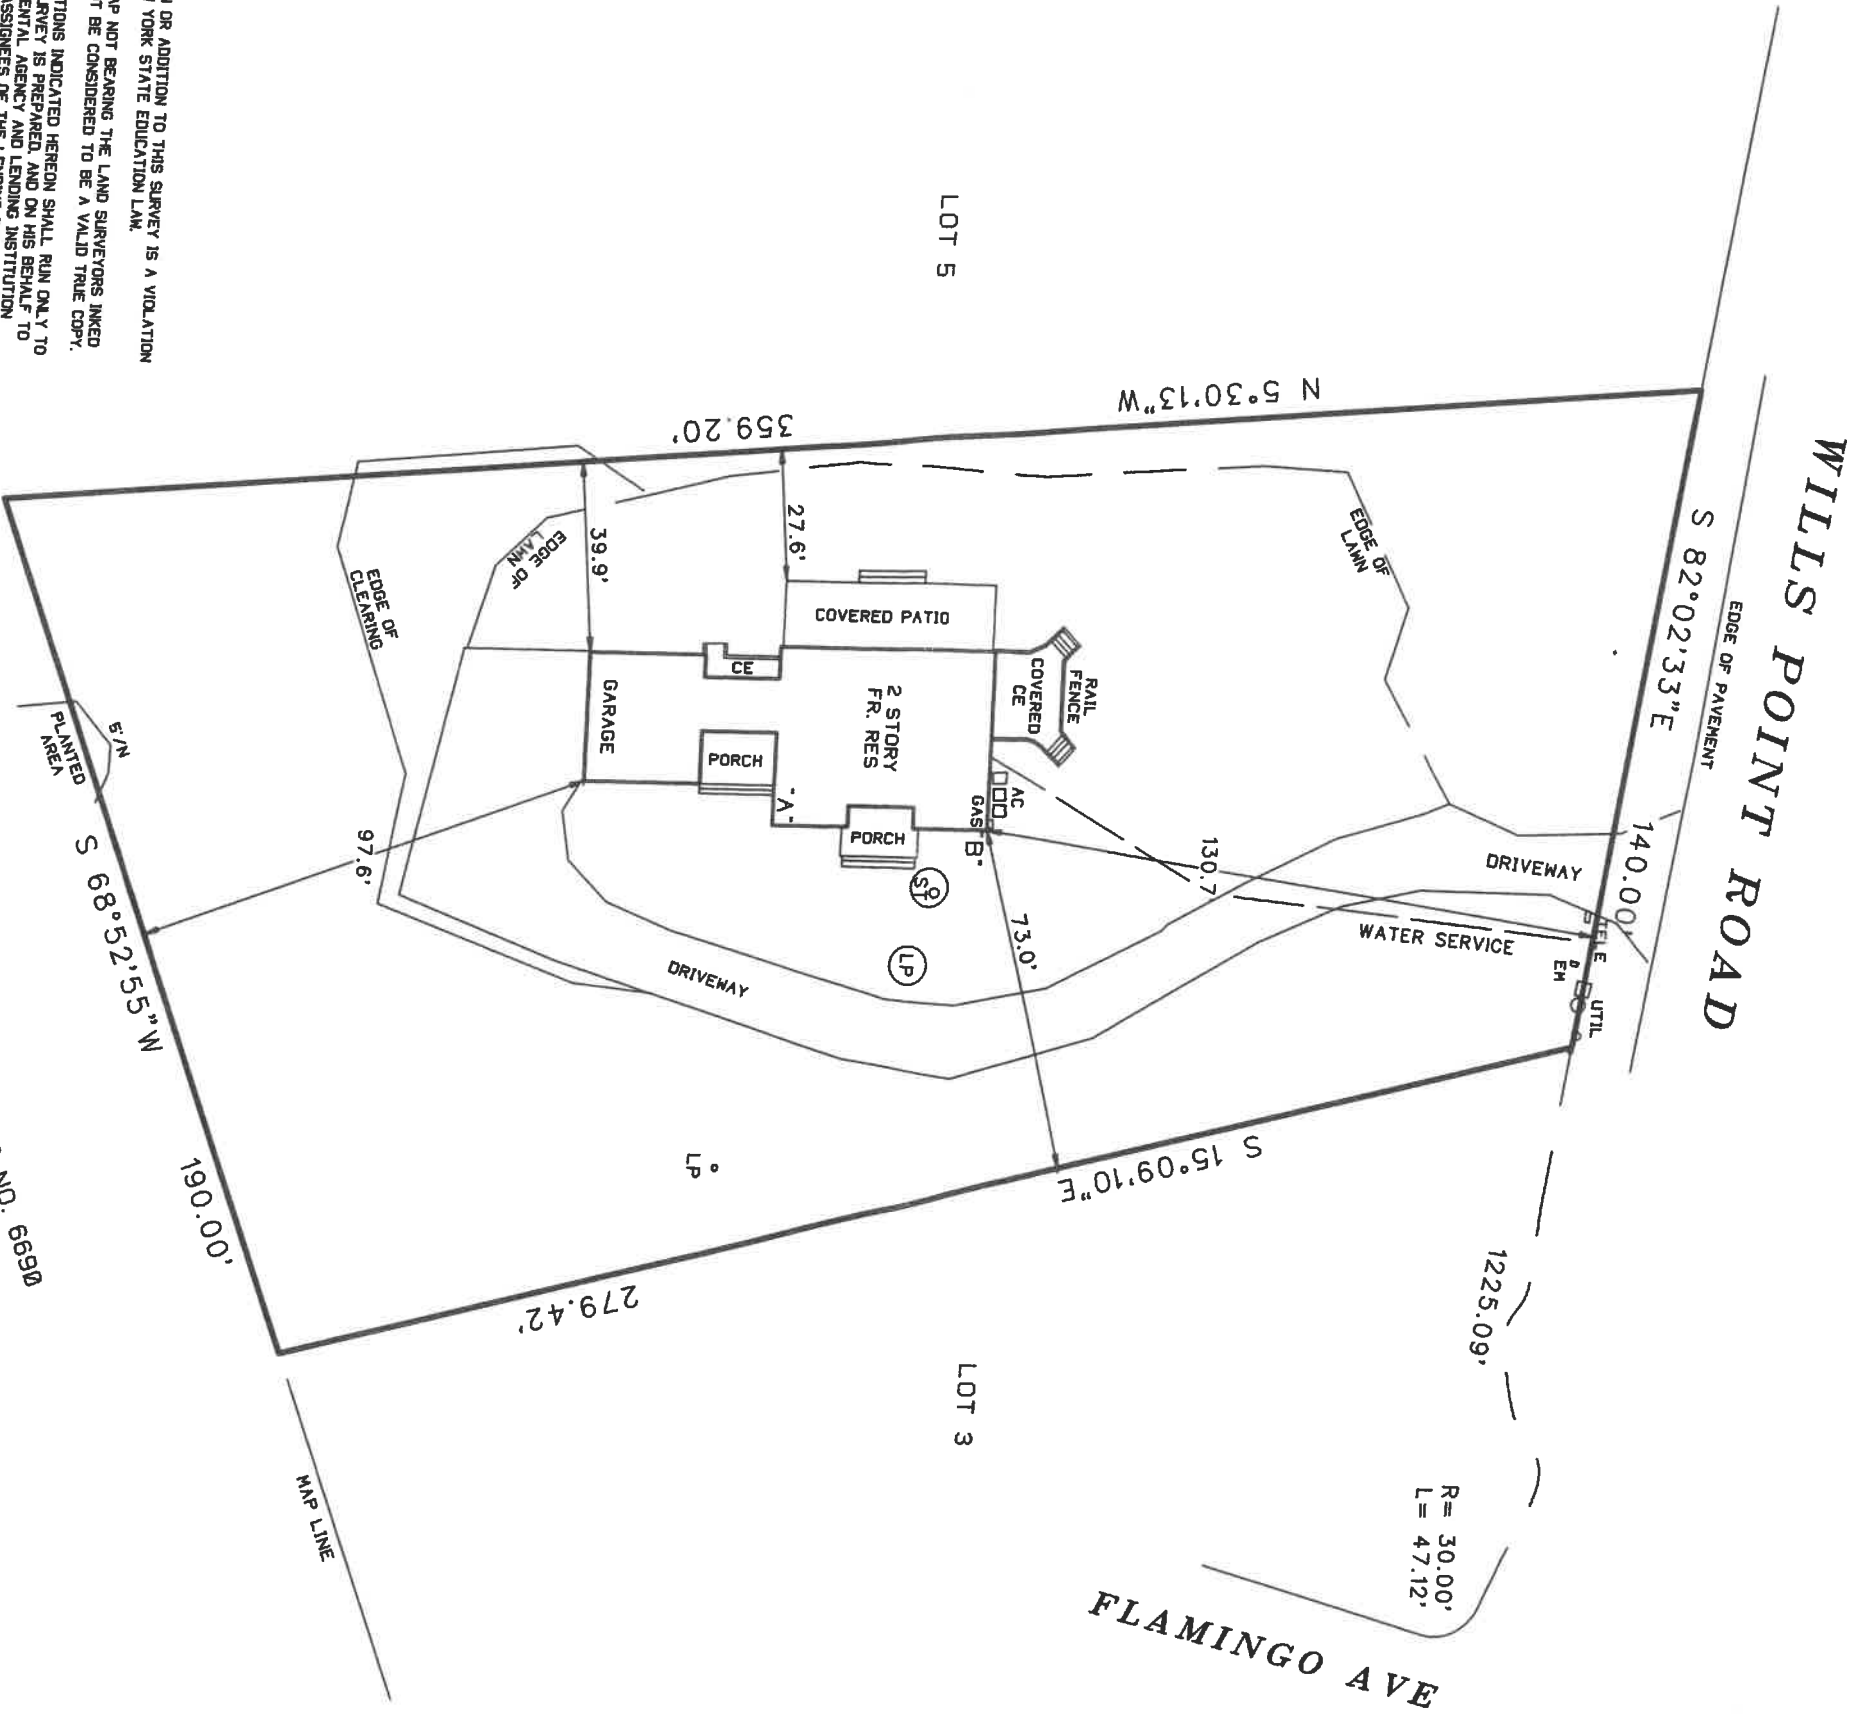

NOTE: WATER SERVICE AND SEPTIC SYSTEM
LOCATION BY OTHERS
SEPTIC LOCATION

	'A'	'B'
S.T.	38	17
L.P.	42	33



SURVEYED BY:
BARILSKI LAND SURVEYING
320 SOUTH ST. P.O. BOX 1302
BRIDGEHAMPTON, NEW YORK
1631-537-7944
MARCH 10, 2011
3-22-2011: SITE PLAN
5-13-2011: WELL
8-8-2011: REVISE SITE PLAN
11-1-2011: FIRST LOCATION SURVEY
12-26-2012: FINAL SURVEY