

NEW SUNSHINE Job. No. 1097
PROPERTY LOCATED AT EAST HAMPTON

MAP OF THE ESTATES OF MONTAUK
BLOCK 24; LOTS 35,36,37,38,39,40,41, P/L NEVILIS PLACE
FILED: JANUARY 29, 1913; FILE NO. 48

TOWN OF EAST HAMPTON

SUFFOLK COUNTY, NEW YORK

SCALE: 1" = 30'

PLOT AREA = 19600 S.F.

ASSUMED DATUM

EXISTING ELEVATION

Unauthorized alteration or addition to this survey is a violation of Section 7202 of the New York State Education Law.

Copies of this survey map not bearing the Land Surveyor's inked seal or embossed seal shall not be considered to be a valid true copy.

Guarantees or certifications indicated hereon shall run only to the person for whom the survey is prepared, and on his behalf, to the title company, governmental agency and lending institution listed herein, and to the assignees of the lending institution. Guarantees or certifications are not transferable to additional institutions or subsequent owners.

GUARANTEED TO:


UNION SAVINGS BANK
SECURITY TITLE & GUARANTY COMPANY

H. J. Bangs, Jr.

10495

S.G.T.M. NO. 300-096-02-20, P1019, P1021.1, P1021.2

HILDRETH PLACE

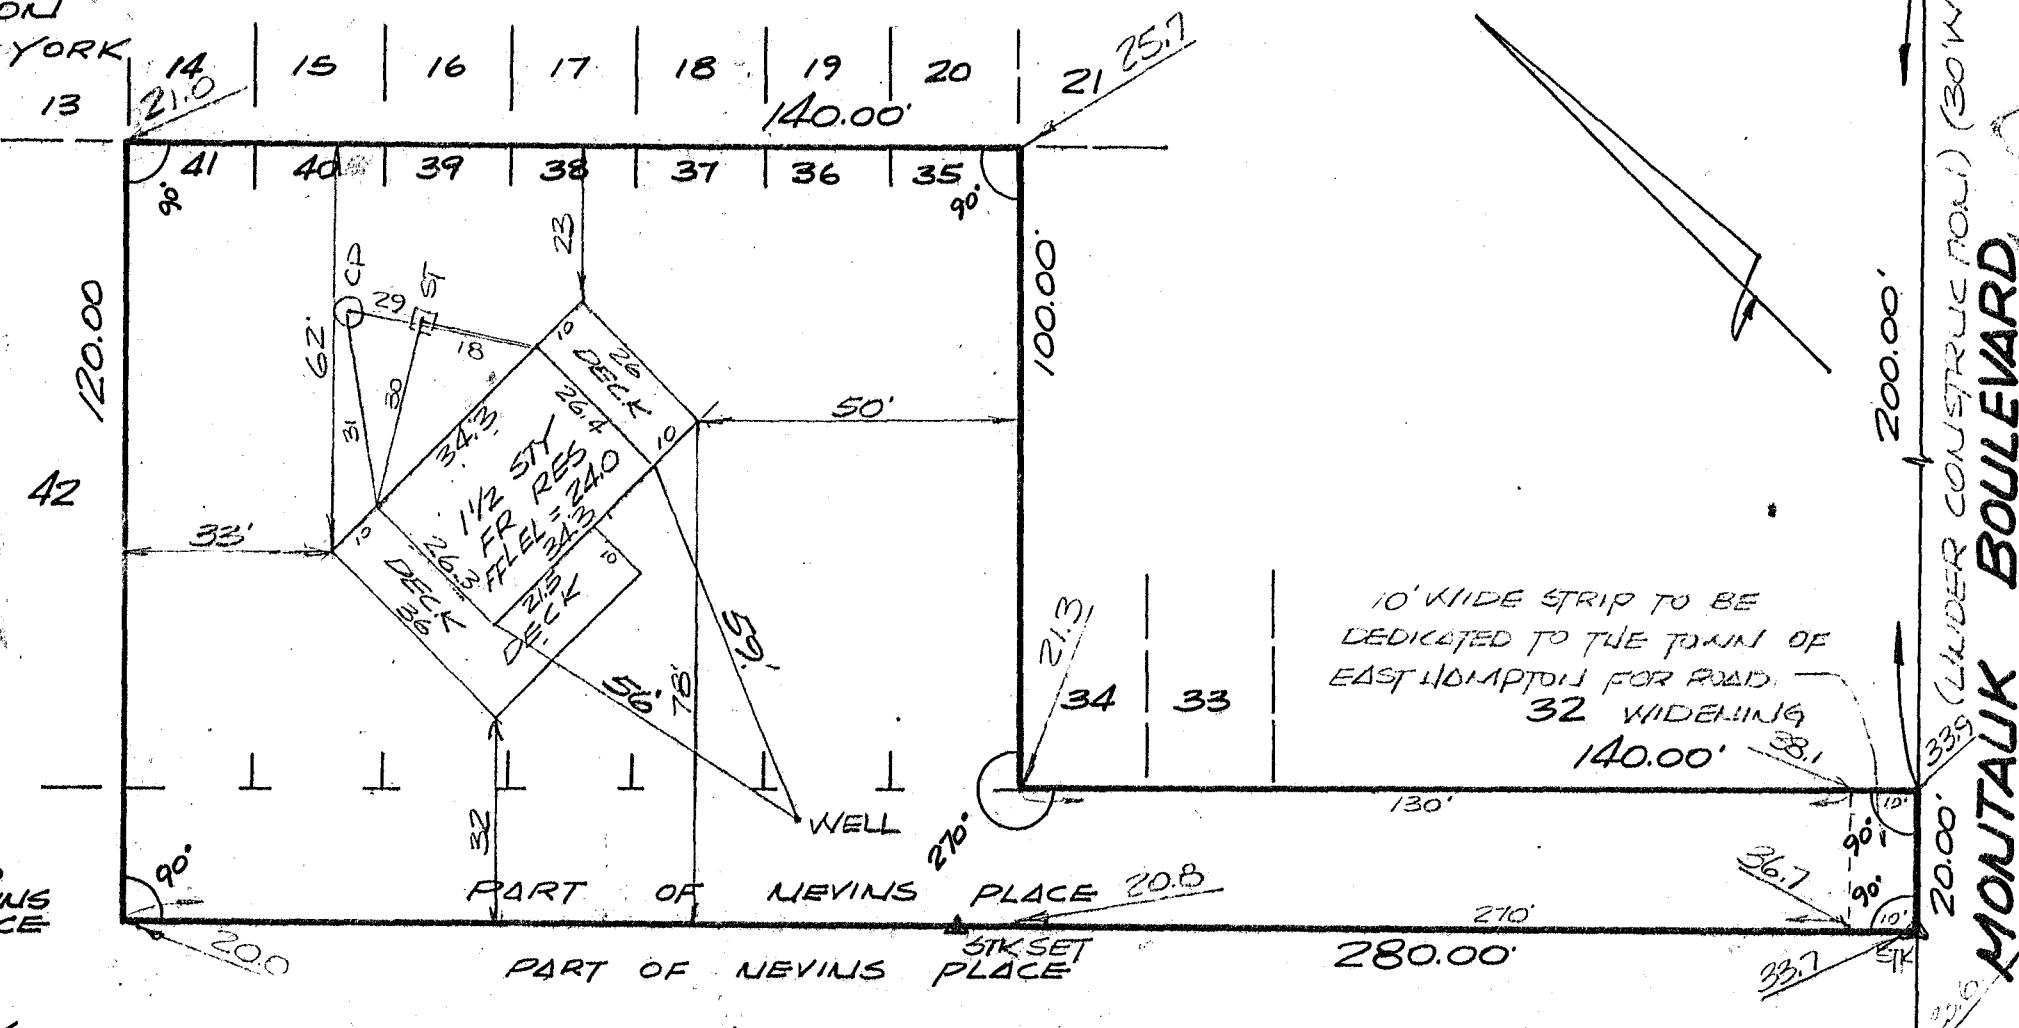

B.O.H. INFO FROM OTHERS

CHANGE GUARS: JULY 05, 1983
FINAL SURVEY: JULY 01, 1983
FIRST LOC: APRIL 26, 1983
STAKE OUT: MARCH 21, 1983
L.C.: MARCH 11, 1983

