


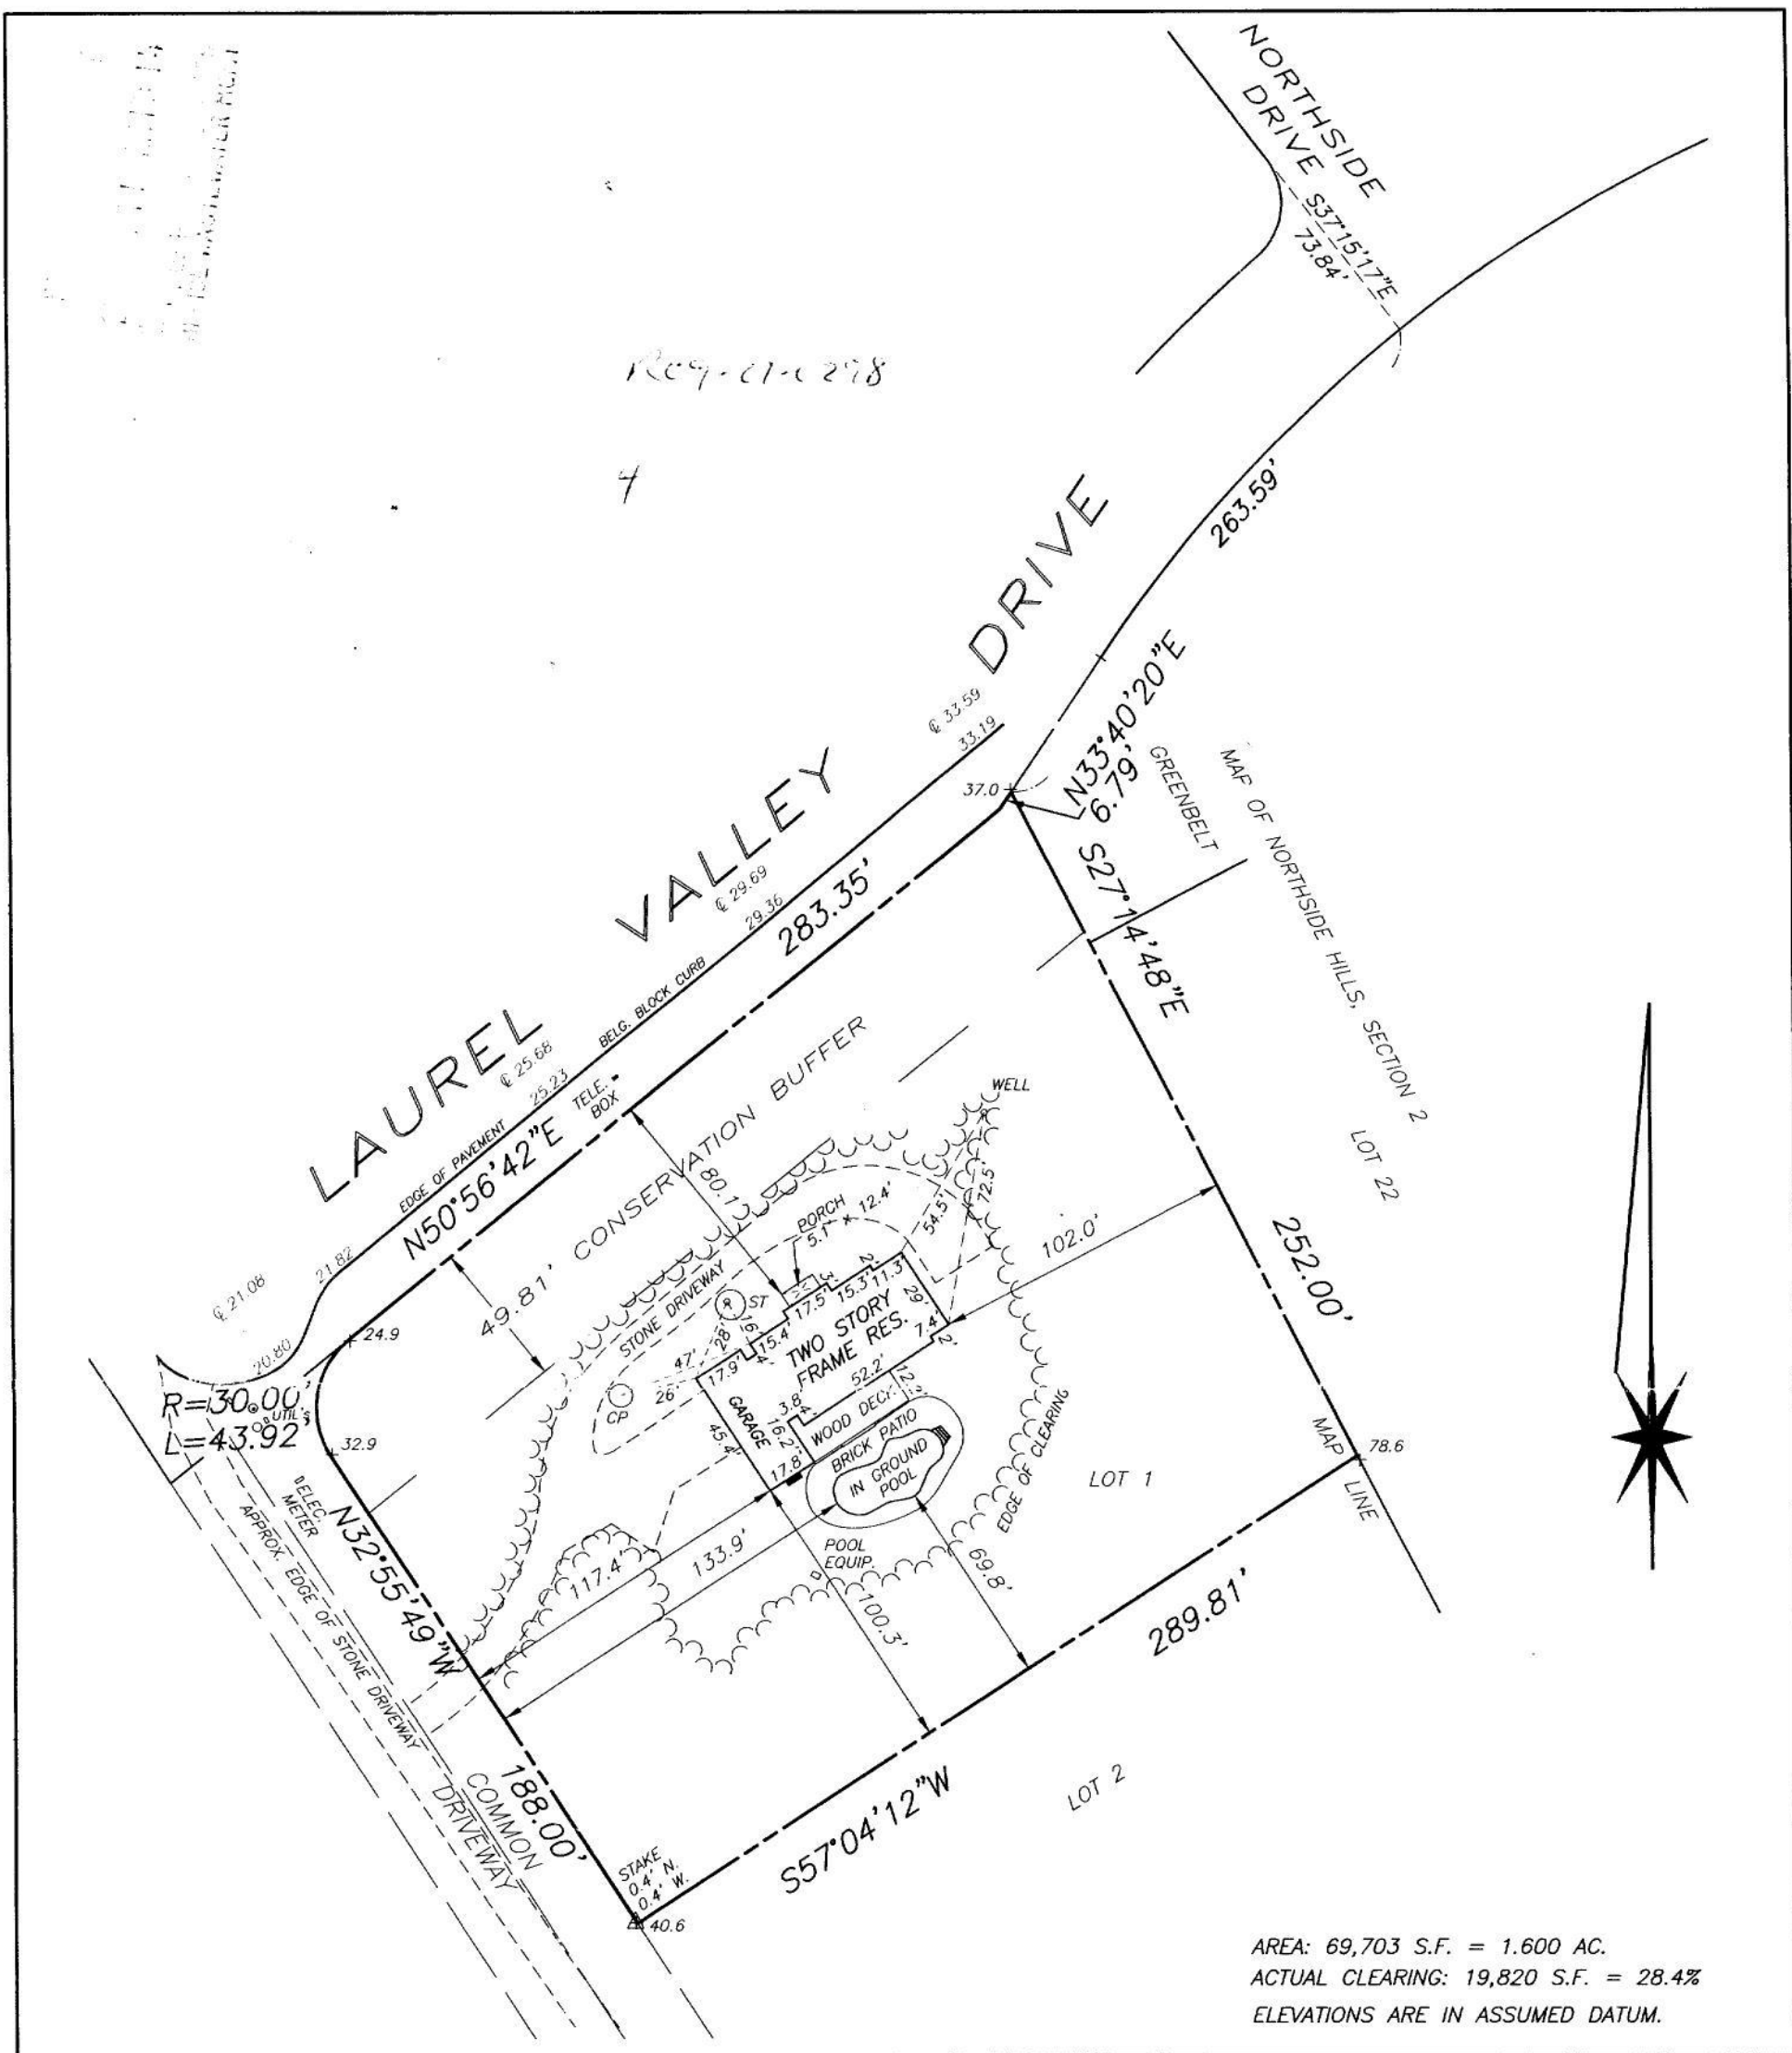

**SURVEY OF
LOT 1**
MAP OF
HIGHAMPTON
SITUATE AT
NOYACK
TOWN OF SOUTHAMPTON
SUFFOLK COUNTY, NEW YORK

SCALE: 1"=60' DATE: APRIL 25, 2001

S.C.T.M. DIST. 0900 SEC. 029 BLK. 04 LOT 007.019

JOB NO. F3508
MAP NO. 10531
FILED: NOV. 17, 2000
REVISIONS:
ADDED PR. HOUSE 05/08/2001
REV. PR. HOUSE 06/04/2001
REV. PROP. DRIVE 06/14/2001
REV. PROP. DRIVE/SAN. 06/19/2001
REV. 07/16/2001
REV. 07/18/2001
STAKE HOUSE 08/23/2001
ADD CERTS 10/01/2001
UNDER CONST. 02/12/2002
FINAL 08/05/2002
ADD SANITARY 08/20/2002
RE-LOCATE DRIVEWAY 09/16/2002

CERTIFIED TO:
COVENANT ABSTRACT INC.
FIDELITY NATIONAL TITLE INSURANCE COMPANY
SUNWOOD DEVELOPMENT CORP.
RAY RODECKER

PAT T. SECCAFICO
PROFESSIONAL LAND SURVEYOR, P.C.

— SUCCESSOR TO —

DONALD TASE, L.S.
RICHARD WILHELM AND ASSOCIATES
PROFESSIONAL LAND SURVEYORS
NORTHSTAR SURVEYING, P.C.

PAUL T. CANALIZO, L.S., ROBERT A. KART, L.S.
GOOD GROUND SURVEYORS, P.C.

328A Main Street
Center Moriches, NY 11934
PHONE: (631) 878-0120
FAX: (631) 878-7190

107-4 W. Montauk Highway
Hampton Bays, NY 11946
PHONE: (631) 728-5330
FAX: (631) 728-6707

N.Y.S. LIC. NO. 049287

COPYRIGHT - 2002 PAT T. SECCAFICO P.L.S., P.C.

EASEMENTS AND/OR SUBSURFACE STRUCTURES RECORDED OR UNRECORDED ARE NOT GUARANTEED UNLESS PHYSICALLY EVIDENT ON THE PREMISES AT THE TIME OF THE SURVEY. GUARANTEES INDICATED HEREON SHALL RUN ONLY TO THE PERSON(S) FOR WHOM THE SURVEY IS PREPARED, AND ON HIS BEHALF TO THE TITLE COMPANY, GOVERNMENTAL AGENCY AND LENDING INSTITUTIONS LISTED HEREON, AND TO THE ASSIGNEES OF THE LENDING INSTITUTION. GUARANTEES ARE NOT TRANSFERABLE TO ADDITIONAL INSTITUTIONS OR SUBSEQUENT OWNERS. THE OFFSETS (OR DIMENSIONS) SHOWN HEREON FROM THE STRUCTURES TO THE PROPERTY LINES ARE FOR A SPECIFIC PURPOSE AND USE AND THEREFORE ARE NOT INTENDED TO GUIDE THE ERECTION OF FENCES, RETAINING WALLS, POOLS, PATIOS, PLANTING AREAS, ADDITIONS TO BUILDINGS AND ANY OTHER CONSTRUCTION.

