


|      | "C" | "D"   |
|------|-----|-------|
| S.T. | 14' | 12.5' |
| L.P. | 24' | 26'   |

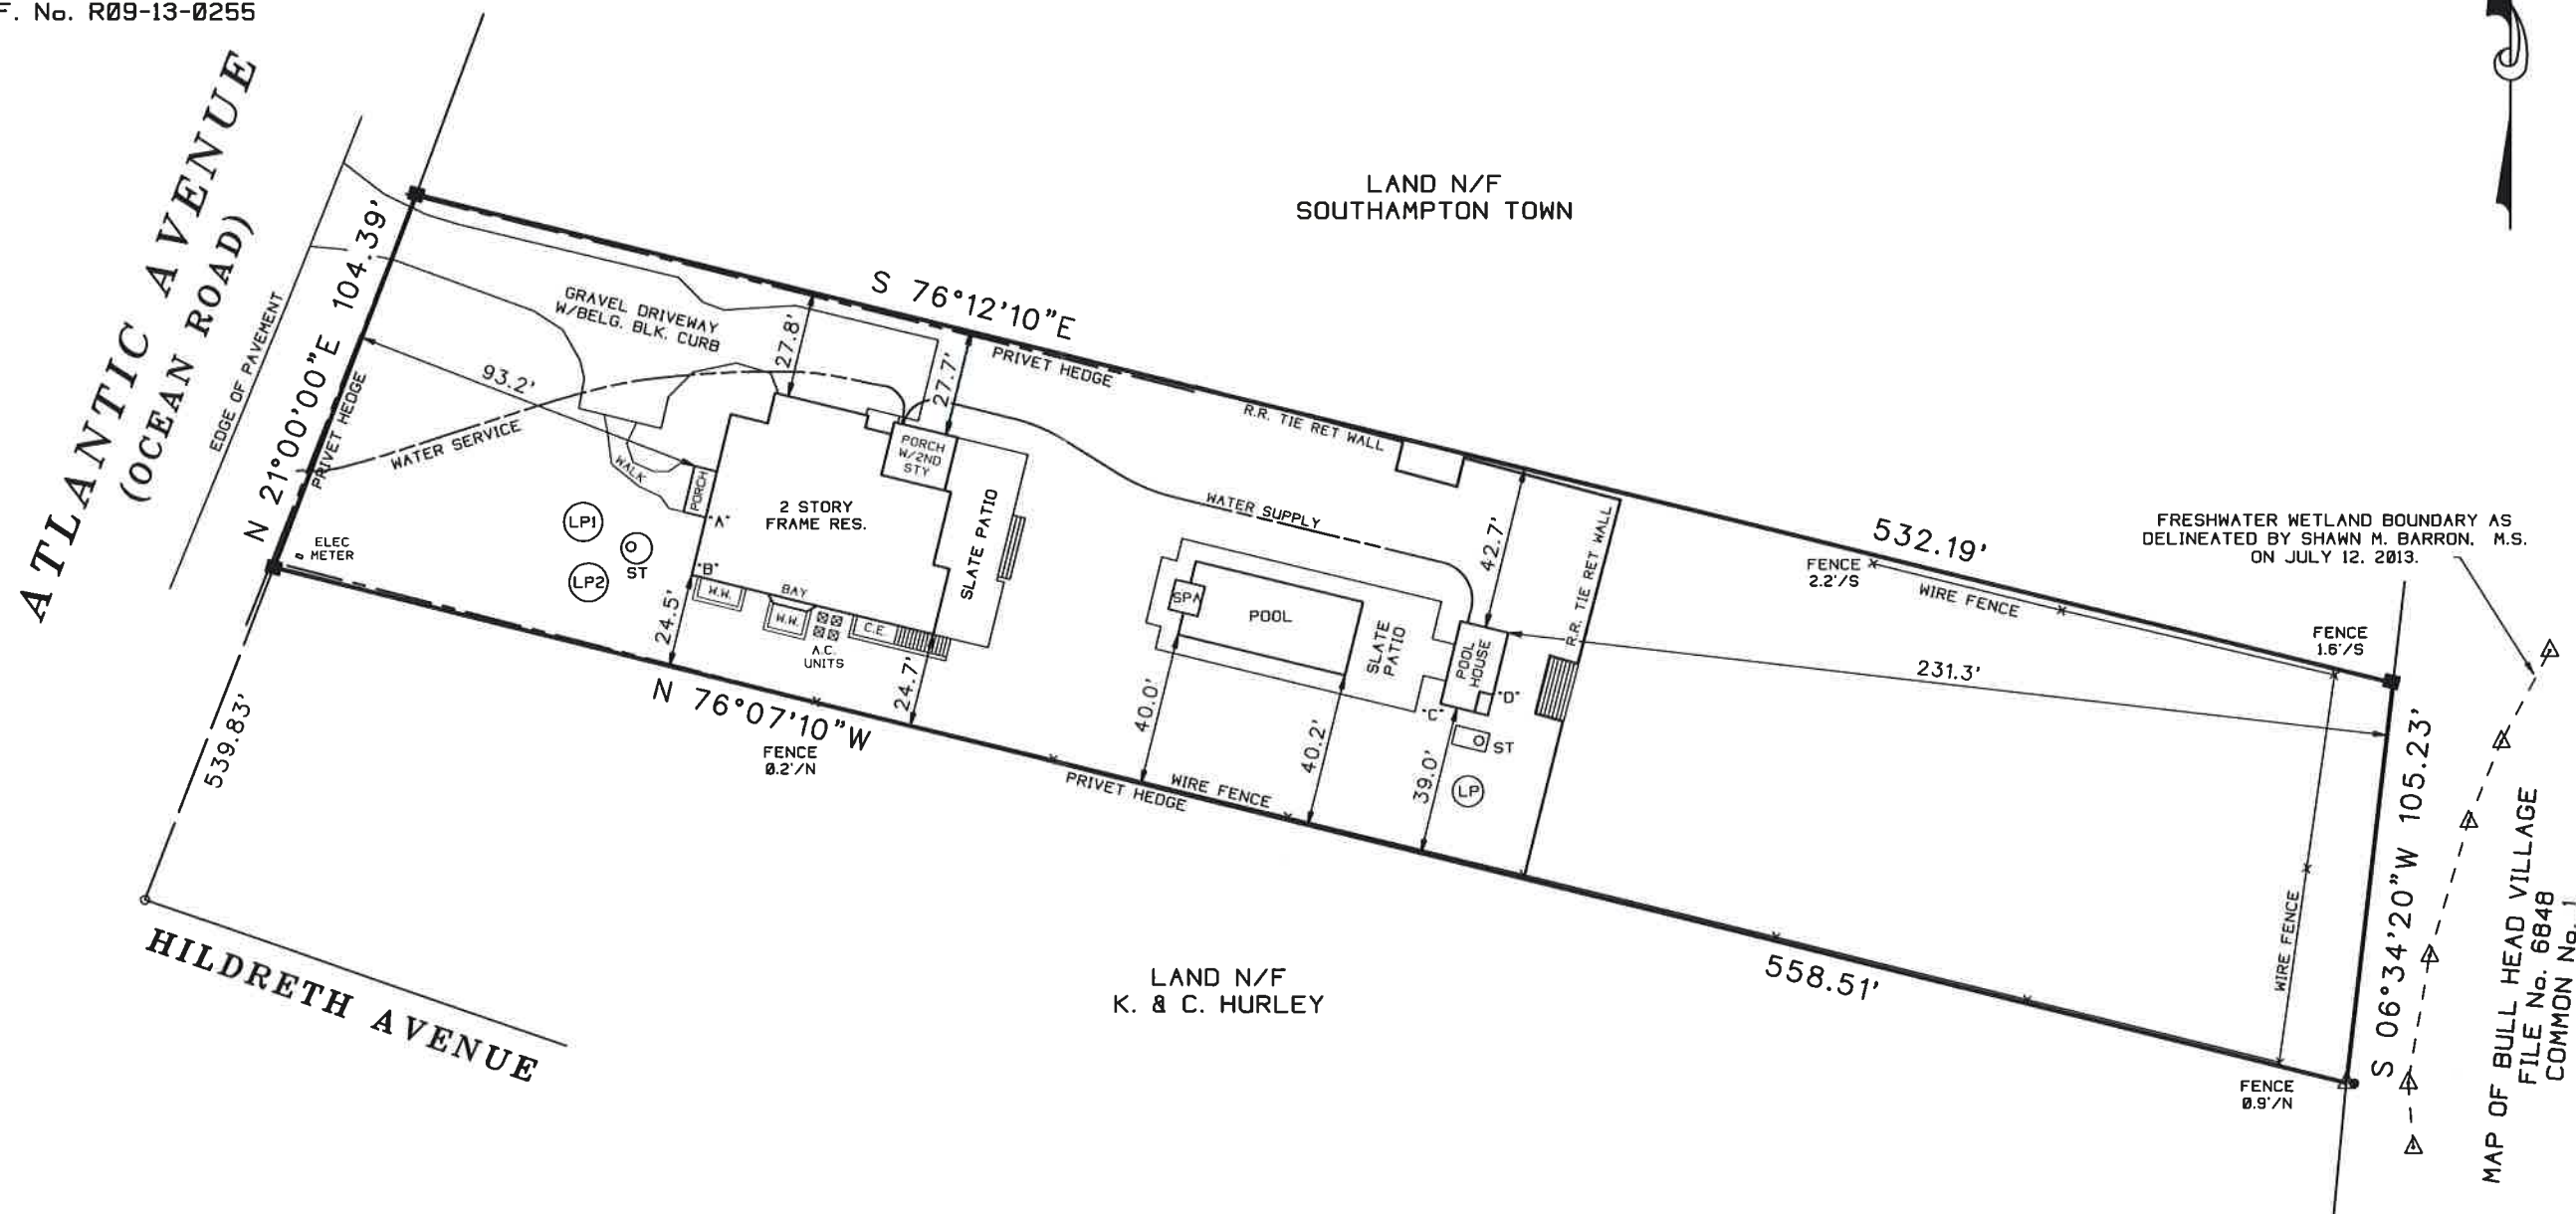

PHONE: 631-283-4525 FAX: 631-283-4784  
STEVEN@SBLSPC.COM