
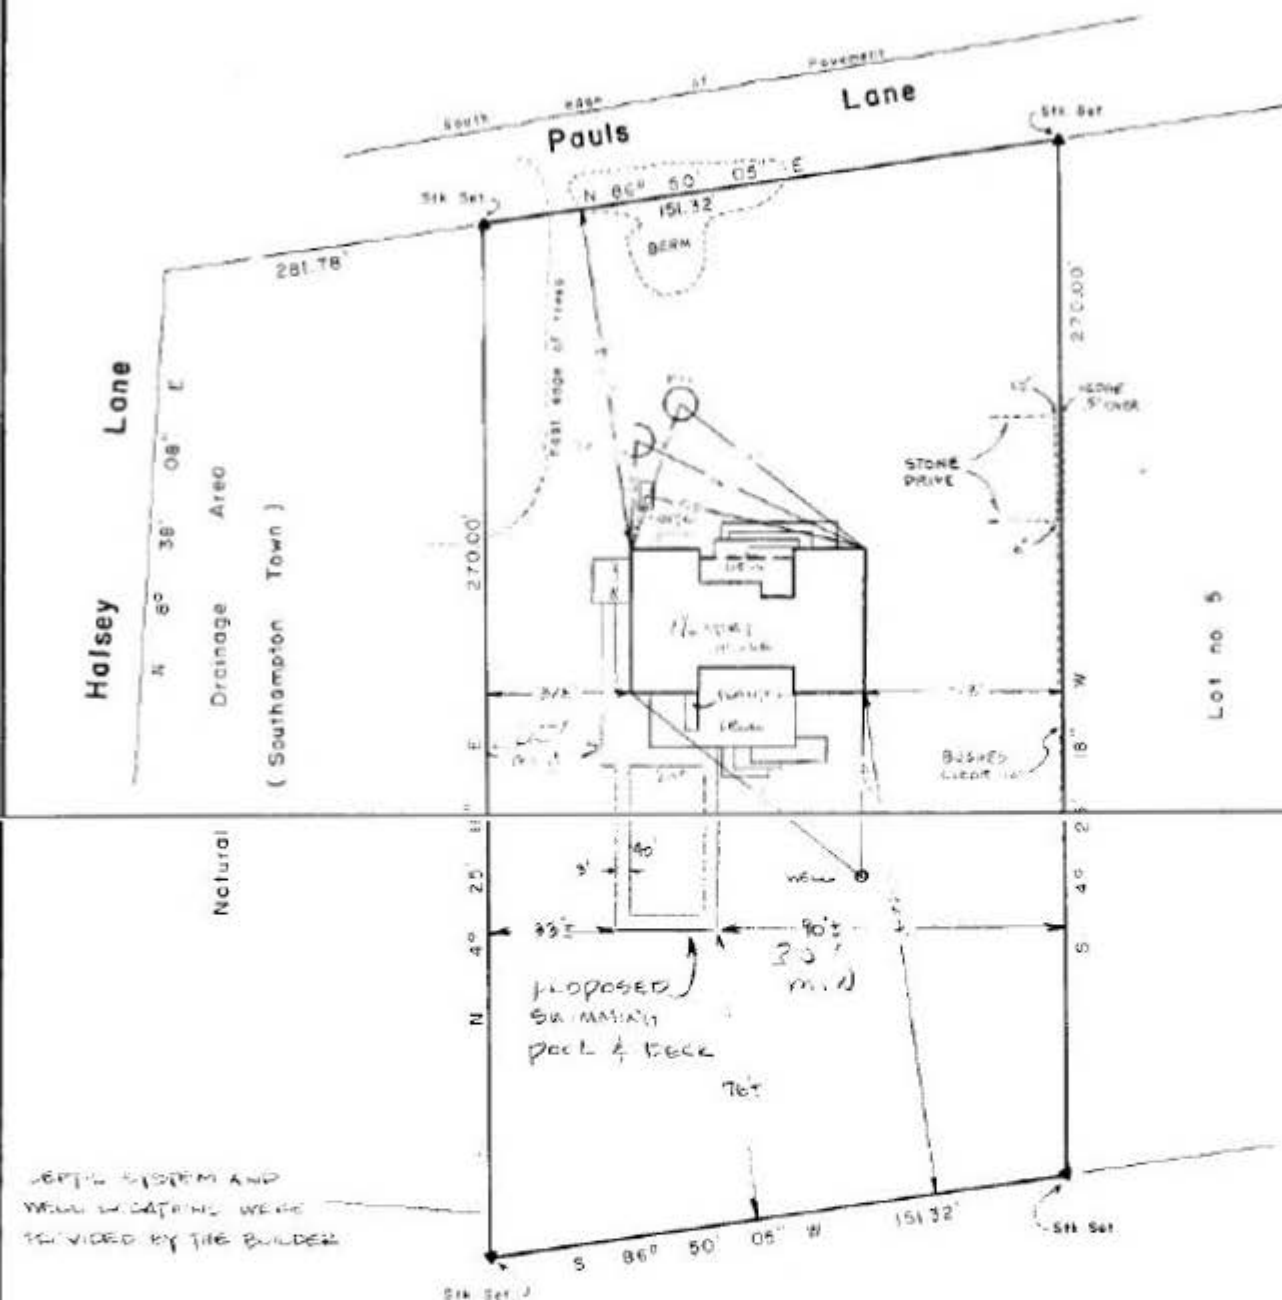


Guaranteed to:

John C. Ringgold

Title Guarantee Company

Eastern Federal Savings & Loan Association
of Sayville in accordance with the minimum
standards for surveys of the New York State
Association of Professional Land Surveyors.

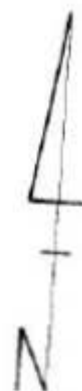

010678

MAP OF LOT NO. 6
SUBDIVISION MAP OF
BROADLANDS

SITUATE

BRIDGEHAMPTON
TOWN OF SOUTHAMPTON
SUFFOLK COUNTY, N.Y.

SCALE 1" = 40'

Lot Area : 40,498 S.F.
Tax Map No : 900 - 105 - 01 - 1.6

REVISED: APRIL 23, 1982 TO SHOW PROP. POOL.

SURVEYED: DEC. 7, 1981

SURVEYED: SEPT. 2, 1981



John J. Raynor, P.E.
CIVIL ENGINEER
Water Mill, N.Y. 11976

John J. Raynor