


3612-2x

MAIN ROAD

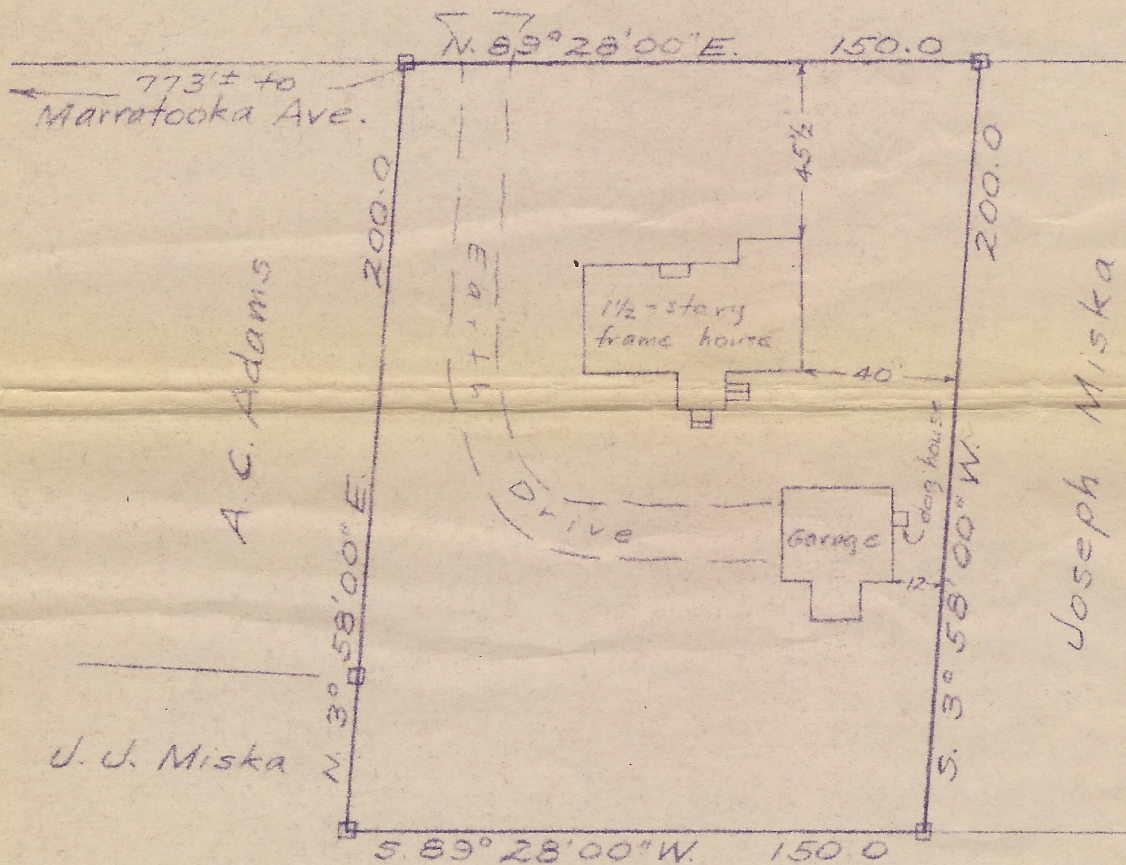

John J. Miska

MAP OF PROPERTY
SURVEYED FOR
ERNEST W. AND ELSIE M. JONES
AT
MATTITUCK, N.Y.

Scale 50' = 1"
□ = monument

Guaranteed to the Security Title and
Guaranty Company and to the North
Fork Bank and Trust Company as
surveyed February 3, 1969.

Van Tuyl and Son
R. Van Tuyl

Licensed Land Surveyors
Greenport, New York.