


SURVEY OF:
PROPERTY LOCATED AT EAST MORICHES
TOWN OF BROOKHAVEN
SUFFOLK COUNTY, NEW YORK
S.C.T.M. # 200-946-3-28
AREA = 161,308.5 SF. = 3.70 ACRES
SCALE: 1"=60'

NOTE: THE EXISTENCE OF RIGHT OF WAYS,
WETLANDS AND/OR EASEMENTS OF RECORD
IF ANY, NOT SHOWN ARE NOT GUARANTEED.

ELEVATIONS REFER TO 1988 NAVD

ELEVATIONS SHOWN THUS $\times^{xx}$

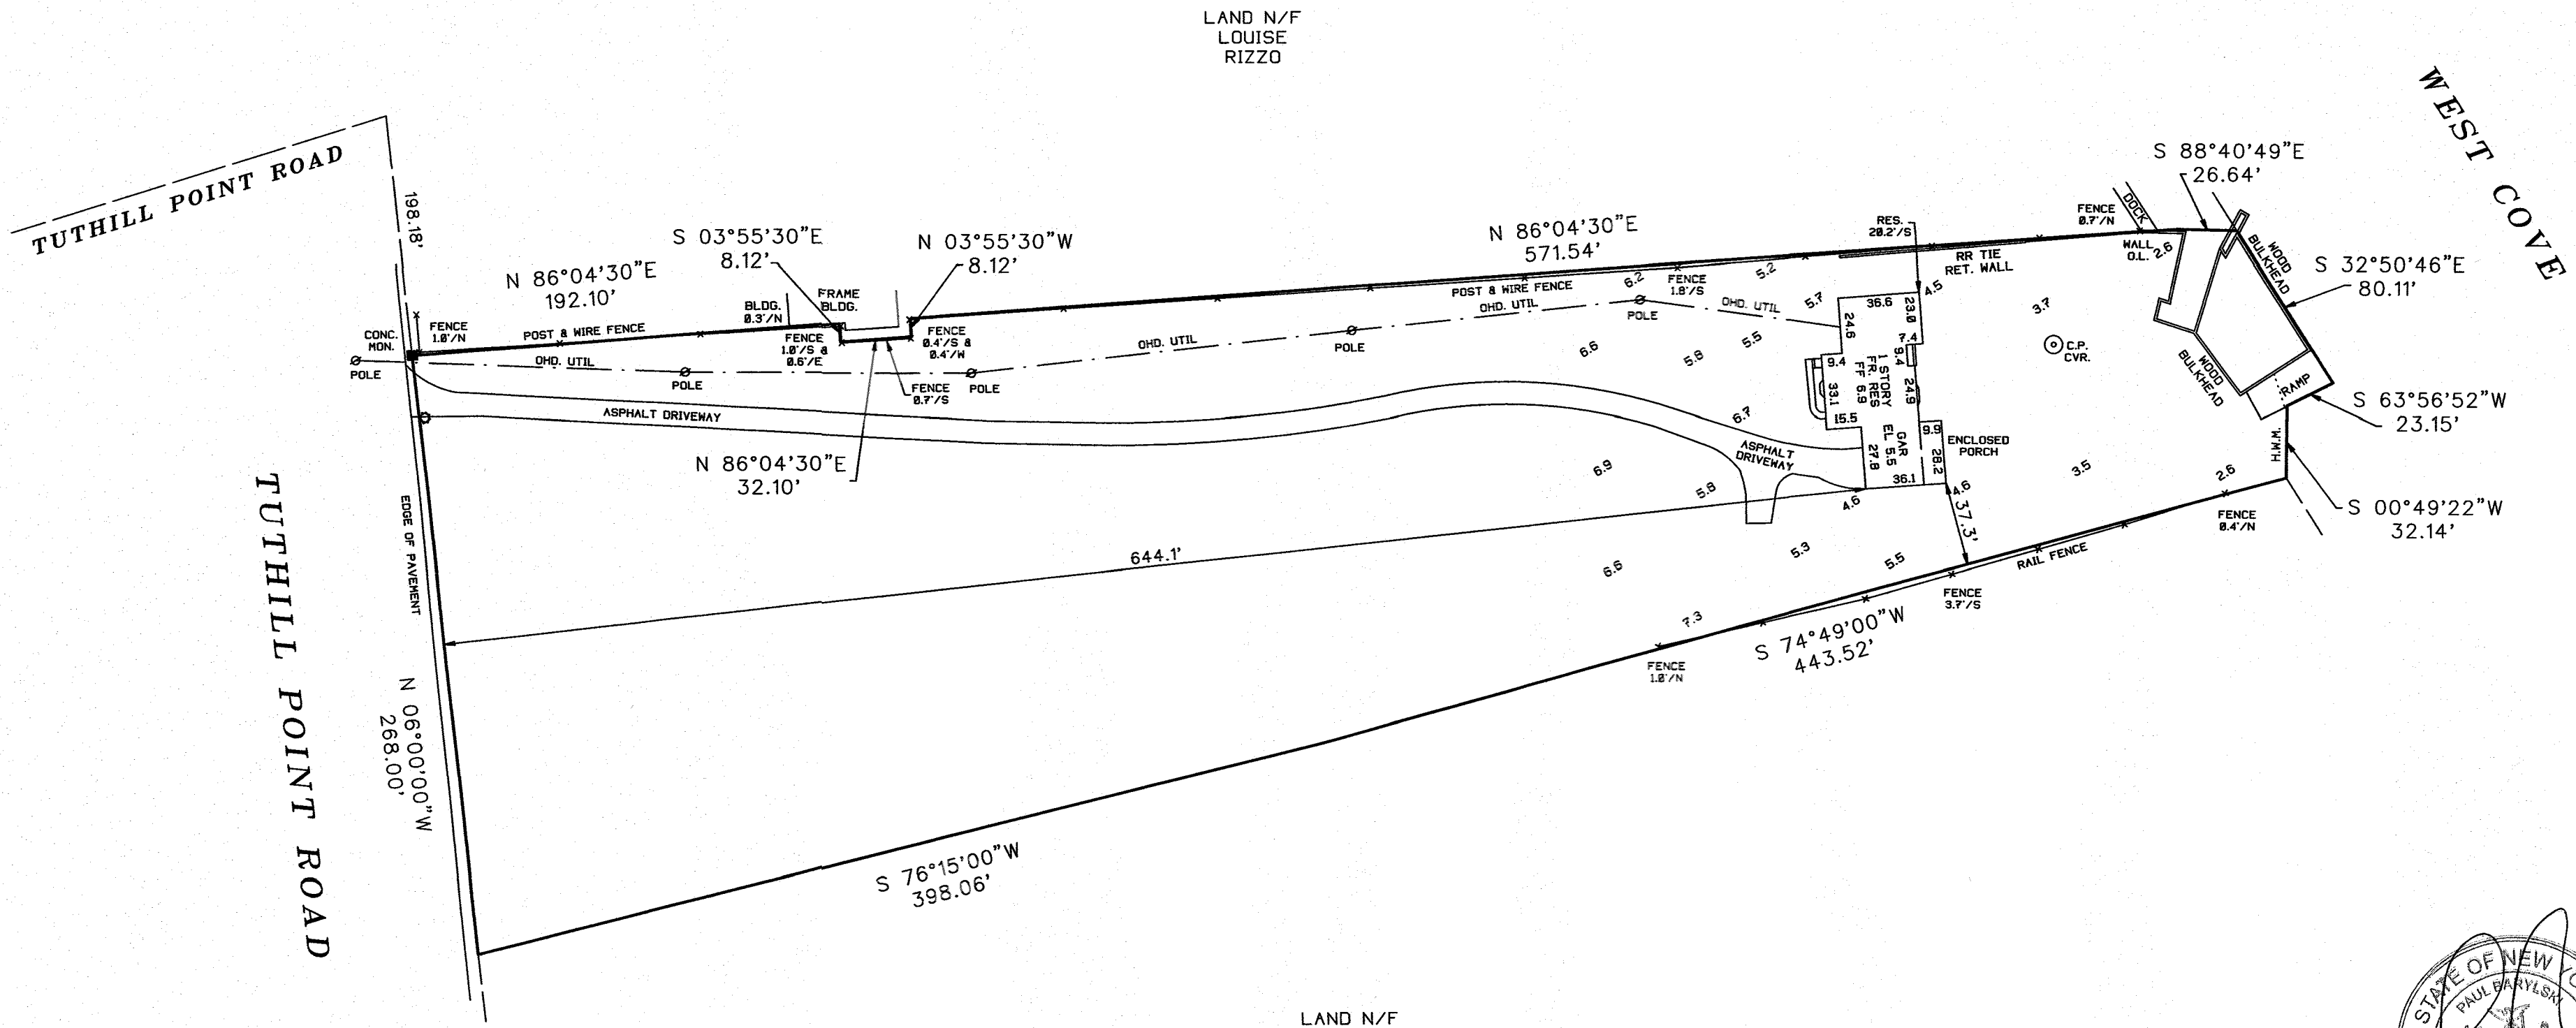

UNAUTHORIZED ALTERATION OR ADDITION TO THIS SURVEY IS A VIOLATION
OF SECTION 7209 OF THE NEW YORK STATE EDUCATION LAW.
COPIES OF THIS SURVEY MAP NOT BEARING THE LAND SURVEYORS INKED
OR EMBOSSED SEAL SHALL NOT BE CONSIDERED TO BE A VALID TRUE COPY.
GUARANTEES OR CERTIFICATIONS INDICATED HEREON SHALL RUN ONLY TO
THE PERSON FOR WHOM THE SURVEY IS PREPARED, AND ON HIS BEHALF TO
THE TITLE COMPANY, GOVERNMENTAL AGENCY AND LENDING INSTITUTION
LISTED HEREON, AND TO THE ASSIGNEES OF THE LENDING INSTITUTION.
GUARANTEES OR CERTIFICATIONS ARE NOT TRANSFERABLE TO ADDITIONAL
INSTITUTIONS OR SUBSEQUENT OWNERS.

SURVEYED BY:
PAUL BARYLSKI LAND SURVEYING
PATCHOGUE NY 11772
PHONE 631-294-6985
FAX 631-627-3186
PAULBARYLSKI@YAHOO.COM
APRIL 27, 2021