


Survey for:
NICHOLAS AMADORI
 Lot 1, "Eastfield"
 At
 Water Mill
 Town of
 Southampton
 Suffolk County, New York

S.C.T.M.: 0900-113.00-03.00-018.007

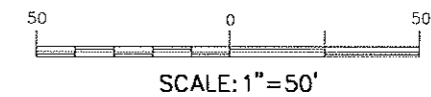

NOTES:

1. AREA = 60,215 S.F.
2. ■ = MONUMENT FOUND, ▲ = STAKE FOUND.
 △ = STAKE SET, ○ = SPIKE SET.
3. SUBDIVISION MAP "EASTFIELD" FILED
 IN THE OFFICE OF THE CLERK OF SUFFOLK
 COUNTY ON NOV. 26, 1985 AS FILE NO. 8013.

MAY 09, 2007 FINAL SURVEY
 SEPT. 18, 2006 SET STAKES & UPDATE
 DATE: DEC. 14, 2005
 JOB NO: 2005-925

CERTIFIED TO:
 NICHOLAS AMADORI

DAVID H. FOX, L.S. P.C. N.Y.S.L.S. #50234
FOX LAND SURVEYING
 64 SUNSET AVENUE
 WESTHAMPTON BEACH, N.Y. 11978
 (631) 288-0022

UNAUTHORIZED ALTERATION OR ADDITION TO THIS SURVEY
 IS A VIOLATION OF SECTION 7209 OF THE NEW YORK STATE
 EDUCATION LAW. COPIES OF THIS SURVEY MAP NOT BEARING
 THE LAND SURVEYOR'S INKED SEAL OR EMBOSSED SEAL
 SHALL NOT BE CONSIDERED TO BE A VALID TRUE COPY.

CERTIFICATION INDICATED HEREON SHALL RUN ONLY TO THE
 PERSON FOR WHOM THE SURVEY IS PREPARED AND ON HIS
 BEHALF TO THE TITLE COMPANY, GOVERNMENTAL AGENCY
 AND LENDING INSTITUTION LISTED HEREON, AND TO THE
 ASSIGNEES OF THE LENDING INSTITUTION. CERTIFICATIONS
 ARE NOT TRANSFERABLE TO ADDITIONAL INSTITUTIONS
 OR SUBSEQUENT OWNERS.

