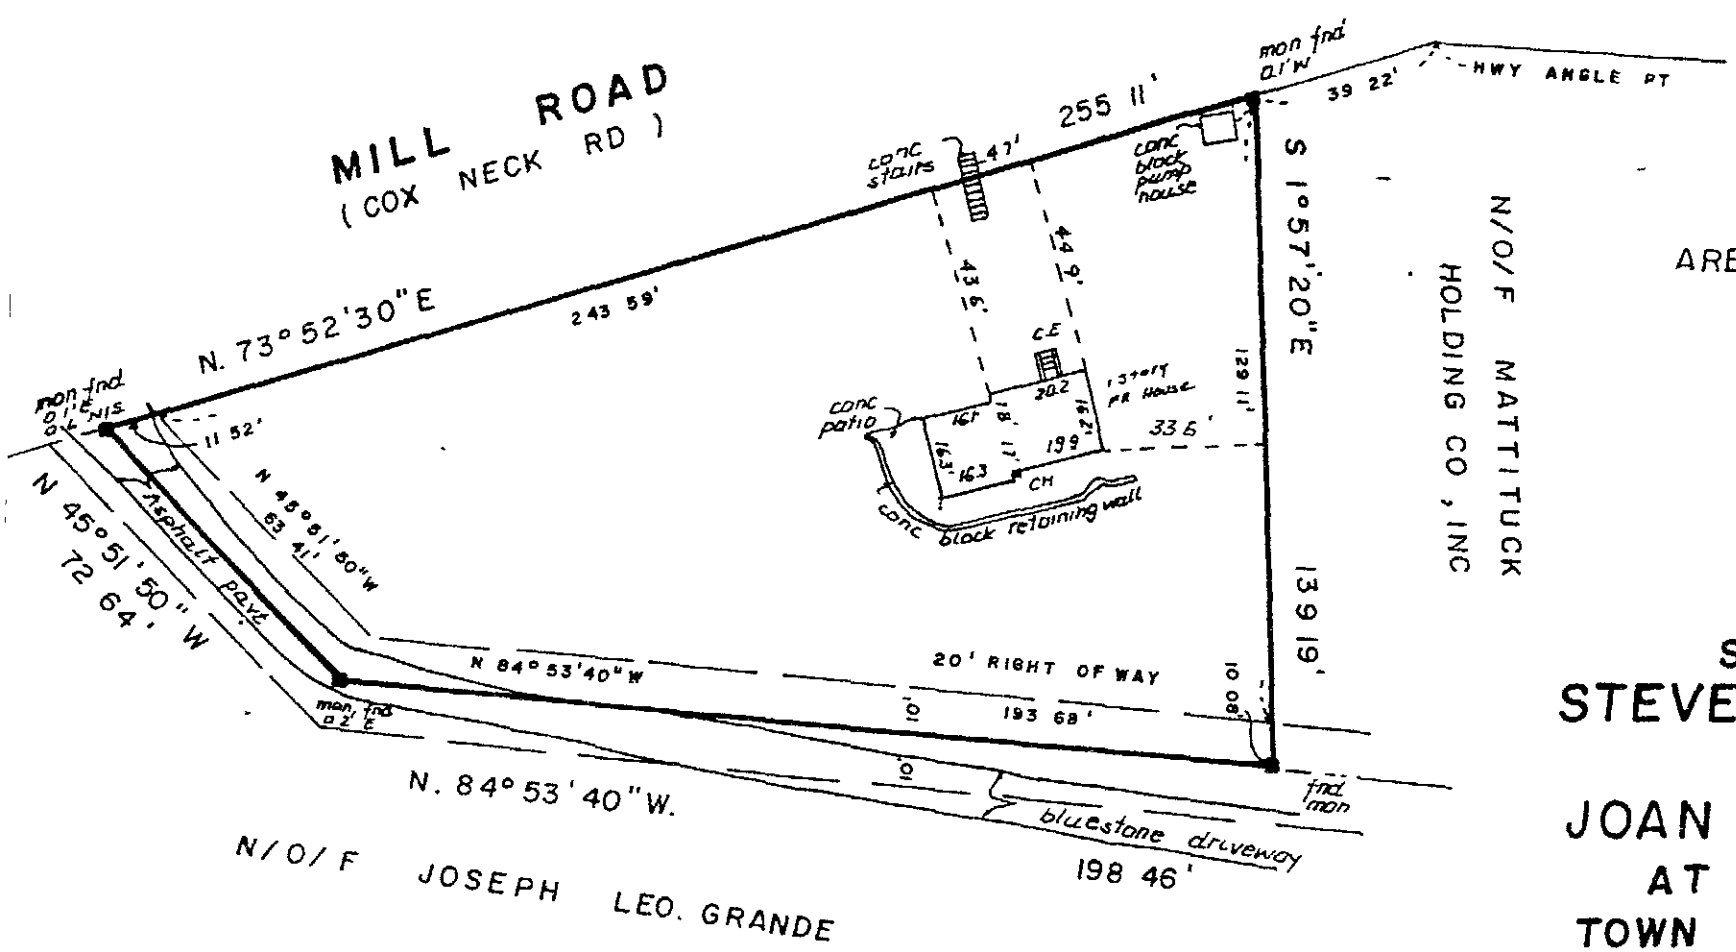


SURVEY
STEVEN SAM
&
JOAN FETHE
AT MATTITU
TOWN OF SOU
SUFFOLK COUNT
1000 - 106 - 06
SCALE 1" = 4
OCT 20, 198

CERTIFIED TO
FIRST AMERICAN TITLE INSURANCE
COMPANY OF NEW YORK.
TITLE NO. 632 S 0505
STEVEN SAMBUCCI
JOAN FETHERSTON

AND SURVEYOR
A, INGEGNO
NEW YORK
49668

.Y S LIC. NO. 49668

VEYORS & ENGINEERS, P.C.
5020
909
AD
O, N Y 11971

Prepared in accordance with the min
standards for the surveys as establish
the L.S.A.E.S. and approved and ad
for such use by The New York State
Title Association.

86 - 588