


DISTRICT 0904
SECTION 008.00
BLOCK 02.00
PARCELS 094.000
& 095.000

HALSEY AVENUE

DAVID WHITES LANE

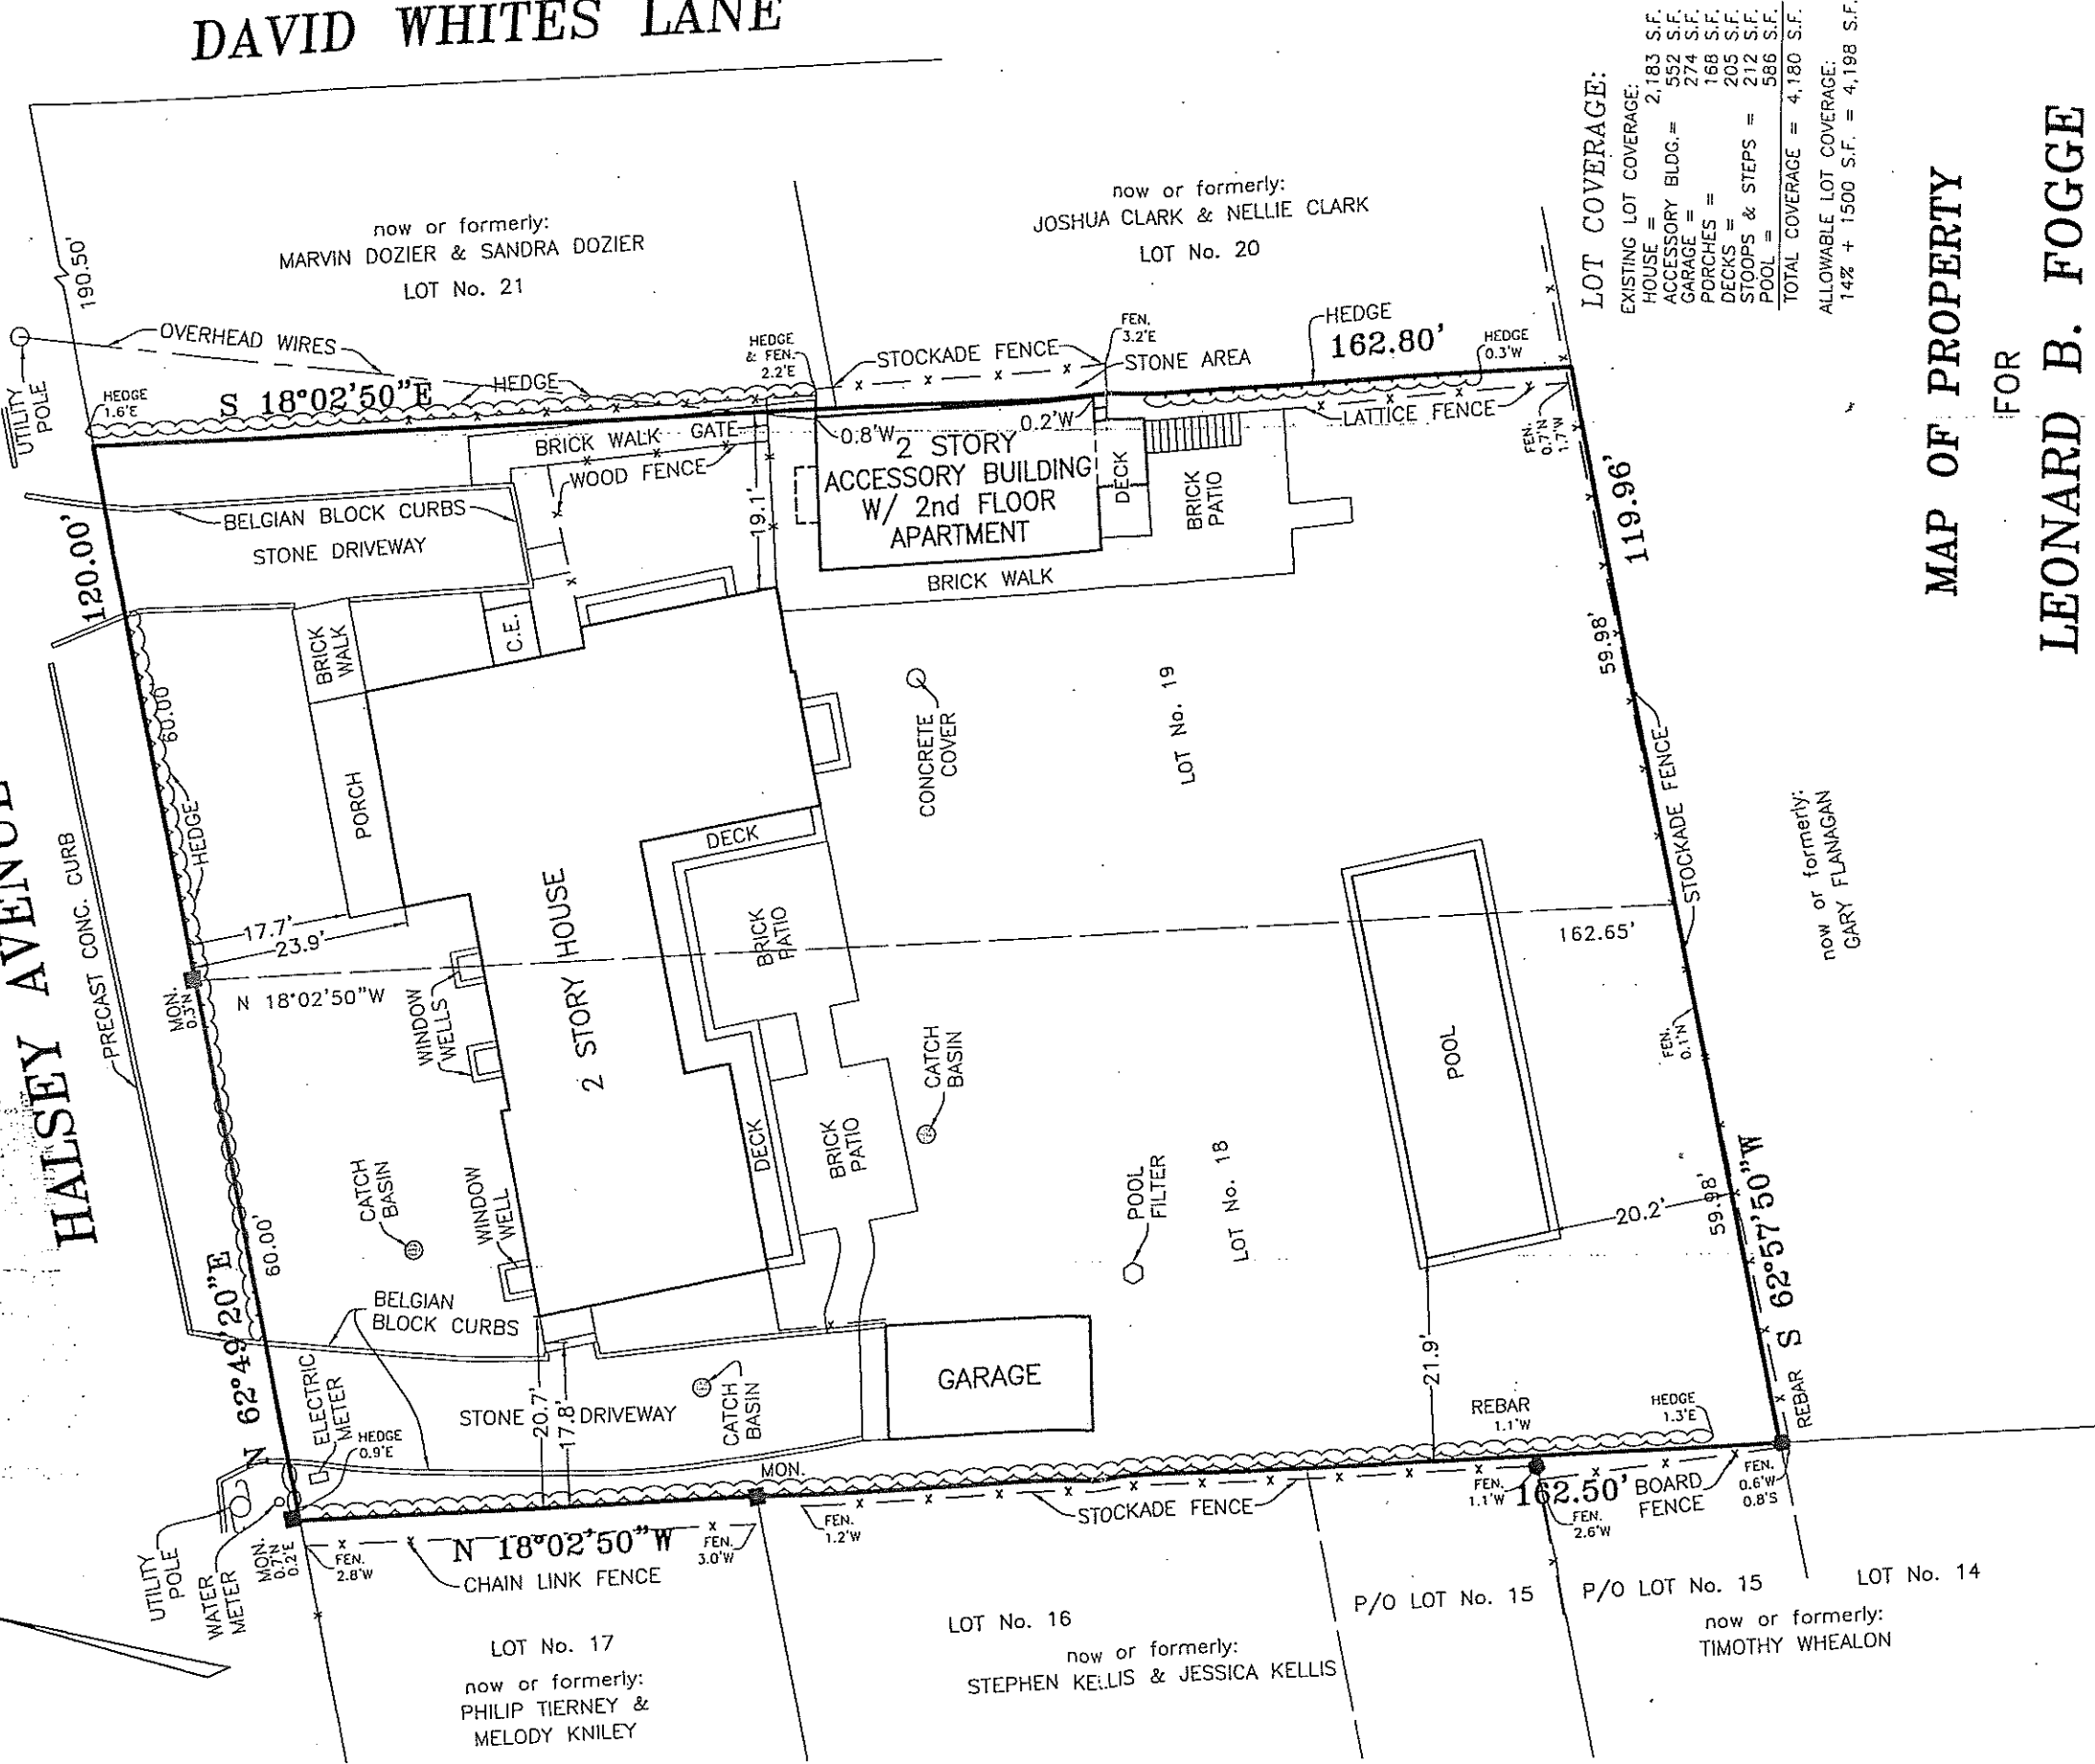

LOT COVERAGE:
EXISTING LOT COVERAGE:
HOUSE = 2,183 S.F.
ACCESSORY BLDG. = 552 S.F.
GARAGE = 274 S.F.
PORCHES = 168 S.F.
DECKS = 205 S.F.
STOOPS & STEPS = 212 S.F.
POOL = 586 S.F.
TOTAL COVERAGE = 4,180 S.F.
ALLOWABLE LOT COVERAGE:
14% + 1500 S.F. = 4,198 S.F.

now or formerly:
GARY FLANAGAN

MAP OF PROPERTY

FOR

LEONARD B. FOGGE

SITUATE


INC. VILLAGE OF SOUTHAMPTON

TOWN OF SOUTHAMPTON

SUFFOLK COUNTY, NEW YORK

TOTAL AREA = 19,271 S.F. (0.442 ACRE)

SCALE: 1" = 20'

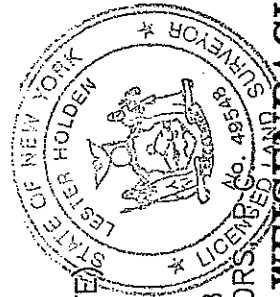

REVISED: JULY 21, 2010. (UPDATED)
SURVEYED: JUNE 6, 2005

Lester Holden
LESTER HOLDEN, L.S. No. 49548
S. H. W. AND S., LAND SURVEYORS

SQUIRES, HOLDEN, WEISENBACHER & SMITH
LAND SURVEYING ~ LAND PLANNING ~ ENGINEERING
SOUTHAMPTON ~ NEW YORK