


DISTRICT	0904
SECTION	028.00
BLOCK	01.00
PARCEL	009.000

SOUTH MAIN STREET

GIN LANE

30' WIDE PRIVATE ROAD

30' WIDE PRIVATE ROAD

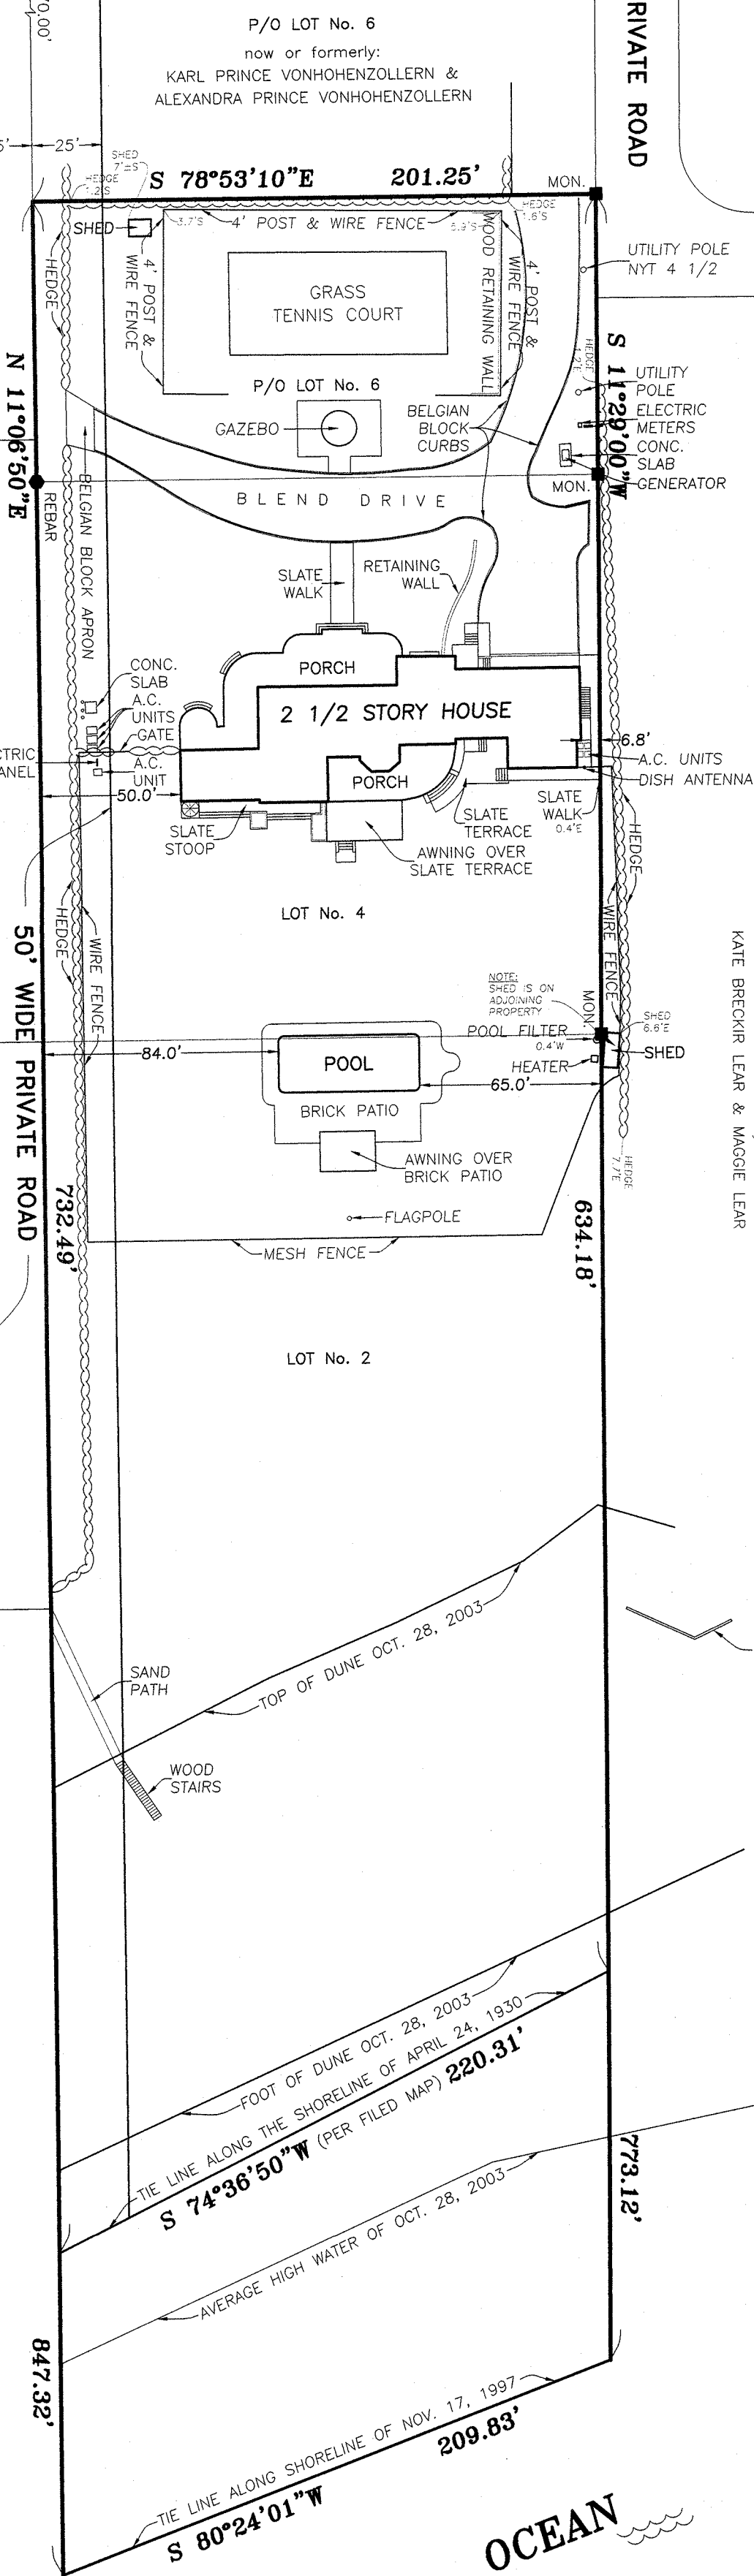

MAP OF LOT No. 6,
LOT No. 4 & LOT No. 2
SUBDIVISION MAP OF

FAIR LEA

MAP No. 579 FILED: APRIL 24, 1930

FOR

GEORGE R. & PATRICIA C.
KRAUS

SITUATE

INC. VILLAGE OF SOUTHAMPTON

TOWN OF SOUTHAMPTON

SUFFOLK COUNTY, NEW YORK

AREA = 160,944 S.F.
(3.695 ACRES)
(TO TIE LINE)

SCALE: 1" = 50'

KARL W. WEISENBACHER, L.S. No. 36195
S. H. W. & S. LAND SURVEYORS P.C.

SQUIRES, HOLDEN, WEISENBACHER & SMITH

LAND SURVEYORS ~ ENGINEERS
SOUTHAMPTON ~ NEW YORK