
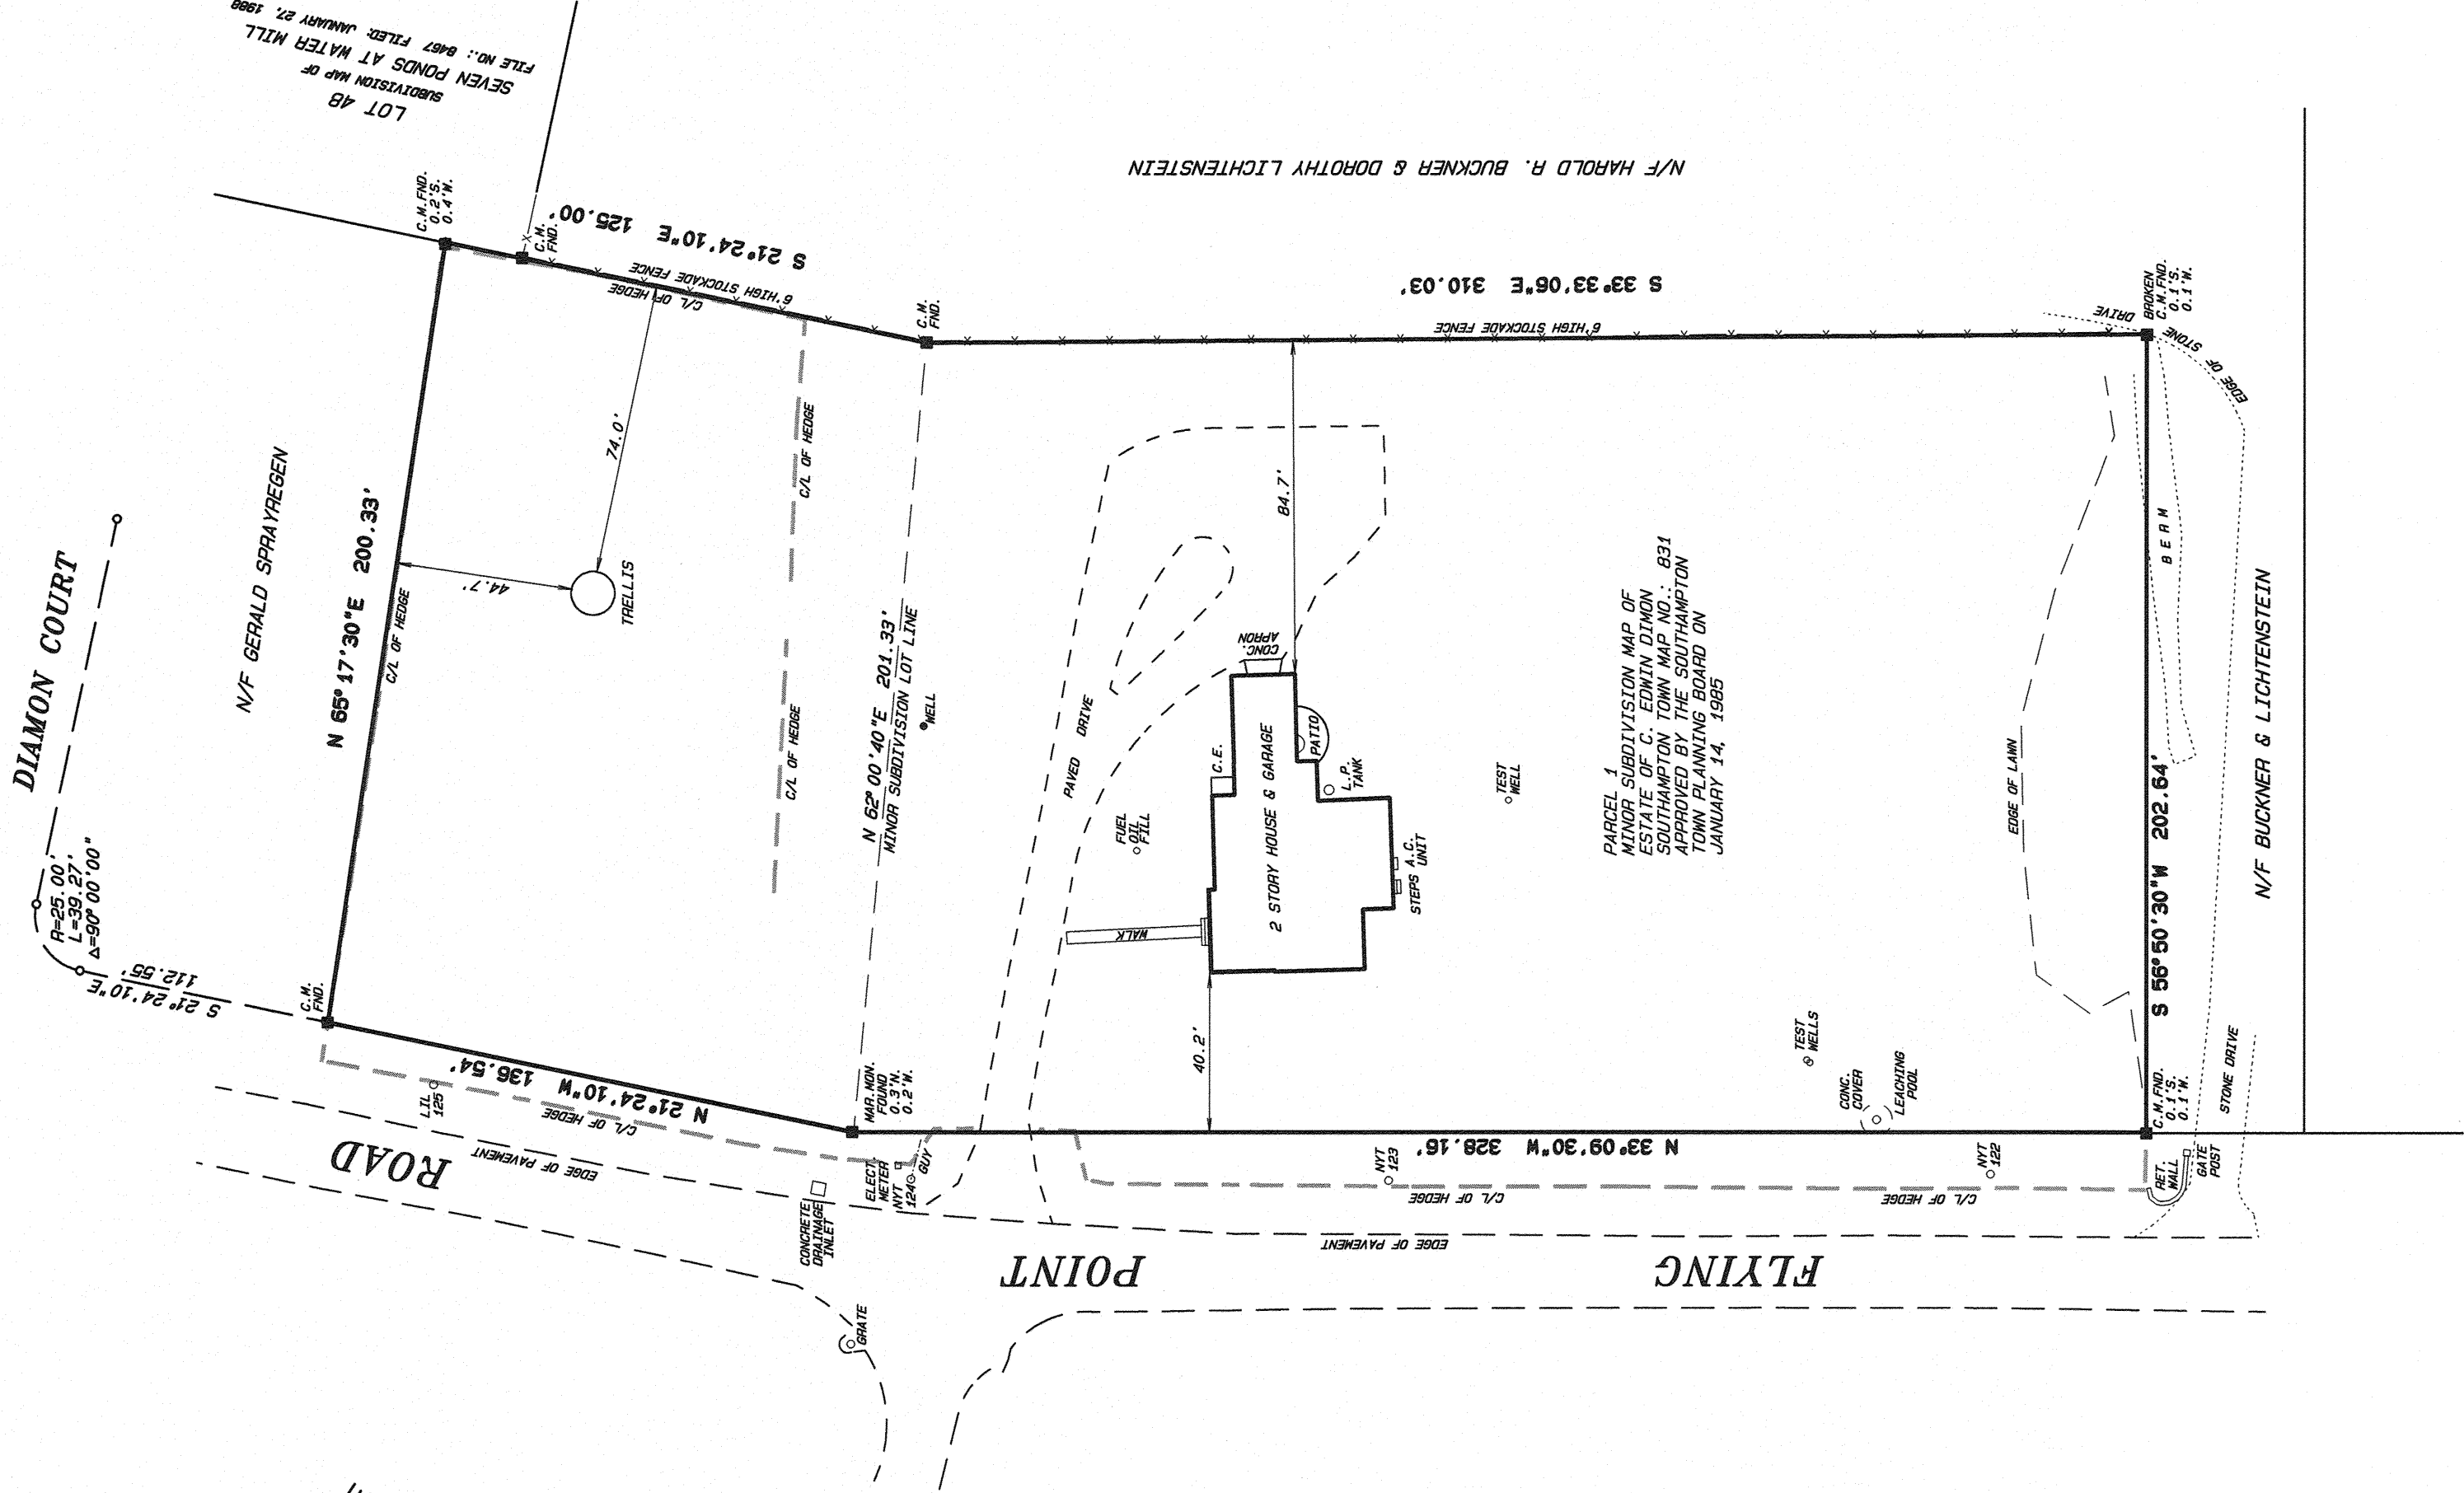


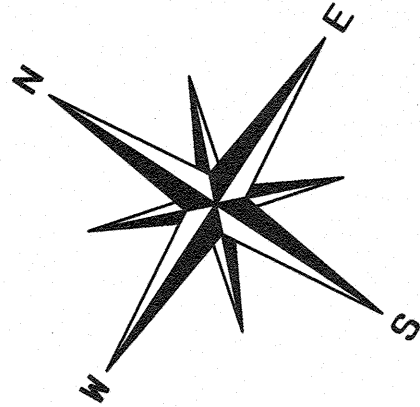

UNAUTHORIZED ALTERATION OR ADDITION TO A SURVEY MAP
BEARING A LICENSED LAND SURVEYOR'S SEAL IS A VIOLATION
OF SECTION 7203, SUBDIVISION 2, OF THE NEW YORK STATE
EDUCATION LAW.

ONLY COPIES FROM THE ORIGINAL OF THIS SURVEY MARKED
WITH AN ORIGINAL OF THE LAND SURVEYOR'S EMBOSSED SEAL OR
IMAGED SEAL SHALL BE CONSIDERED TO BE VALID TRUE COPIES.

CERTIFICATIONS INDICATED HEREON SIGNIFY THAT THIS SURVEY
WAS PREPARED IN ACCORDANCE WITH THE EXISTING CODE OF
PRACTICE FOR LAND SURVEYS ADOPTED BY THE NEW YORK
LEGISLATURE. THE SURVEYOR'S SIGNATURE AND SEAL ARE REQUIRED
ON ALL CERTIFICATIONS. THE SURVEYOR'S SIGNATURE AND SEAL
CERTIFICATIONS SHALL RUN TO THE PERSON FOR WHOM THE
SURVEY IS PREPARED, AND ON HIS BEHALF TO THE TITLE COMPANY,
GOVERNMENTAL AGENCY AND LENDING INSTITUTION LISTED HEREON.
THE SURVEYOR'S SIGNATURE AND SEAL ARE REQUIRED ON ALL
OR SUCCESSOR OWNERS. CERTIFICATIONS RUN ONLY TO THE LAST
FIELD SURVEY DATE.

NO CERTIFICATION IS MADE AS TO THE EXISTENCE OR
NON-EXISTENCE OF EASEMENTS OR RIGHTS-OF-WAY AFFECTING
THIS PROPERTY. THE LOCATIONS OF EASEMENTS OR RIGHTS-OF-WAY
OF RECORD ARE SHOWN HEREON ONLY IF COPIES OF THE
INSTRUMENTS ARE PROVIDED TO THE SURVEYOR.

SURVEYED: JANUARY 20, 2017

NOTES:
REFERENCE DEED FOR THIS PROPERTY IS
LIBER 12353 AT PAGE 684 RECORDED
IN THE OFFICE OF THE SUFFOLK COUNTY
CLERK ON JANUARY 4, 2005.
A PORTION OF THE SURVEY PROPERTY IS
SHOWN AS PARCEL 1 ON THE MINOR
SUBDIVISION MAP OF ESTATE OF C. EDWIN
DIMON, SOUTHAMPTON TOWN MAP NUMBER

	THE RAYNOR GROUP, P.E. & L.S. PLLC	
	SURVEYORS	CIVIL ENGINEERS
	DEERFIELD GREEN WATER MILL, N.Y. 11976	SITE PLANNERS
	P.O. BOX 720 (631) 756-7600	

MICHAEL J. RAYNOR
LAND SURVEYOR NO. 43778

STREET ADDRESS FROM TOWN
OF SOUTHAMPTON 6.I.S.:
14 FLYING POINT ROAD

© 2017 THE RAYNOR GROUP, P.E. & L.S. PLLC
UNAUTHORIZED REPRODUCTION IS PROHIBITED. ALL RIGHTS RESERVED.

MAP OF SURVEY
PREPARED FOR
**ARNOLD R. &
ANITA L. DORMER**
SITUATE
**NEAR INC. VILLAGE
OF SOUTHAMPTON**
TOWN OF SOUTHAMPTON
SUFFOLK COUNTY, N.Y.
SCALE: 1" = 40'
AREA = 2.0768 ACRES
TAX MAP NO.: 0900-132.00-04.00-022.001
xP* Survey Map - 9[0.12]PF: 327701 511 31-Mar-17 04:05 PM / 3277-1