

MAP OF LOTS 110, 111 & 112
SUBDIVISION MAP OF
BAY VIEW OAKS
MAP N° 1594 ~ FILED: DEC. 12, 1947


for
DEWEY C. & MATHILDA R. LAPLANTE
situate

NORTH SEA
TOWN of SOUTHAMPTON
SUFFOLK COUNTY, N.Y.

0.537 ACRE
(23,400 SQ. FT.)

SCALE: 1" = 40'

SUFFOLK COUNTY TAX MAP.
DISTRICT: 0900
SECTION: 031.00
BLOCK: 03.00
PARCEL: 022.000 +
024.000

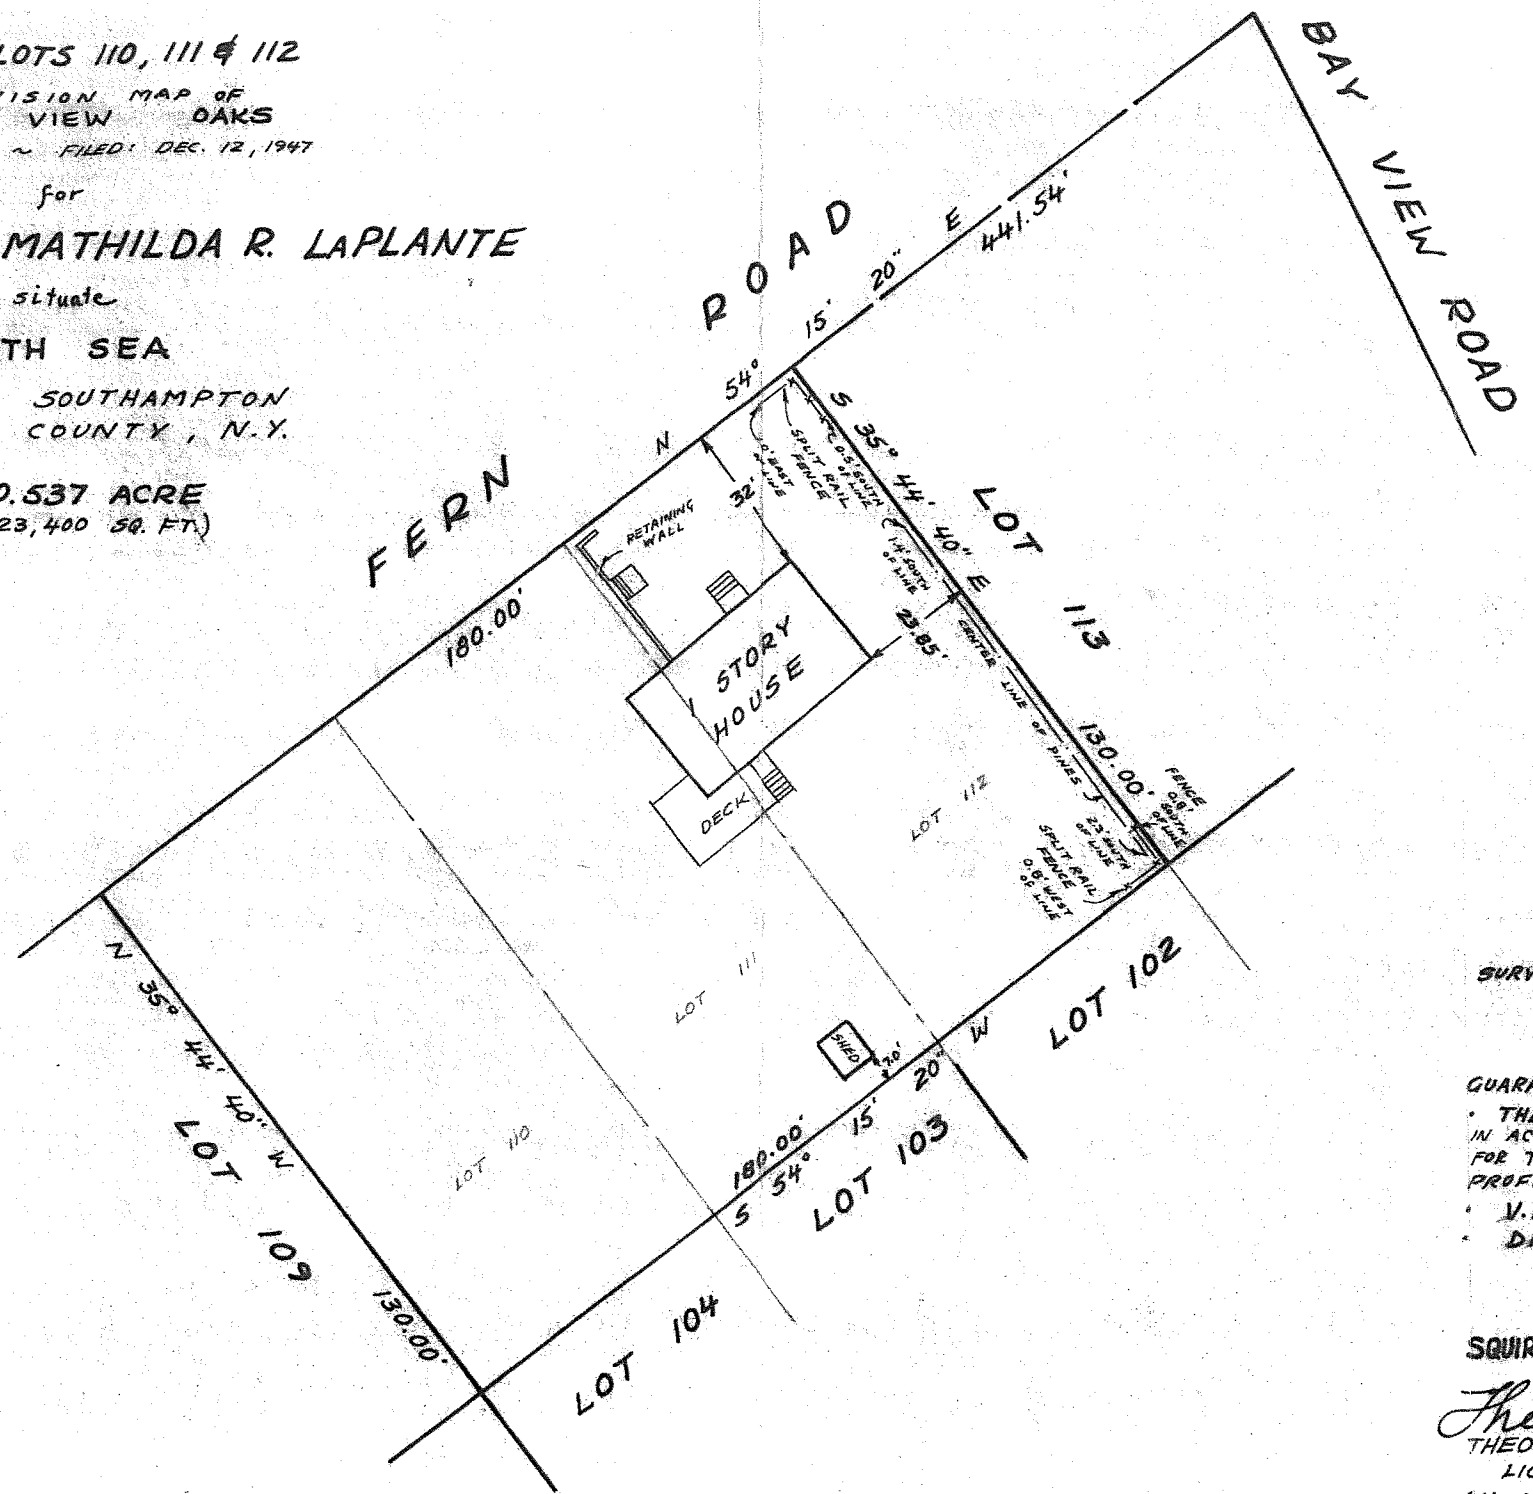

SURVEYED: APR. 2, 1979

GUARANTEED TO:
• THE TITLE GUARANTEE CO.
IN ACCORDANCE WITH THE MINIMUM STANDARDS
FOR TITLE SURVEYS OF THE N.Y. STATE ASSOC. OF
PROFESSIONAL LAND SURVEYORS.
• V.A. ADMINISTRATION
• DIME SAVINGS BANK

SQUIRES, HOLDEN & WEISENBACHER
Theodore F. Squires
THEODORE F. SQUIRES
LICENSED SURVEYOR N° 15683
24 NORTH MAIN ST. SOUTHAMPTON, N.Y.