SURVEY OF
LOT 169
MAP OF
WIGGINS' ESTATE
FILE No. 534 FILED IN 1853
SITUATE
THE INCORPORATED VILLAG
GREENPORT
TOWN OF SOUTHOLD
SUFFOLK COUNTY, NEW YO
S.C. TAX No. 1001-06-05-
SCALE 1"=20'
OCTOBER 19, 2010
AREA = 8,641 sq. ft.
0.198 ac.

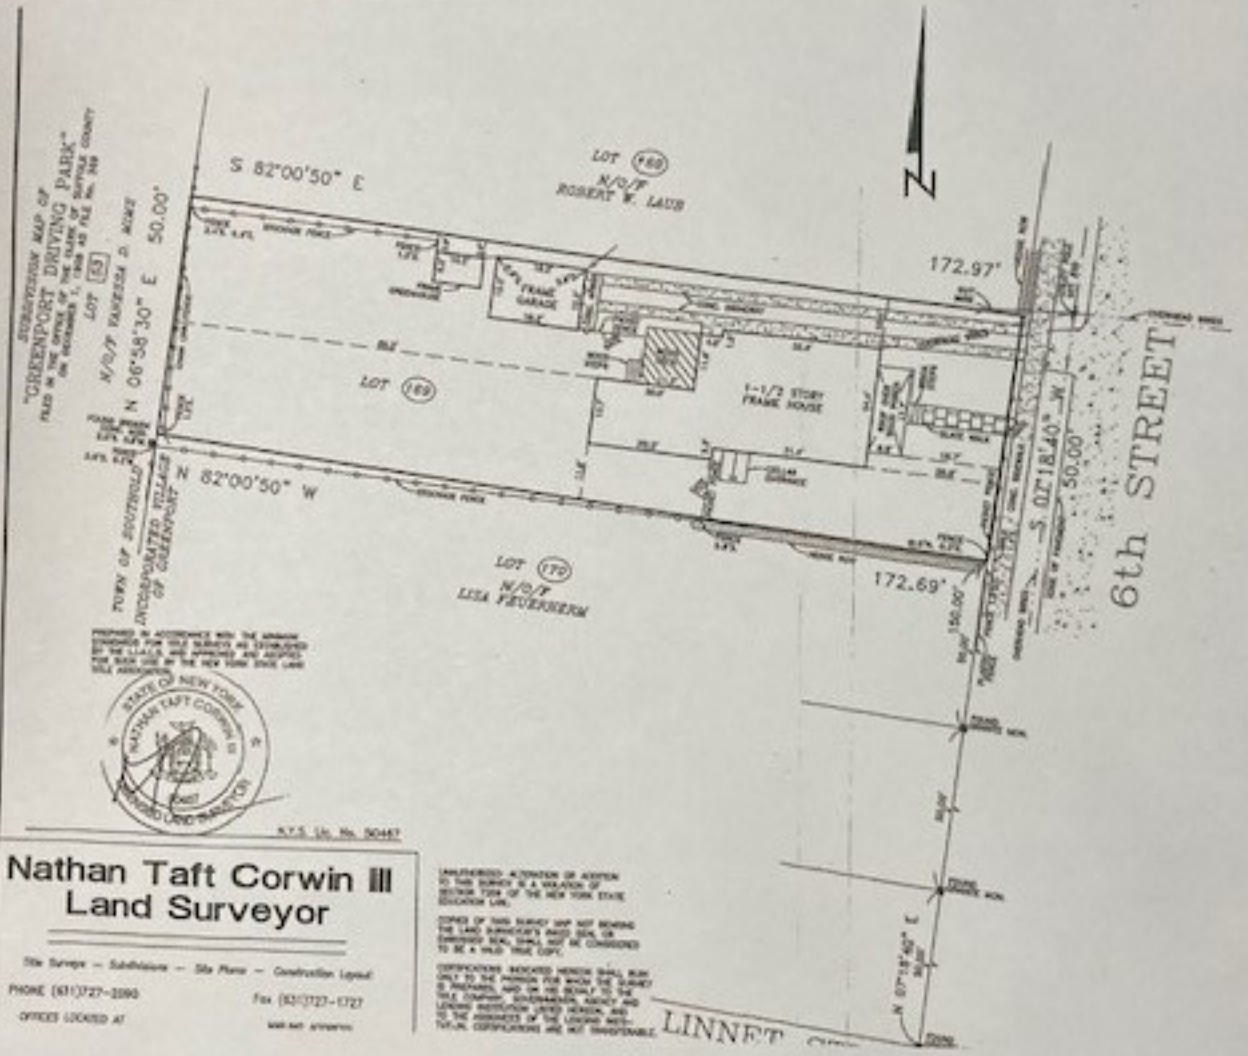

PREPARED IN ACCORDANCE WITH THE MINIMUM STANDARDS FOR TITLE SURVEYS AS ESTABLISHED BY THE L.I.A.S. AND APPROVED AND ADOPTED FOR SUCH USE BY THE NEW YORK STATE LAND SURVEYORS ASSOCIATION

STATE OF NEW YORK
NATHAN TAFT CORWIN III
LICENSED LAND SURVEYOR

N.Y.S. Lic. No. 50447

Nathan Taft Corwin III
Land Surveyor

Title Surveys — Subdivisions — Site Plans — Construction Layout

PHONE (631)727-2090 Fax (631)727-1727

OFFICES LOCATED AT

UNAUTHORIZED ALTERATION OR ADDITION TO THIS SURVEY IS A VIOLATION OF SECTION 7209 OF THE NEW YORK STATE EDUCATION LAW.

COPIES OF THIS SURVEY MAP NOT BEARING THE LAND SURVEYOR'S INKED SEAL OR EMBOSSED SEAL SHALL NOT BE CONSIDERED TO BE A VALID TRUE COPY.

CERTIFICATIONS INDICATED HEREON SHALL RUN ONLY TO THE PERSON FOR WHOM THE SURVEY IS PREPARED, AND ON HIS BEHALF TO THE TITLE COMPANY, GOVERNMENTAL AGENCY AND LENDING INSTITUTION LISTED HEREON, AND TO THE ASSIGNEES OF THE LENDING INSTITUTION. CERTIFICATIONS ARE NOT TRANSFERABLE.