


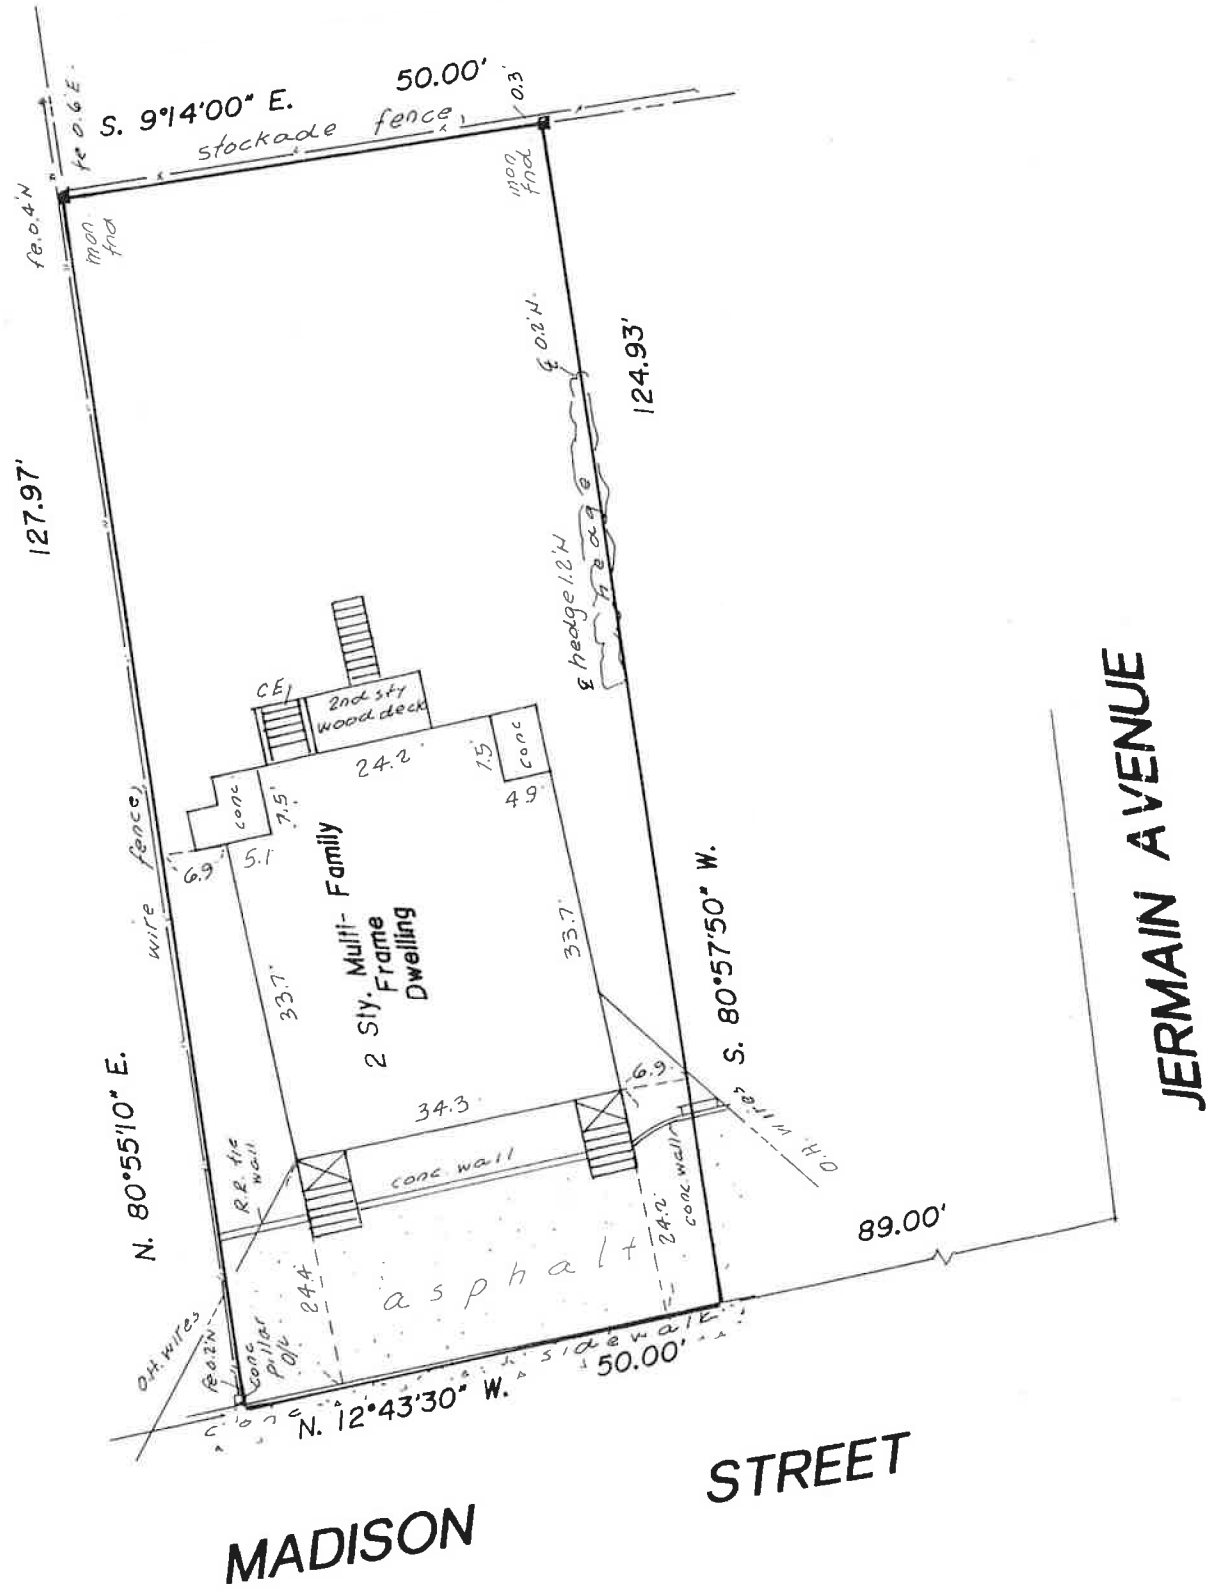

AREA = 6,316 sq.ft.

SURVEY FOR
AT SAG HARBOR
TOWN OF SOUTHAMPTON
SUFFOLK COUNTY, N.Y.
903 - 06 - 04 - 05
Scale: 1" = 20'
May 14, 2002

CERTIFIED TO

FIDELITY NATIONAL TITLE INSURANCE
COMPANY OF NEW YORK
UPSTATE NATIONAL BANK



ANY ALTERATION OR ADDITION TO THIS SURVEY IS A VIOLATION OF SECTION 7209 OF THE NEW YORK STATE EDUCATION LAW, EXCEPT AS PER SECTION 7209-SUBDIVISION 2. ALL CERTIFICATIONS HEREON ARE VALID FOR THIS MAP AND COPIES THEREOF ONLY IF SAID MAP OR COPIES BEAR THE IMPRESSED SEAL OF THE SURVEYOR WHOSE SIGNATURE APPEARS HEREON.

ADDITIONALLY TO COMPLY WITH SAID LAW THE TERM "ALTERED BY" MUST BE USED BY ANY AND ALL SURVEYORS UTILIZING A COPY OF ANOTHER SURVEYOR'S MAP. TERMS SUCH AS "INSPECTED" AND "BROUGHT-TO-DATE" ARE NOT IN COMPLIANCE WITH THE LAW.