

SOUNDVIEW DRIVE

CERTIFIED TO:  
RICHARD PALEOGOS

MAP OF LOT 24; BLOCK 8

Soundview Estates

Filed June 24, 1952 as Map no. 1929

SITUATE

MONTAUK, TOWN OF EAST HAMPTON

SUFFOLK COUNTY, N.Y.

SCALE: 1"=20'

TAX MAP REF: 0300-05-02-24


LOT AREA: 11,250 SQ. FT.

OR 0.26 ACRE



GUARANTEES OR CERTIFICATIONS INDICATED ON  
HALL RUN ONLY TO THE PERSON OR WHO THE SURVEY  
IS PREPARED, & ON HIS BEHALF TO THE TITLE  
COMPANY GOVERNMENTAL AGENCY & LENDING  
INSTITUTIONS LISTED HEREON, & TO THE ASSIGNEES  
OF THE LENDING INSTITUTION, GUARANTEES OR  
CERTIFICATIONS ARE NOT TRANSFERABLE TO  
ADDITIONS OR SUBSEQUENT OWNERS.

EASEMENTS, RIGHT OF WAYS  
UNDERGROUND UTILITIES AND OR  
SANITARY FACILITIES NOT VISIBLE  
AT THE TIME OF SURVEY HAVE NOT  
BEEN SHOWN, LOCATED AND/OR  
GUARANTEED

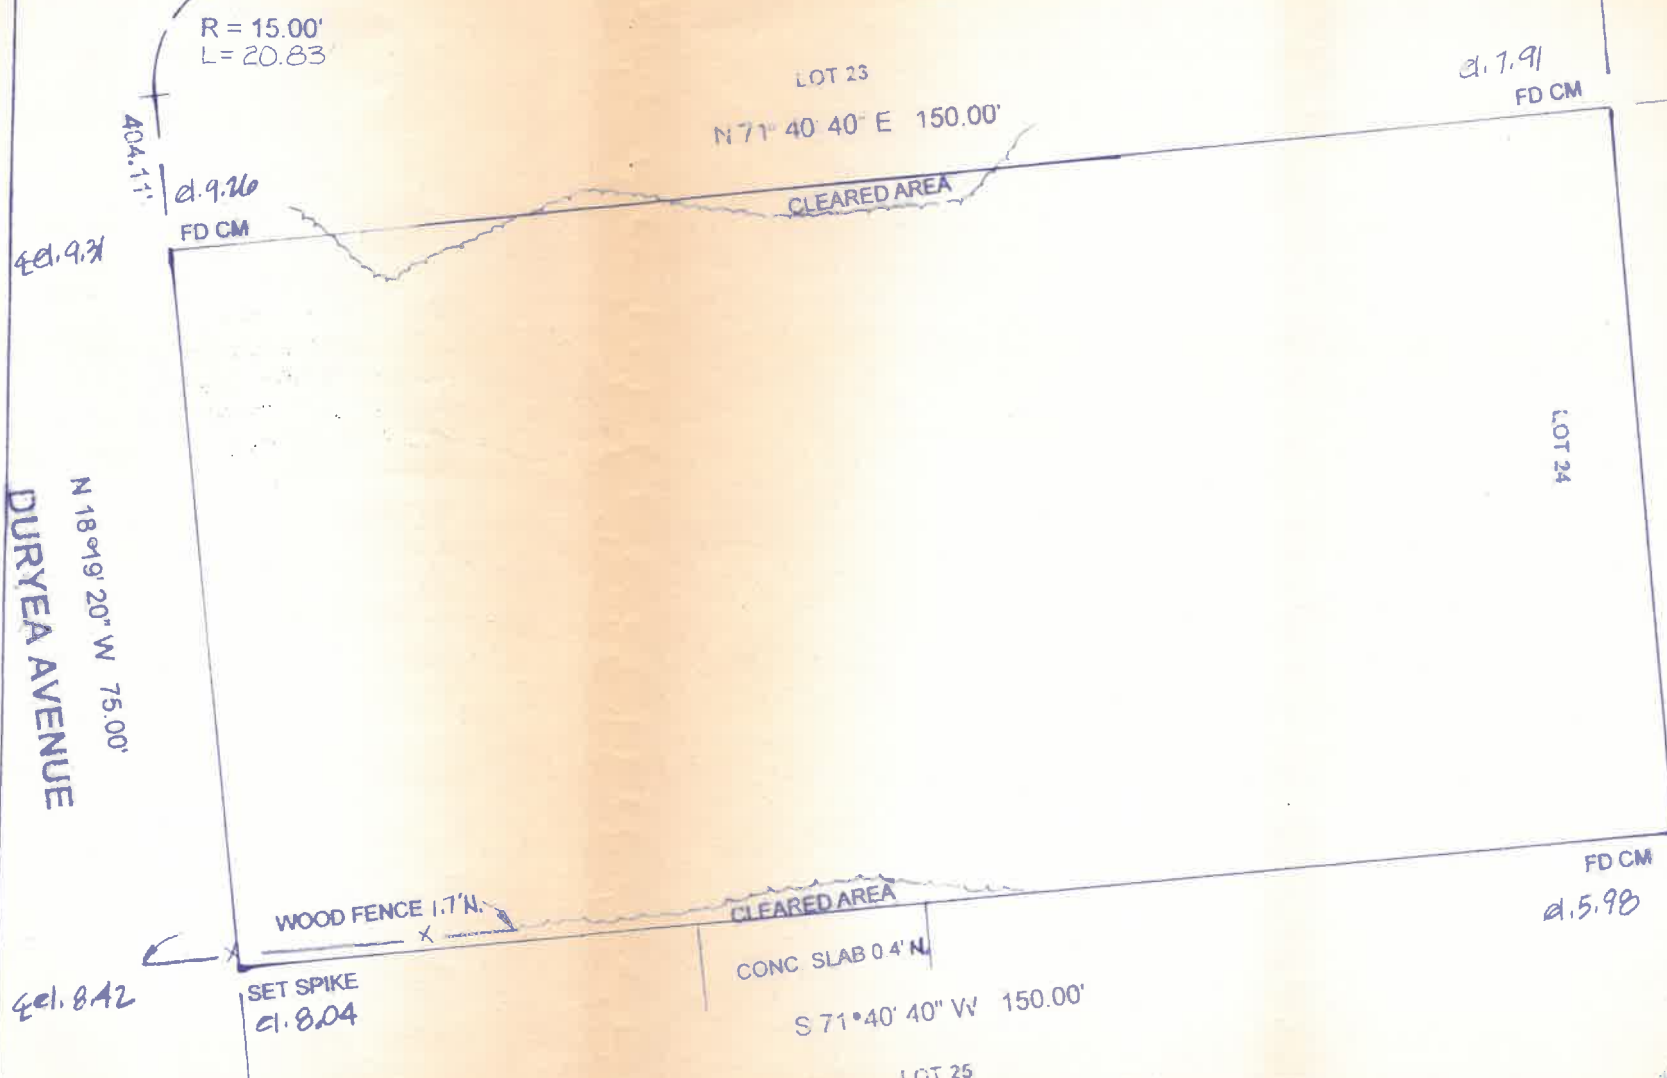

SURVEYED APRIL 22, 2013  
WILLIAM J. WALSH,  
LAND SURVEYOR  
MONTAUK, N.Y.

*William J. Walsh*

