

Prepared in accordance with the minimum standards for title surveys as established by the L.I.A.L.S. and approved and adopted for such use by The New York State Land Title Association.





**SURVEY FOR  
ANTHONY J. BLADOS & DIANE M. BLADOS  
AT LAUREL  
TOWN OF SOUTHOLD  
SUFFOLK COUNTY, N.Y.**

1000 - 128 - 01 - 03

Scale: 1" = 30'

May 19, 1994

CERTIFIED TO:  
ANTHONY J. BLADOS  
DIANE M. BLADOS  
NORTH FORK BANK  
SYNDICATED TITLE INSURANCE COMPANY  
163 - 4995

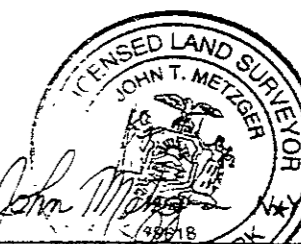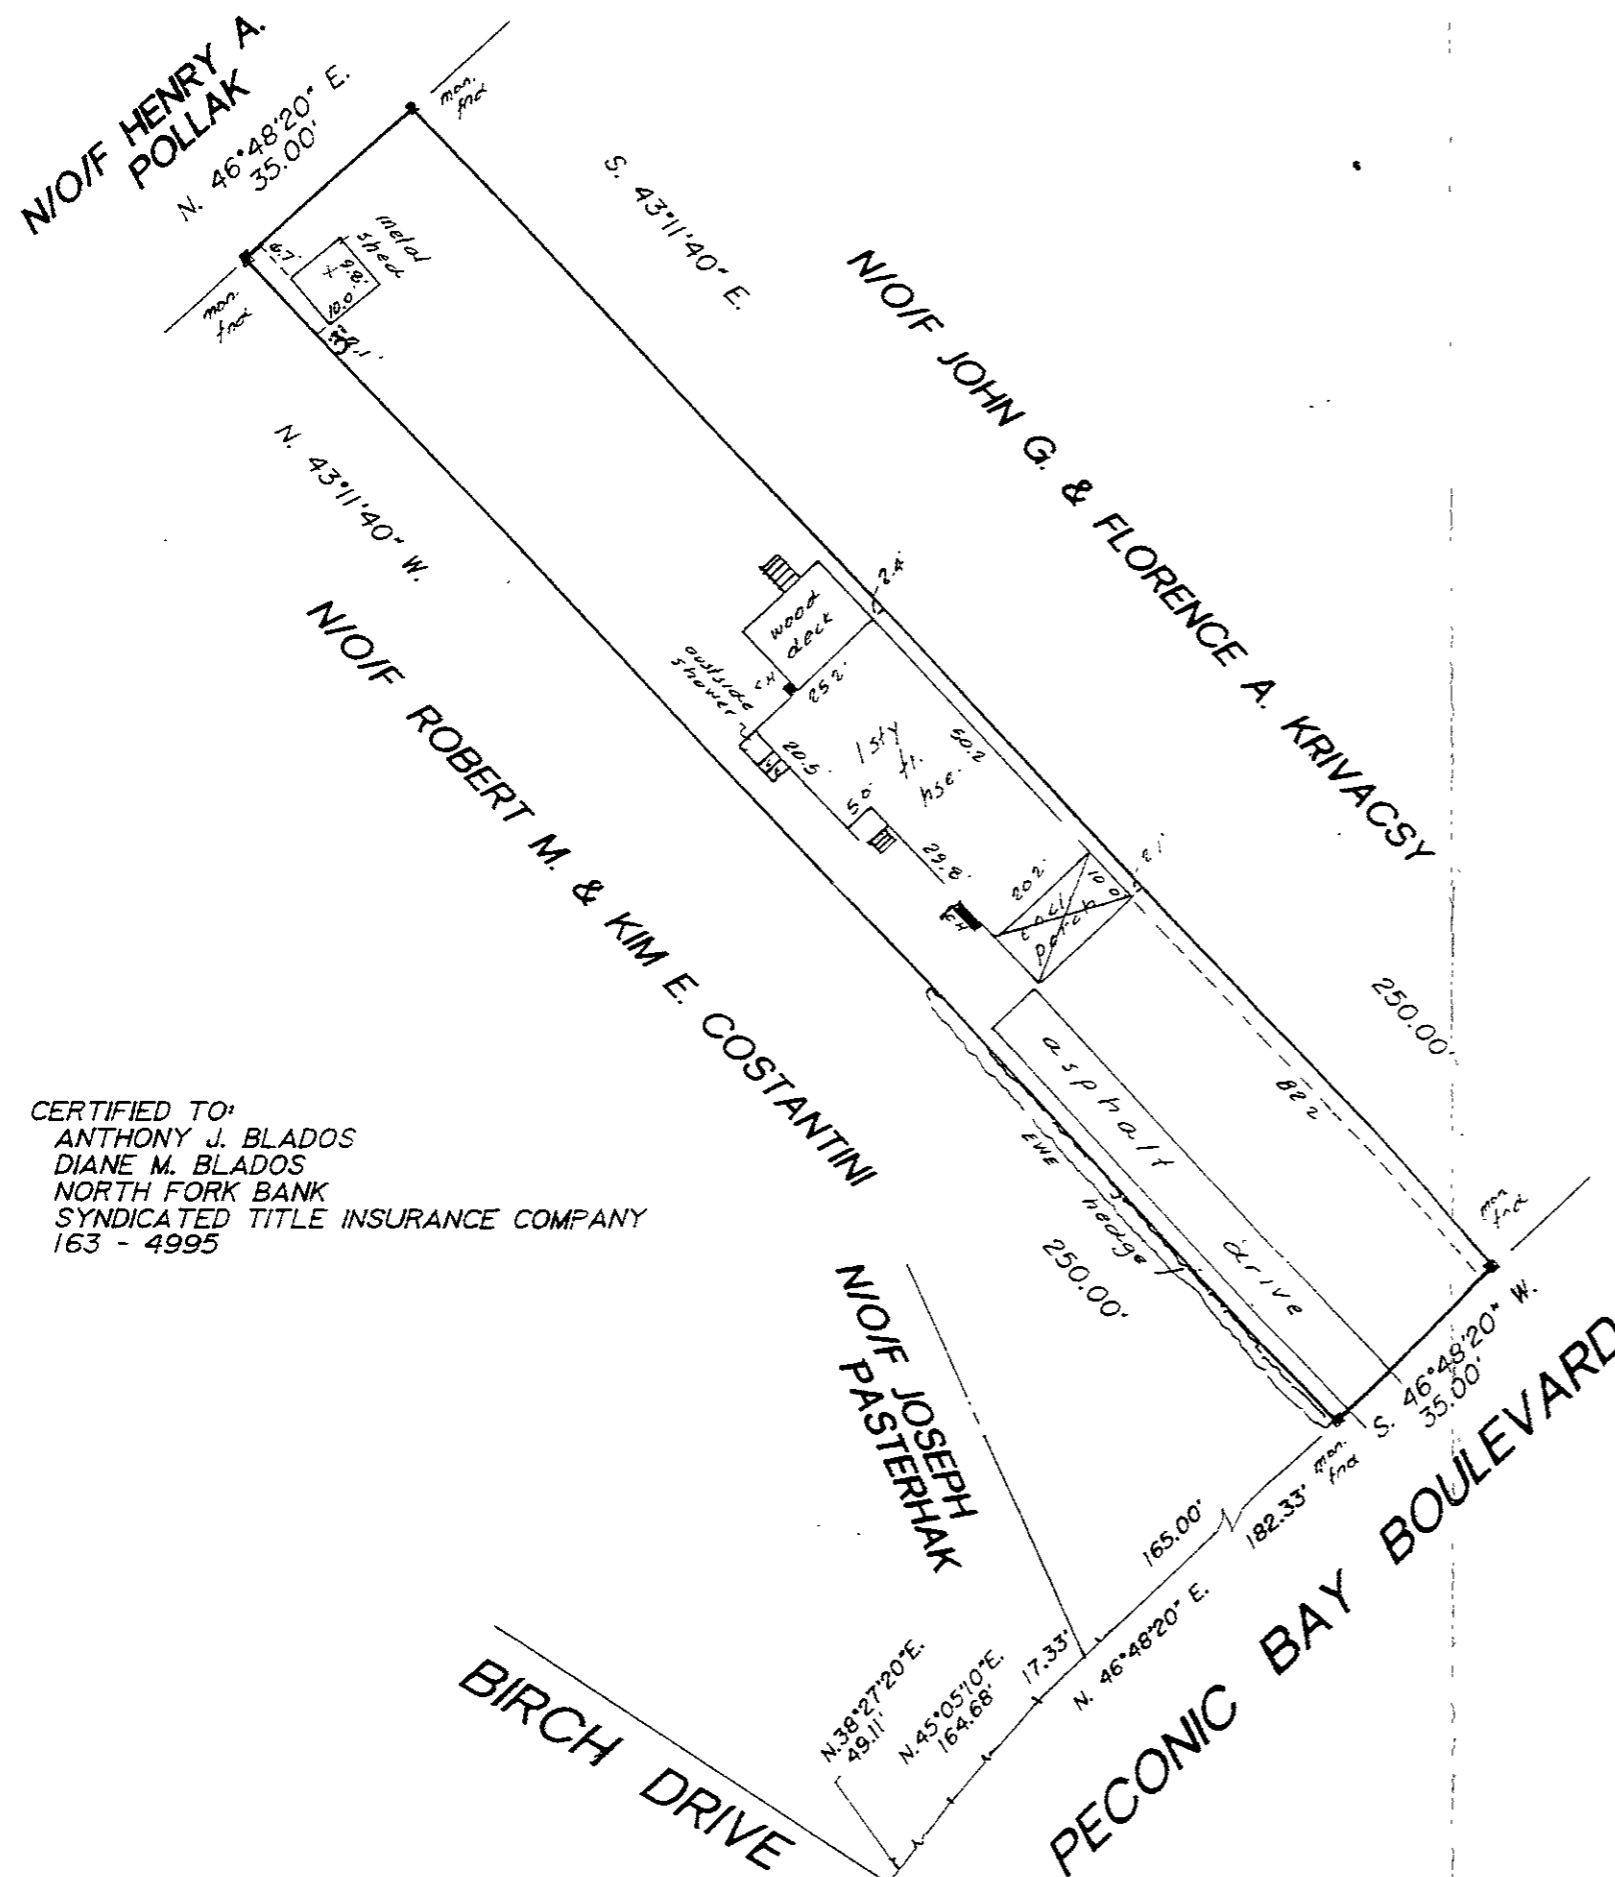

JOHN T. METZGER  
S. LIC. NO. 49618  
PECONIC SURVEYORS, P.C.  
(516) 765 - 5020  
P. O. BOX 909  
MAIN ROAD  
SOUTHOLD, N.Y. 11971