

SURVEY OF PROPERTY

LOT 57

Map of

HAWKS NEST

Section 3

Filed March 20, 1978 as map no. 6658

Situate

AMAGANSETT

Town of East Hampton


Suffolk County, New York

SCALE: 1" = 60'

AREA: 84.171 sq. ft.  
or 1.9323 acres

Certified only to:

Gerriann Tepedino  
JPMorgan Chase Bank, NA  
Fidelity National Title Insurance Company

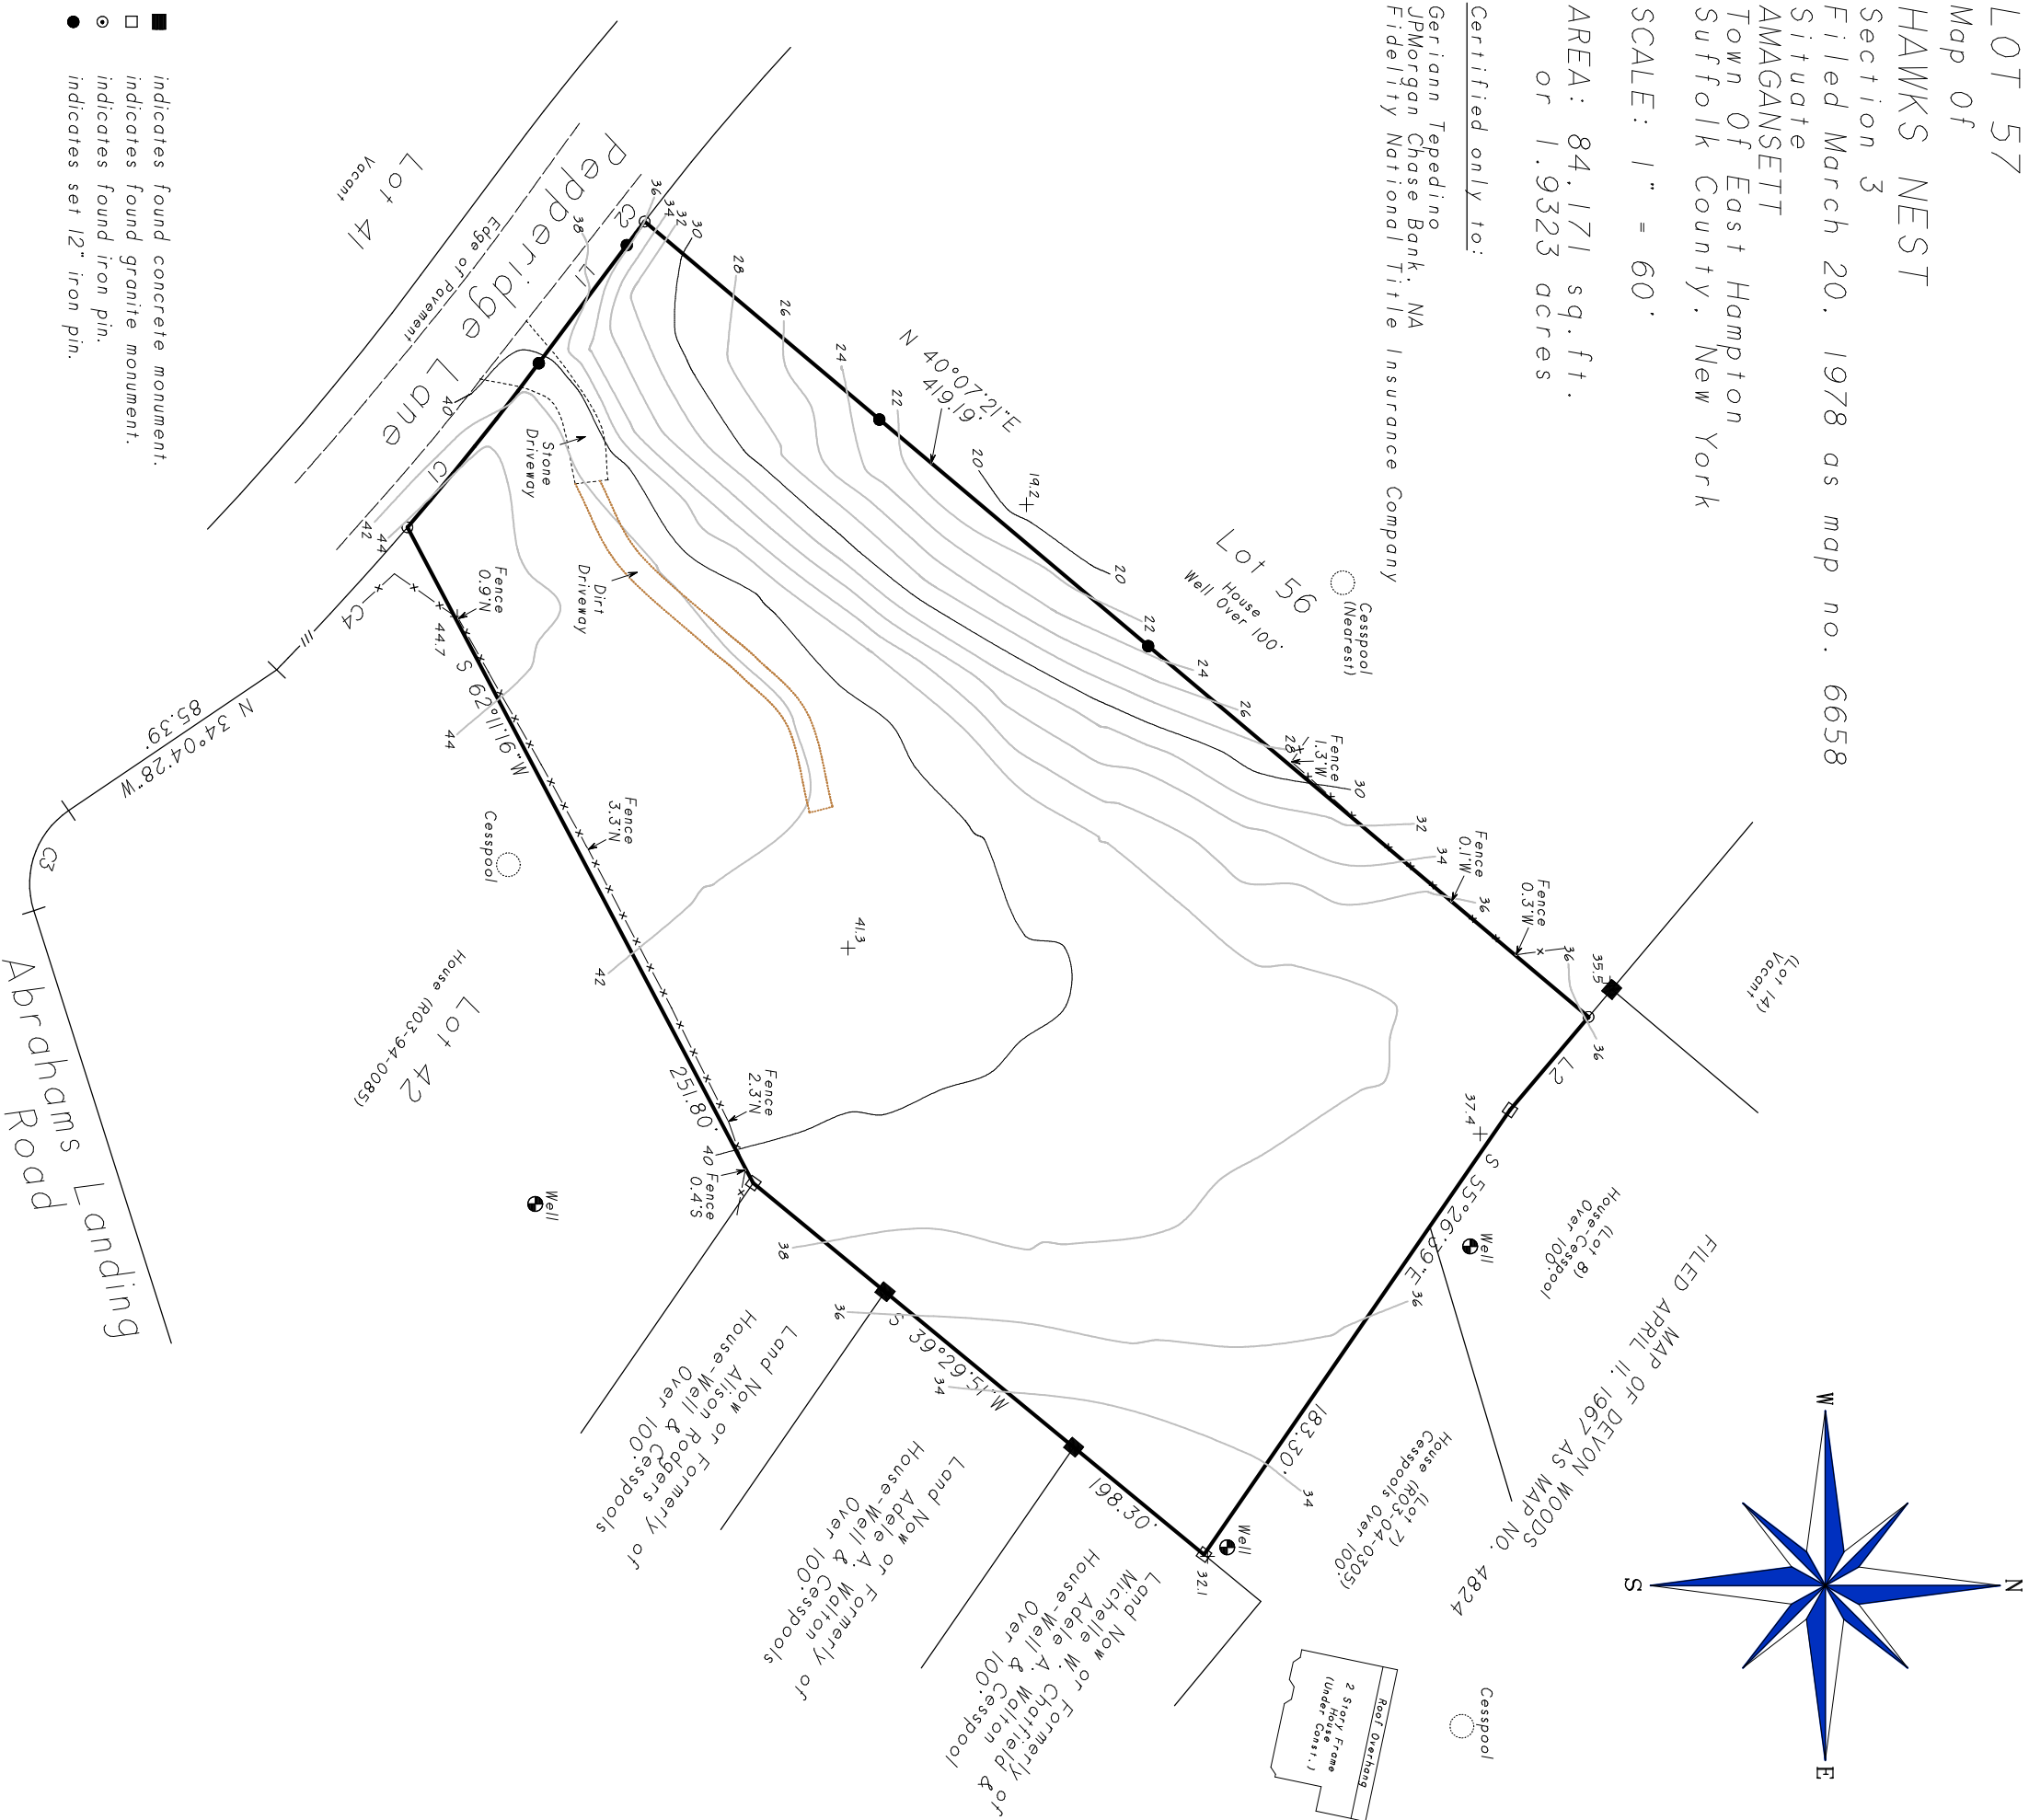

Not a valid copy unless marked  
with original land surveyor's  
embossed seal & signature

April 29, 2014: Update, recertify & topography

**SASKAS**  
SURVEYING  
Saskas Surveying Company, P.C.  
124 Cedar Street  
East Hampton, New York 11937  
(631) 324-6917 FAX 329-4768  
Surveyed: July 7, 2005  
David L. Saskas  
N.Y.S. Lic. No. 049960