


FILE NO.

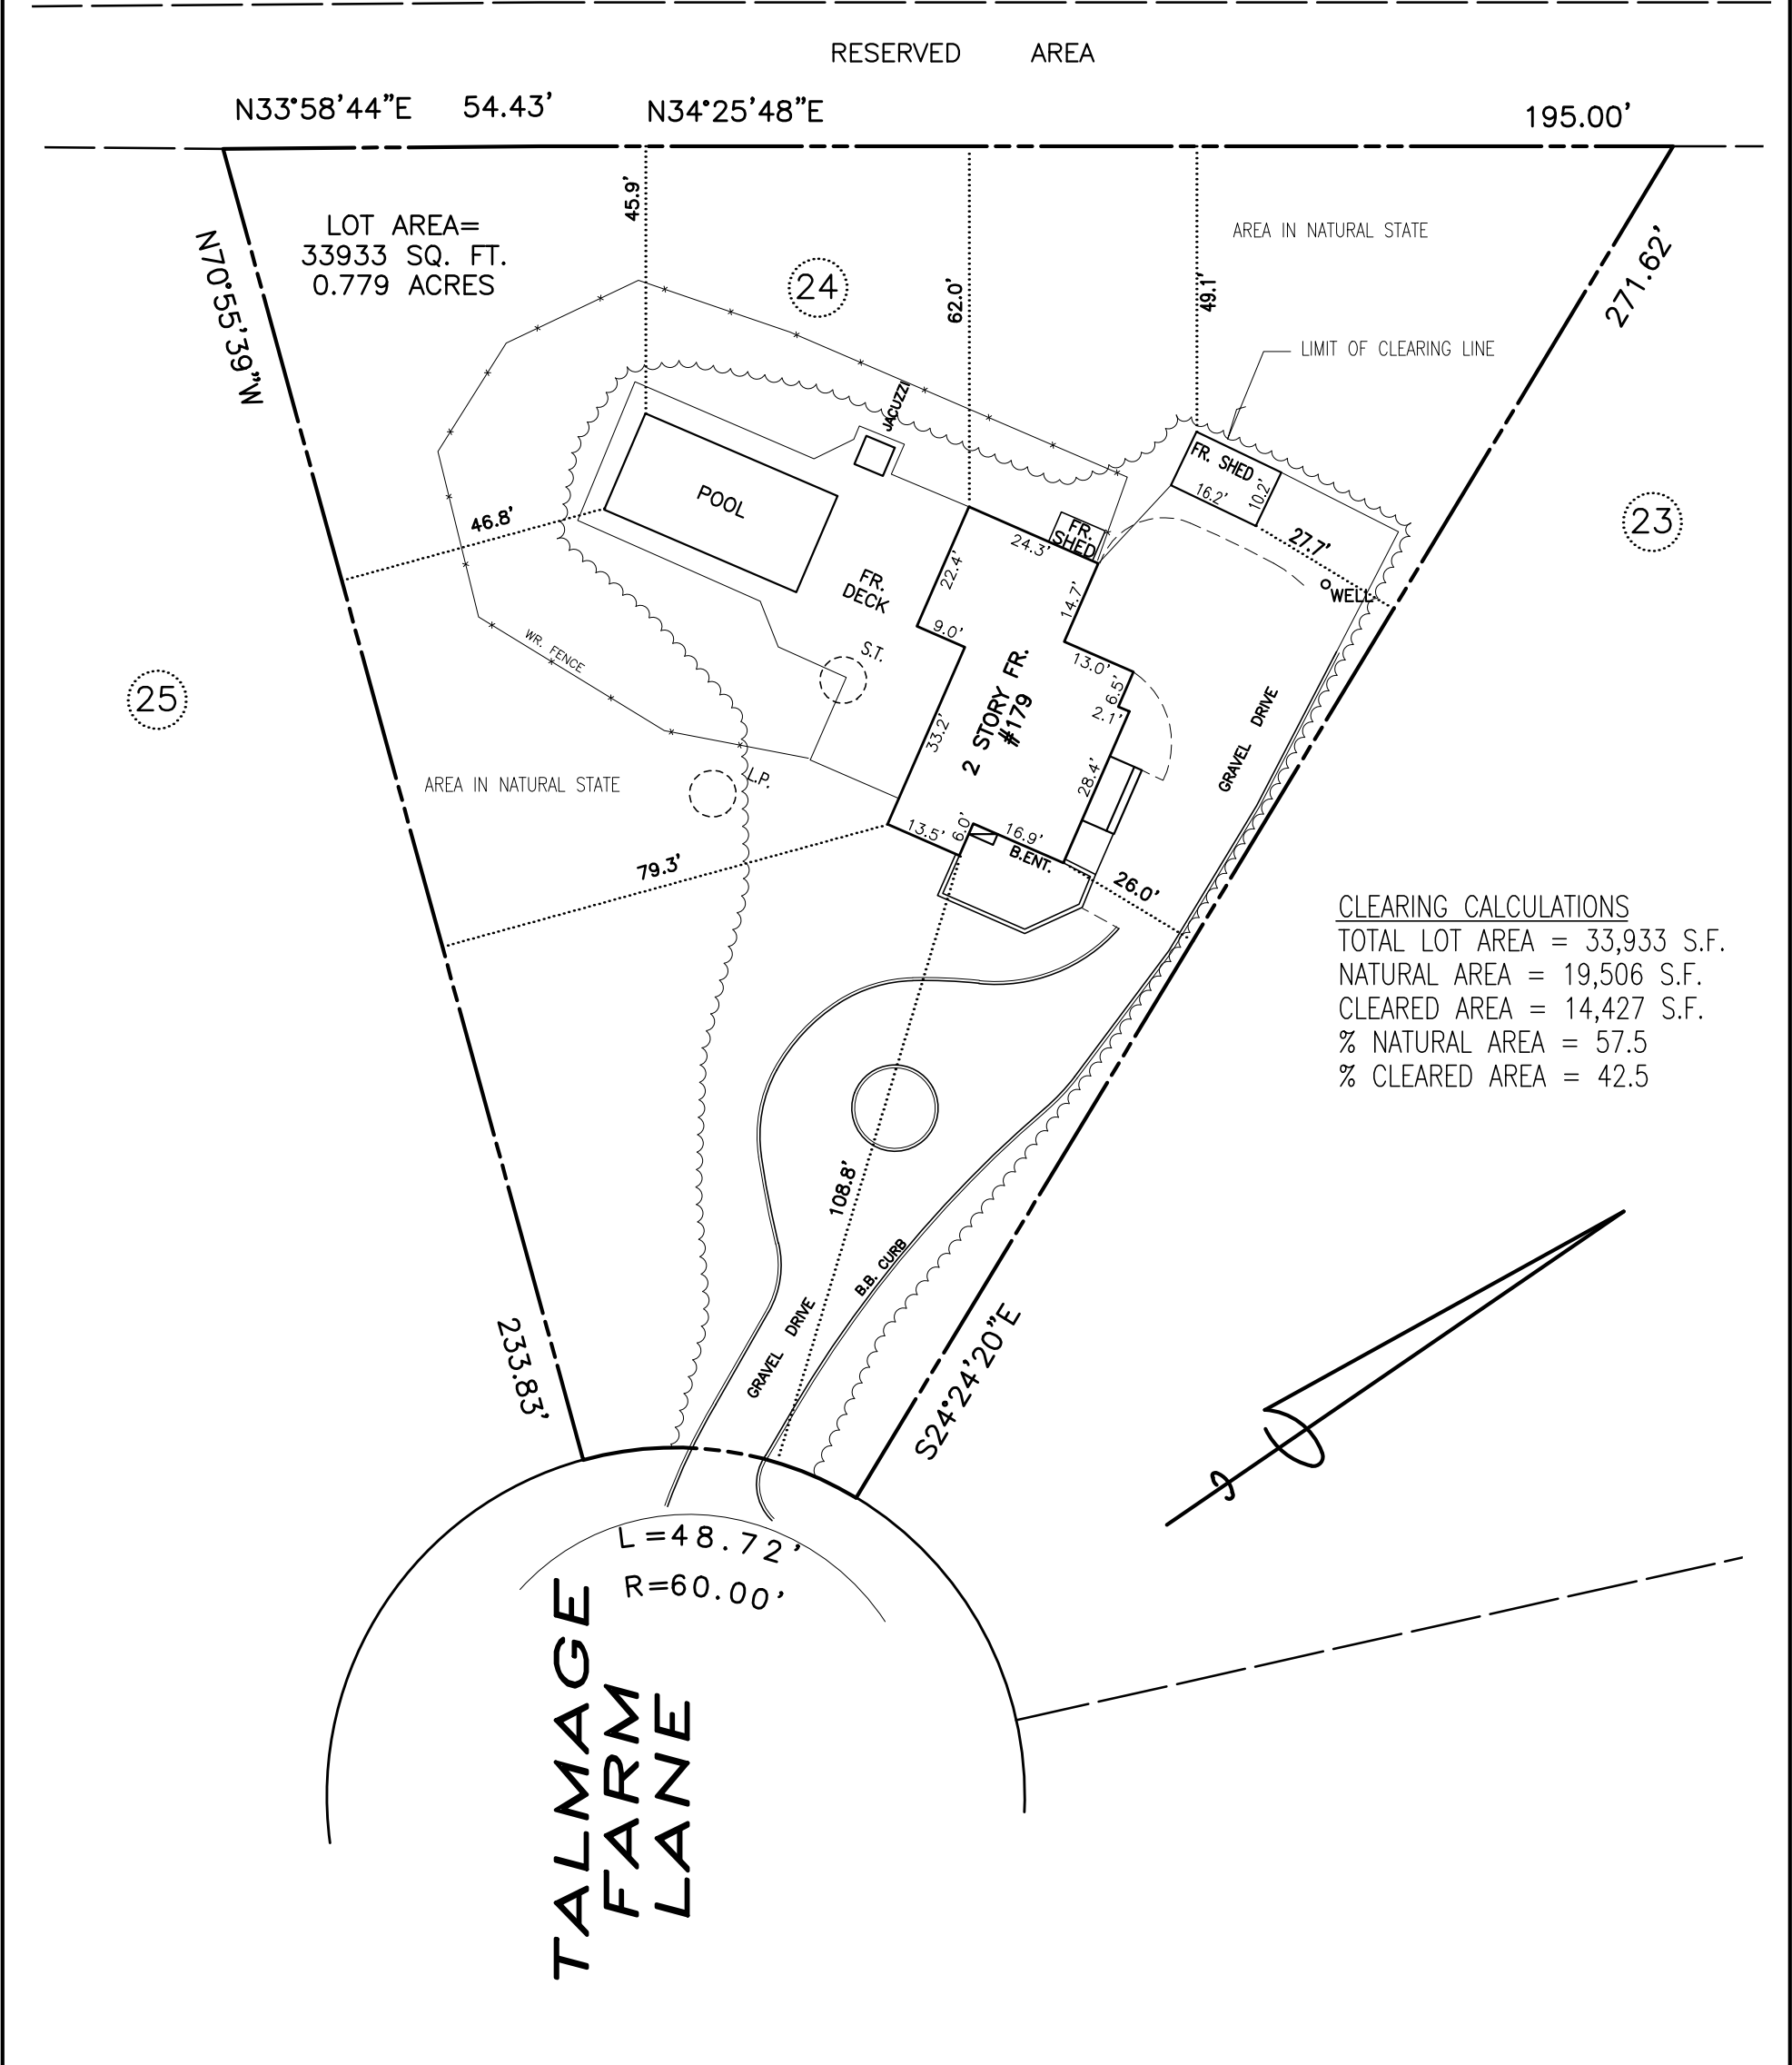

CERTIFIED TO:

EASEMENTS AND/OR SUBSURFACE STRUCTURES RECORDED OR UNRECORDED ARE NOT GUARANTEED UNLESS PHYSICALLY EVIDENT ON THE PREMISES AT THE TIME OF THE SURVEY. GUARANTEES INDICATED HEREON SHALL RUN ONLY TO THE PERSON(S) FOR WHOM THE SURVEY IS PREPARED, AND ON HIS BEHALF TO THE TITLE COMPANY, GOVERNMENTAL AGENCY AND LENDING INSTITUTIONS LISTED HEREON, AND TO THE ASSIGNEES OF THE LENDING INSTITUTION. GUARANTEES ARE NOT TRANSFERABLE TO ADDITIONAL INSTITUTIONS OR SUBSEQUENT OWNERS. THE OFFSETS (OR DIMENSIONS) SHOWN HEREON FROM THE STRUCTURES TO THE PROPERTY LINES ARE FOR A SPECIFIC PURPOSE AND USE AND THEREFORE ARE NOT INTENDED TO GUIDE THE ERECTION OF FENCES, RETAINING WALLS, POOLS, PATIOS, PLANTING AREAS, ADDITIONS TO BUILDINGS AND ANY OTHER CONSTRUCTION.

DWG: R:/9793/9793-TRAKA-2019.DWG

MAP NO. 7075 JOB NO. 9793 12/9/19 LOC. SHED & CLEARING LINE
FILED 5/13/82 REVISIONS:
11/10/08 ADD PROP. SHED

S.C.T.M. DIST.300 SEC.37 BLK. 04 LOT 06

SURVEY OF
LOT 24
MAP OF
"TALMAGE FARM"
SITUATE AT
THE SPRINGS
TOWN OF EAST HAMPTON
SUFFOLK COUNTY, NEW YORK
SCALE 1"=30' SEPTEMBER 7, 2007



AMERICAN ENGINEERING
& LAND SURVEYING P.C.

1171 old country road - ste. 6
plainview, ny 11803
tel: 516.454.7500
fax: 516.822.2743
www.aelandsurveying.com

STEPHEN E. RAVN, P.E., L.S. (L.S. NO. 49664)