


4666 - CBZ01

SUFFOLK COUNTY TAX MAP
DISTRICT: 0800
SECTION: 374.00
BLOCK: 01.00
PARCEL: 013.000

6ER

CERTIFIED TO:
LAWRENCE R. LUCE
BANK OF NEW YORK
MORTGAGE COMPANY
FIDELITY NATIONAL TITLE
INSURANCE COMPANY OF
NEW YORK

UNAUTHORIZED ALTERATION IN ADDITION TO
A SURVEY MAP BEARING A LICENSED LAND
SURVEYOR'S SEAL IS A VIOLATION OF SECTION
7205 SUB DIVISION 2, OF THE NEW YORK
EDUCATION LAW
COPIES OF THIS SURVEY MAP NOT BEARING THE
LAND SURVEYOR'S GREEN INKED SEAL OR EMBOSSED
SEAL SHALL NOT BE CONSIDERED TO BE A VALID
TRUE COPY
CERTIFICATIONS INDICATED HEREON SIGNIFY THAT
THIS SURVEY WAS PREPARED IN ACCORDANCE WITH
THE EXISTING CODE OF PRACTICE FOR LAND SURVEYS
ADOPTED BY THE NEW YORK STATE ASSOCIATION OF
PROFESSIONAL LAND SURVEYORS. SAID CERTIFICATIONS
SHALL RUN ONLY TO THE PERSON FOR WHOM THE
SURVEY IS PREPARED AND ON HIS BEHALF TO THE
TITLE COMPANY, GOVERNMENTAL AGENCY AND LENDING
INSTITUTION LISTED HEREON, AND TO THE ASSOCIATION
OF THE LENDING INSTITUTION. CERTIFICATIONS ARE NOT
TRANSFERABLE TO ADDITIONAL INSTITUTIONS OR
SUBSEQUENT OWNERS.

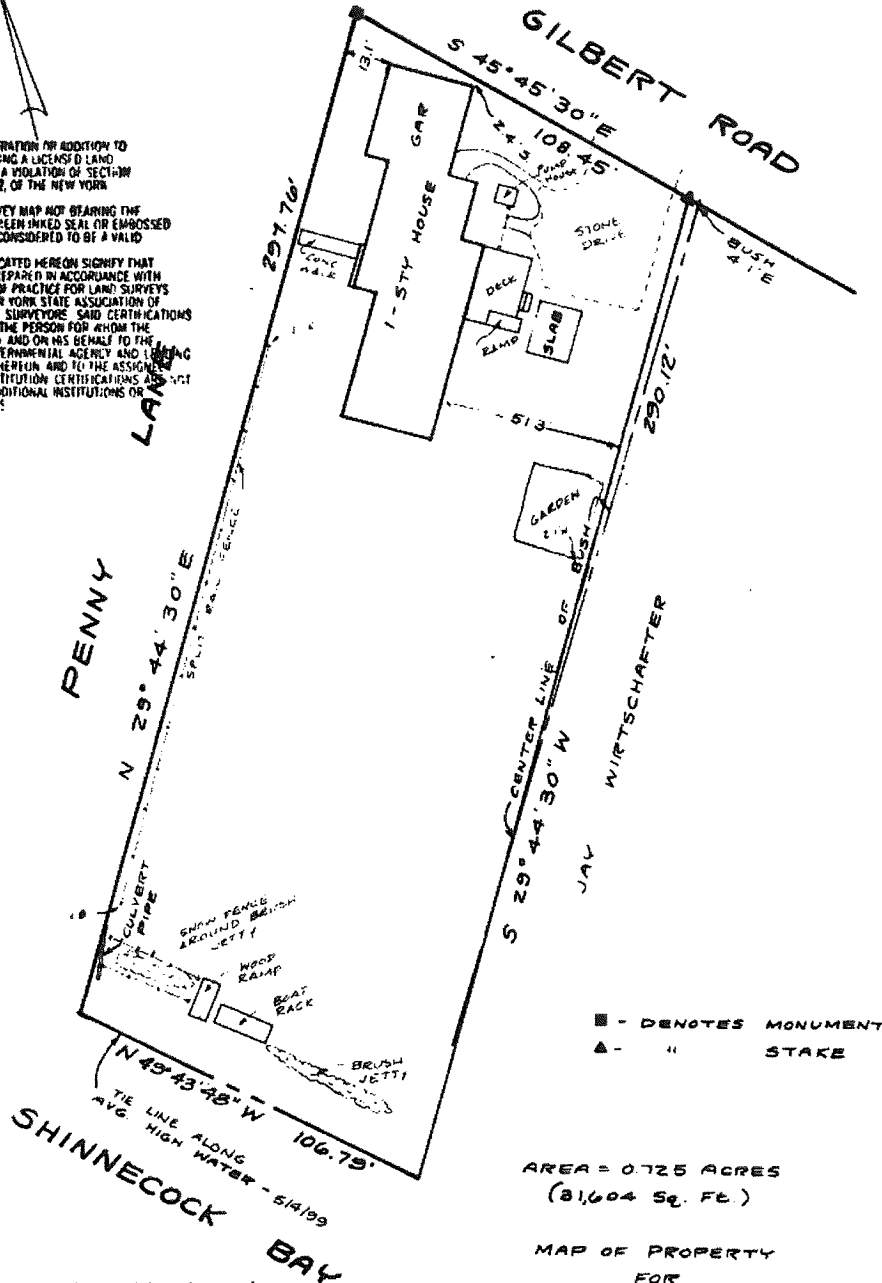

■ - DENOTES MONUMENT
▲ - " " STAKE

AREA = 0.725 ACRES
(31,604 Sq. Ft.)

MAP OF PROPERTY
FOR

LAWRENCE R. LUCE
SITUATE

HAMPTON BAYS

TOWN OF SOUTHAMPTON

SUFFOLK COUNTY, N.Y.

SCALE: 1" = 40'

AREA = 0.708 ACRE
(30861 Sq. Ft.) TO TIE LINE

REVISED: JULY 6, 1999 (shed and lean-to gone)
SURVEYED: MAY 4, 1999

MASTER HOLDING No. 49548
S.H.W. LAND SURVEYORS P.C.
SOURCES: PROCEEDS
WEISBUBER & SMITH
LAND SURVEYORS & ENGINEERS
SOUTHAMPTON, N.Y.