

Montouk (Storm-R.txt)

HITHER HILLS


SITUATE

CONTENTS

Area: 52,999 Sq. Ft. or 1.217 Acres
Lot Area: 37,332 Sq. Ft. or 0.857 Acres

(Excl. Scoled Wetlands From 1987 And
E.H. Town & NYSDEC Determined Wetlands 2002)

Certified To:
Montauk Fairview, LLC
Christopher Reid
Kylie Nottogge

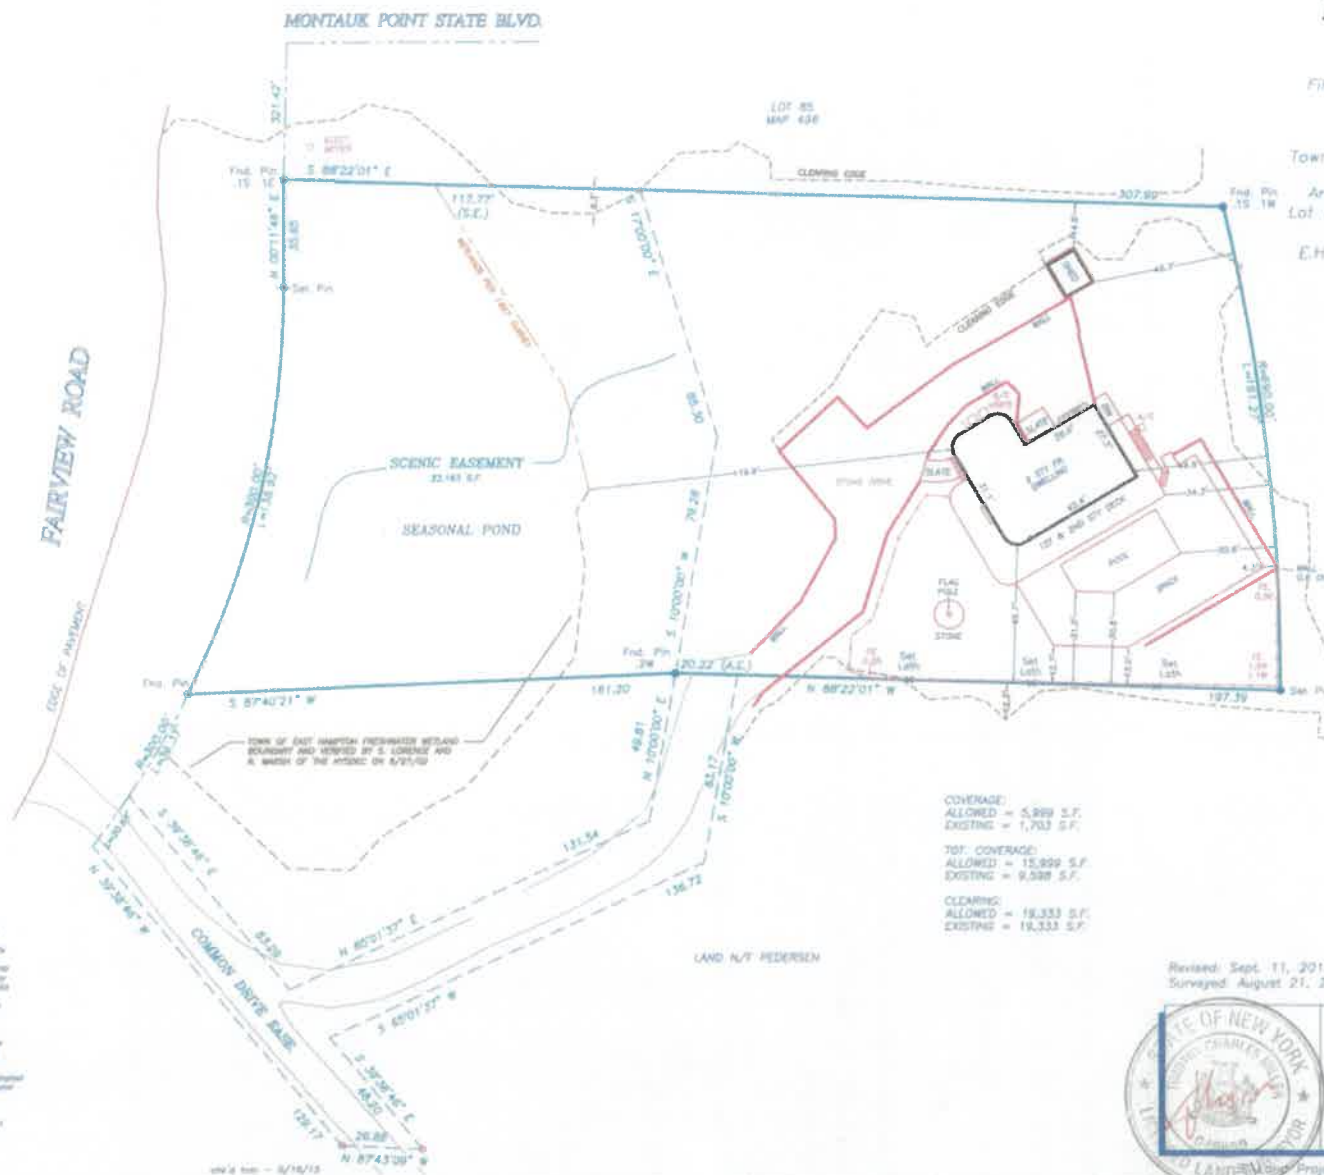

NOTE

- [illegible]



COVERAGE:
ALLOWED = 5,899 S.F.
EXISTING = 1,703 S.F.

TOT. COVERAGE:
ALLOWED = 15,929 S.F.
EXISTING = 9,328 S.F.

CLEARING:
ALLOWED = 19.333 S.F.
EXISTING = 19.333 S.F.

Revised: Sept. 11, 2015 – Moved Shed Only
Surveyed: August 21, 2015



GEORGE WALBRIDGE SURVEYORS, P.C.
Land Surveyors & Land Planners
300 Pantigo Place - Suite 116
East Hampton, Long Island, N.Y. 11937
Phone: (631) 324-0412 Fax: (631) 324-9849
E-mail: ohsurveyors@aol.com

\\Fs01-Projects.Dove\Hilber Hills\dwg\FHsine.DC10786_9-11-15