

Subdivision Map - "Barry Beil, Section 2"  
Suffolk County File no. 8023

Survey for:  
**JASON PASIEKA & JOY PASIEKA**  
At  
**Lot 2, "125 Montauk Hwy Group LLC."**

**Village of Quogue**  
Town of  
**Southampton**  
Suffolk County, New York  
S.C.T.M.: 0802-004-00-01.00-084.003

SEPT. 15, 2020 INDICATED DATE EXAMINED  
DATE: SEPT. 04, 2020  
JOB NO. 2020-268

CERTIFIED TO:  
**JASON PASIEKA & JOY PASIEKA**  
AMTRUST TITLE INSURANCE COMPANY




**DAVID H. FOX, L.S. P.C., N.Y.S.L.S. #50234**  
**FOX LAND SURVEYING**  
64 SUNSET AVENUE  
WESTHAMPTON BEACH, N.Y. 11978  
(631) 288-0022

UNAUTHORIZED ALTERATION OR ADDITION TO THIS SURVEY  

DWG. 2020-268

- NOTES:
1. AREA = 46,193 S.F.
  2. AREA LESS FLAG = 43,800 S.F.
  3. SUBDIVISION MAP "125 MONTAUK HWY GROUP LLC."
  4. FILED IN THE OFFICE OF THE CLERK OF SUFFOLK COUNTY ON MAY 26, 2016 AS FILE NO. 12034.

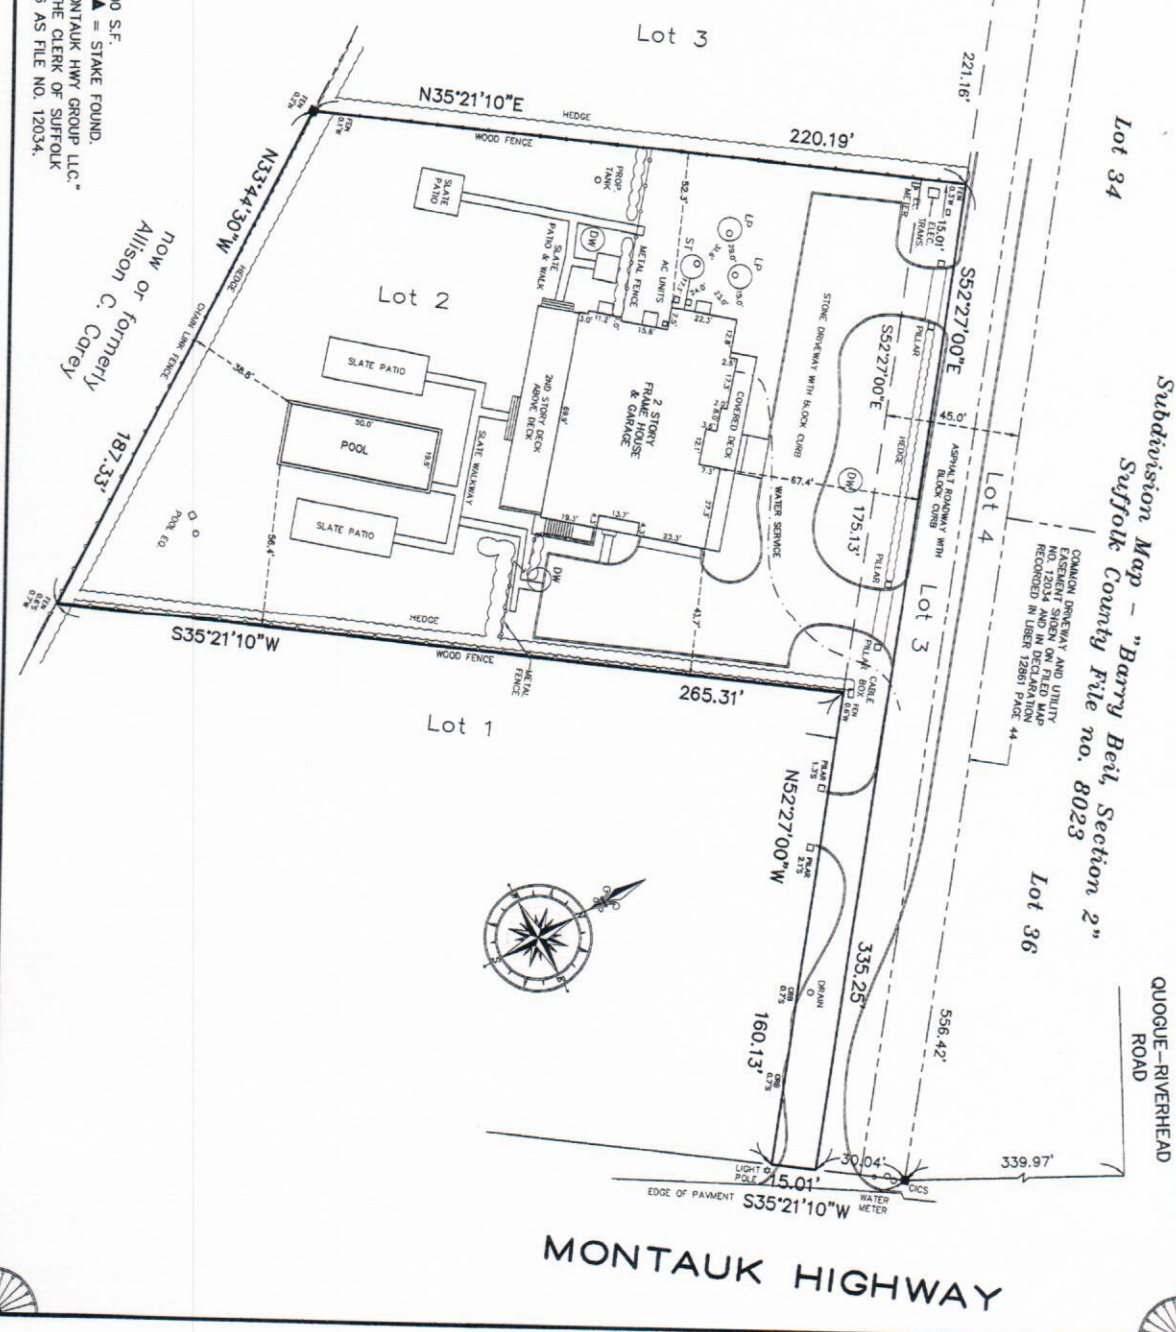

**MONTAUK HIGHWAY**