


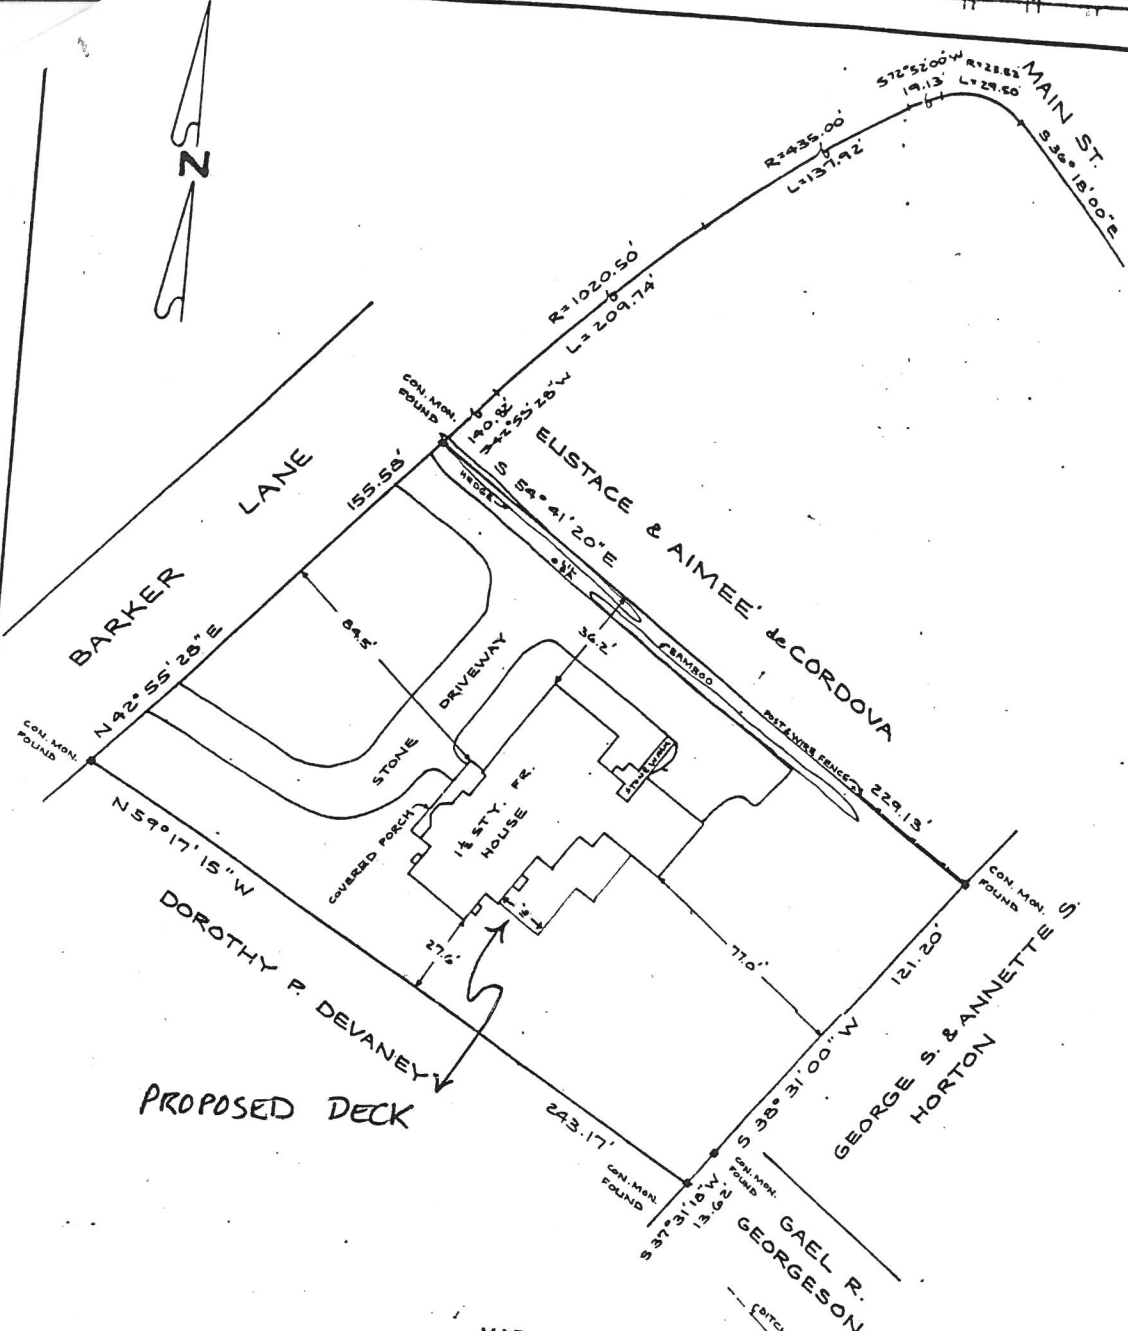

PROPOSED DECK

TAX MAP
DISTRICT: 0902
SECTION: 007
BLOCK: 01
LOT: 36

MAP OF PROPERTY
PETER DUFFY
SITUATE
QUOGUE
TOWN OF SOUTHAMPTON — SUFFOLK COUNTY, N.Y.
SURVEYED: MAY 5, 1992 — SCALE: 1" INCH = 40 FEET

UNAUTHORIZED ALTERATION OR ADDITION TO THIS SURVEY IS A VIOLATION OF SECTION 7209 OF THE NEW YORK STATE EDUCATION LAW.
COPIES OF THIS SURVEY MAP NOT BEARING THE LAND SURVEYOR'S INKED SEAL OR EMBOSSED SEAL SHALL NOT BE CONSIDERED TO BE A VALID TRUE COPY.
GUARANTEES INDICATED HEREON SHALL RUN ONLY TO THE PERSON FOR WHOM THE SURVEY IS PREPARED, AND ON HIS BEHALF TO THE TITLE COMPANY, GOVERNMENTAL AGENCY AND TO THE ASSIGNEES OF THE LENDING INSTITUTION. GUARANTEES ARE NOT TRANSFERABLE TO ADDITIONAL INSTITUTIONS OR SUBSEQUENT OWNERS.

D29 B 81
RAYNOR & MARCKS
SURVEYORS, P.C.
QUOGUE, N.Y.
516-653-4066

■ = CONCRETE MONUMENT
Δ = WOOD STAKE
BK 96 PG. 65
AREA = 33,910 SQ. FT.

CERTIFIED TO:
PETER DUFFY

STATE OF NEW YORK
STEPHEN M. MARCKS
LICENSED LAND SURVEYOR
No. 048585