


**SURVEY OF PROPERTY
IN THE VILLAGE OF
GREENPORT
TOWN OF SOUTHOLD
SUFFOLK COUNTY, NEW YORK**

1001-04-08-34.2

SCALE: 1"=20'

JULY 23, 2002

N/O/F ELK ASSOCIATES FUNDING CORP. &
KWIAT CAPITAL CORP.

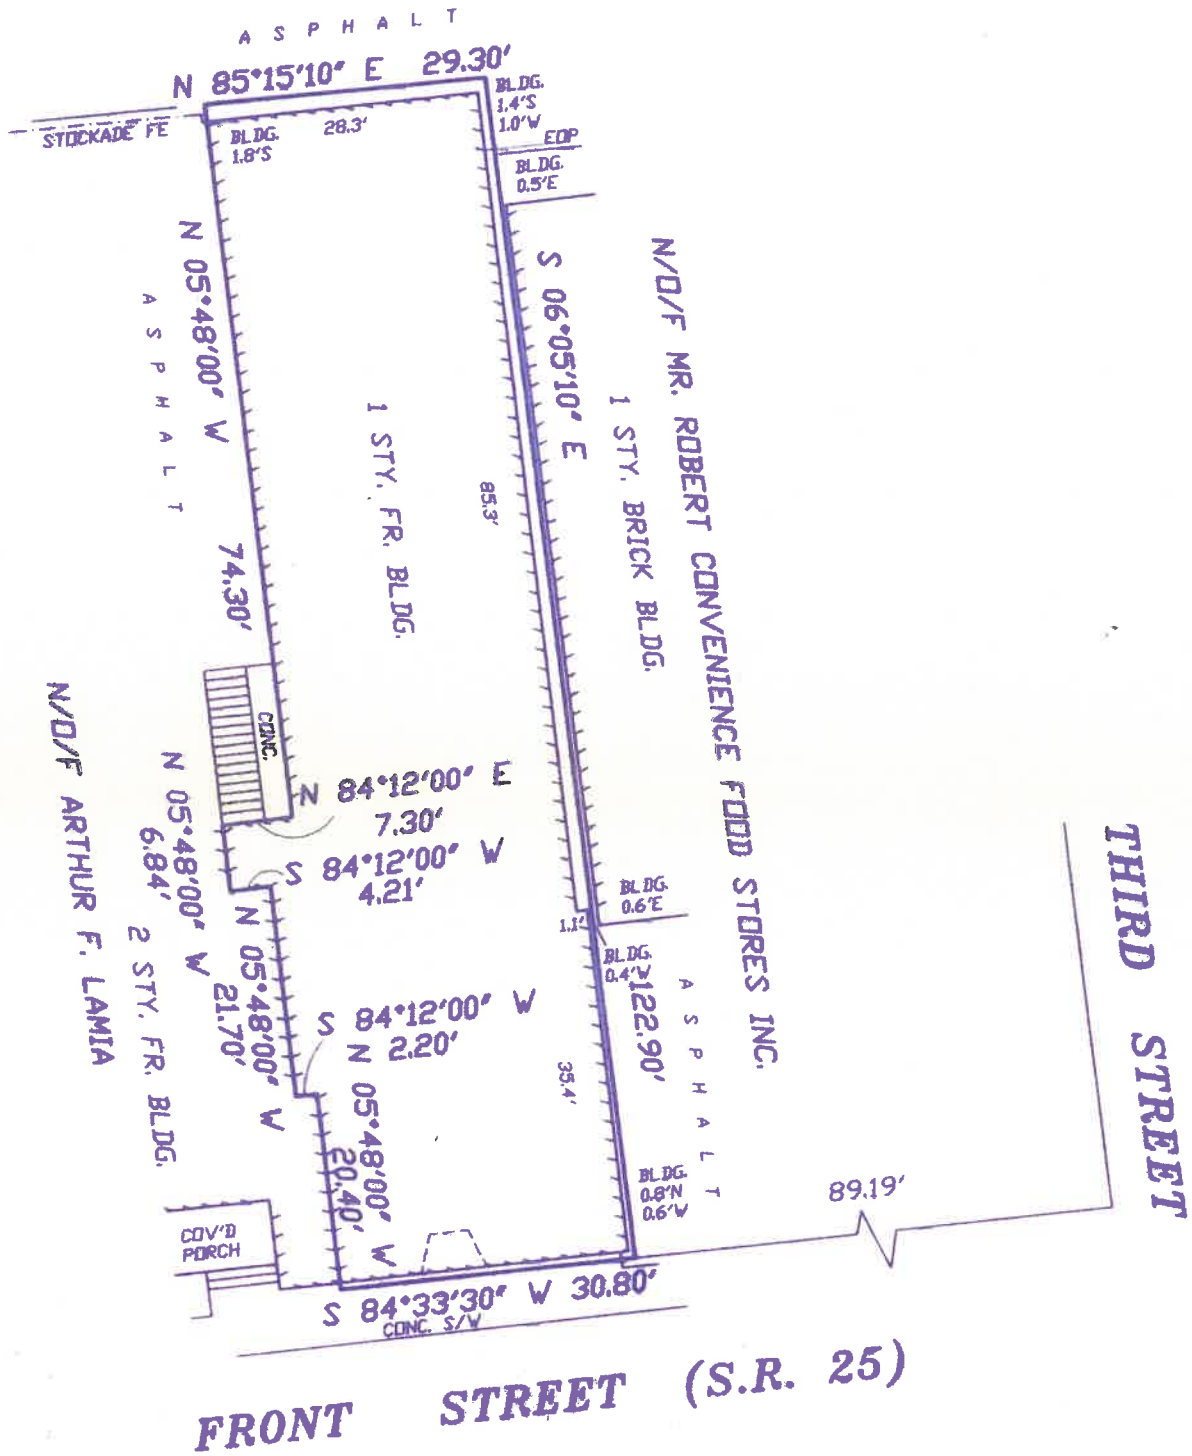

EASEMENTS IF ANY NOT SHOWN HEREON

AREA=3,778 S.F.

CERTIFIED TO:
JOSEPH & PETER COSTARELLA
MICHAEL PERIVOLARIS
THE BANK OF NEW YORK
FIDELITY NATIONAL TITLE INSURANCE COMPANY



N.Y.S. LIC. NO. 49618

PECONIC SURVEYORS, P.C.


FAX:(631) 765-1797

1230 TRAVELER STREET
SOUTHOLD, N.Y. 11971

ANY ALTERATION OR ADDITION TO THIS SURVEY IS A VIOLATION OF SECTION 7209 OF THE NEW YORK STATE EDUCATION LAW, EXCEPT AS PER SECTION 7209-SUBDIVISION 2. ALL CERTIFICATIONS HEREON ARE VALID FOR THIS MAP AND COPIES THEREOF ONLY IF SAID MAP OR COPIES BEAR THE IMPRESSED SEAL OF THE SURVEYOR WHOSE SIGNATURE APPEARS HEREON.

99-357