

NOTES:

1. ELEVATIONS ARE REFERENCED TO N.A.V.D. 1988 DATUM
EXISTING ELEVATIONS ARE SHOWN THUS: $\times_{00.00}$

**SURVEY OF
PROPERTY
SITUATE
SOUTHOLD**

TOWN OF SOUTHOLD
SUFFOLK COUNTY, NEW YORK
S.C. TAX No. 1000-51-01-04

SCALE 1"=50'

MARCH 26, 2019

MARCH 6, 2020 FOUNDATION LOCATION

DECEMBER 23, 2020 FINAL SURVEY

DECEMBER 29, 2020 ADD PROPOSED POOL


JANUARY 14, 2021 ADD POOL FENCE

APRIL 20, 2021 REMOVE PROPOSED POOL,
ADD NON-DISTURBANCE LINE, LOCATE EROSION LINE

APRIL 26, 2021 LOCATE EROSION LINE,
RELOCATE TOP OF BLUFF, ADJUST ELEVATIONS

JUNE 10, 2021 DRYWELL REMOVED, NEW ONE INSTALLED

AREA = 29,331.8 sq. ft.
0.673 ac.

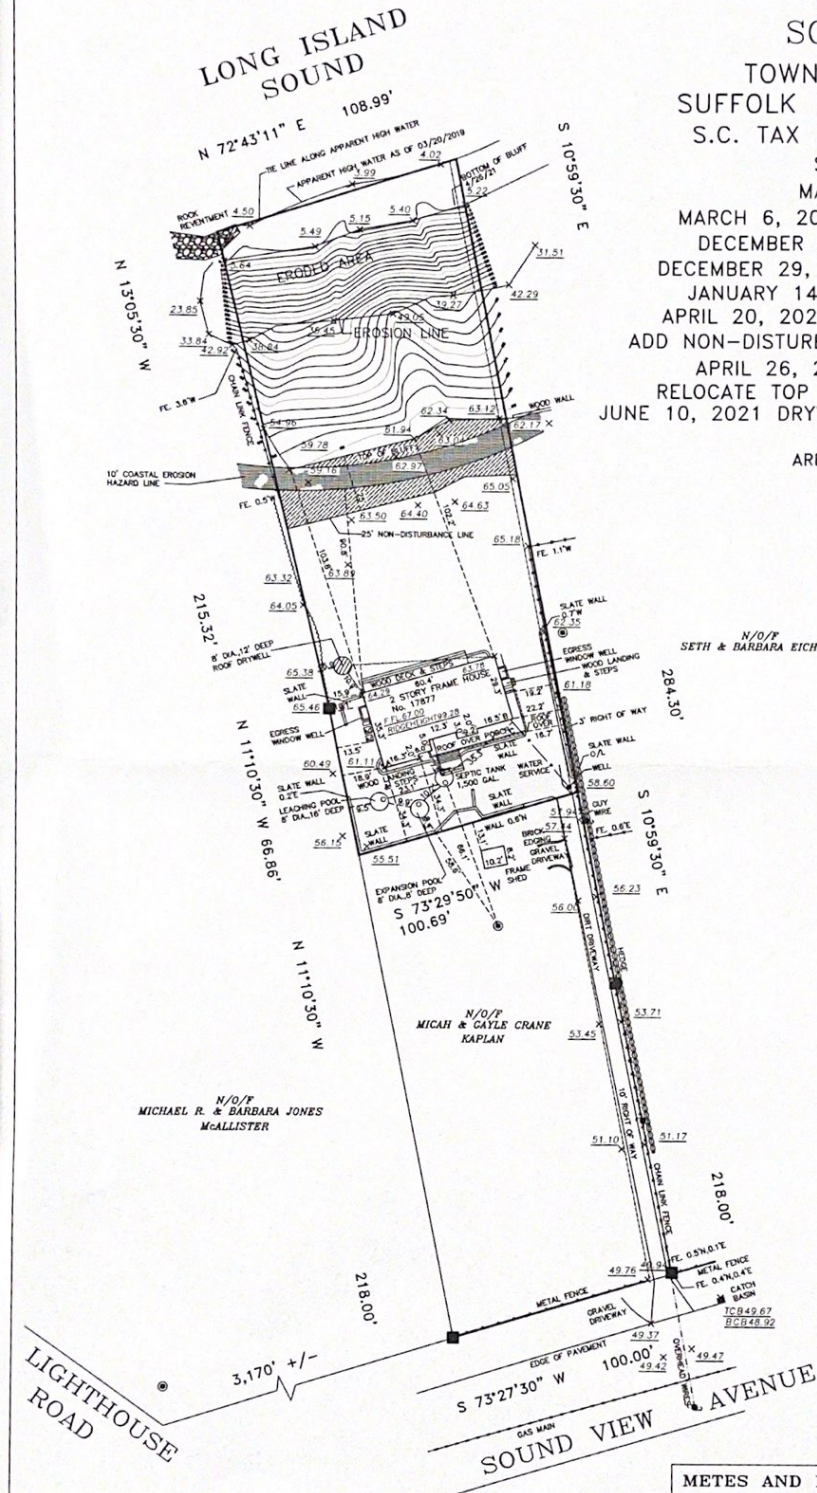

NOTE: LOCATIONS AND EXISTENCE OF ANY
SUBSURFACE UTILITIES AND/OR STRUCTURES
NOT READILY VISIBLE, ARE NOT CERTIFIED.

METES AND BOUNDS SURVEYING

53 PROBST DRIVE
SHIRLEY, NY 11967
PHONE (516) 972-5812
survey@metesandbounds.com

LOTS: 04 BLOCK: 01 SECTION: 51 DISTRICT: 1000

MAP OF:

SITUATED AT: SOUTHOLD

TOWN OF SOUTHOLD, SUFFOLK CO., N.Y.

CERTIFIED TO:

JOB NO.: 19-1691
DATE: JUNE 10, 2021