


Situate:
Incorporated Village of East Hampton
Town of East Hampton, Suffolk Co. N.Y.
Scale: 1" = 50'
Guaranteed to:
Edward Herbst

GEORGE H. WALBRIDGE CO.

BY Charles R. Quinn

Note: ⁷⁴⁸⁻¹³⁰ The existence of right of ways and/or easements of record, if any, not shown are not guaranteed.

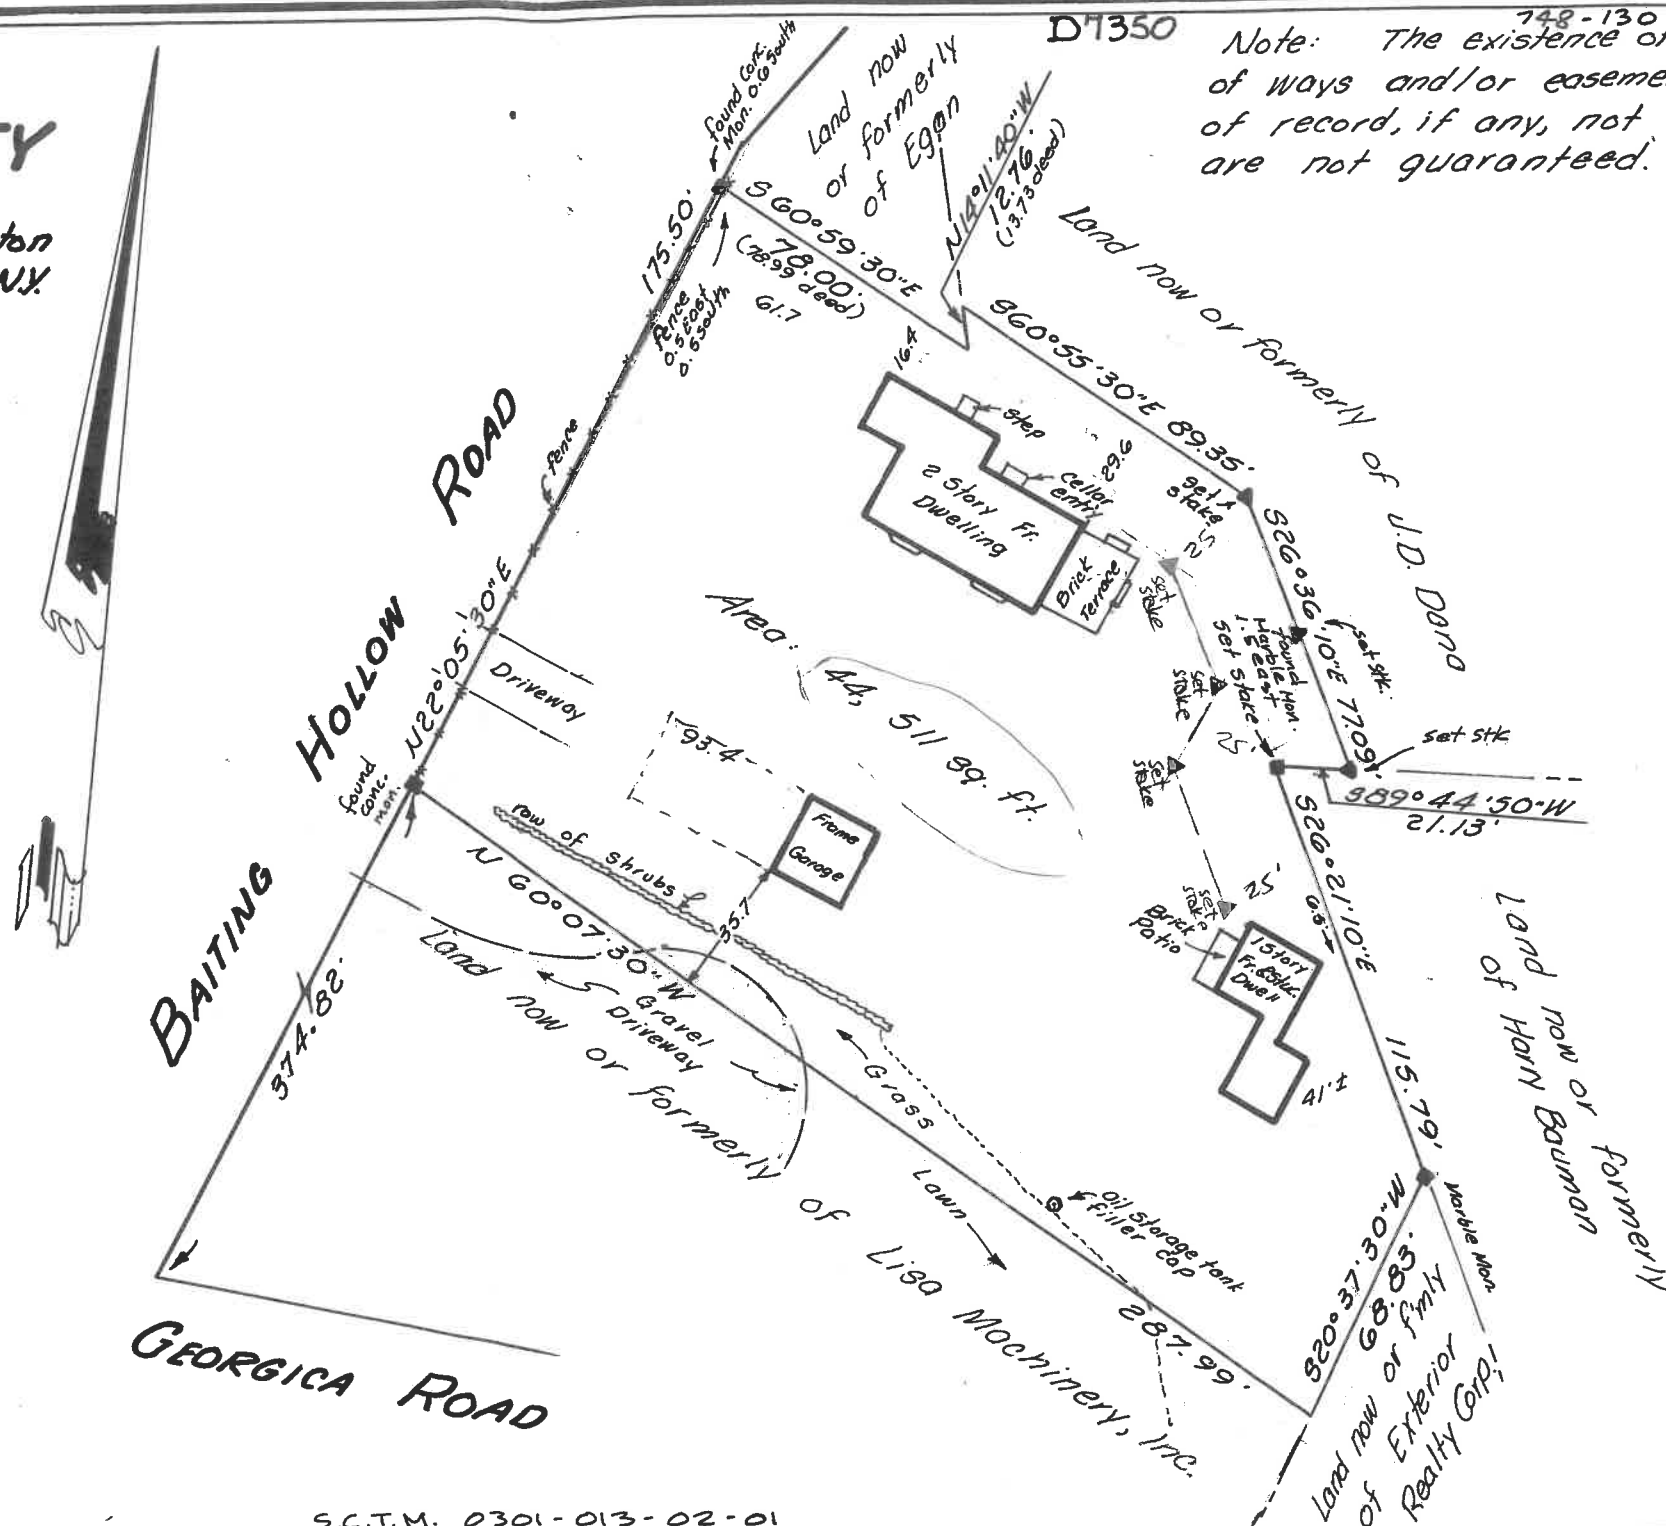

GEORGE H. WALBRIDGE CO.
Land Surveyors & Land Planners
East Hampton, New York

S.C.T.M. 0301-013-02-01