


MAP OF LOT 9
AND
UNDERWATER LAND
Indian Rills


Filed August 29, 1977 as Map no. 6595
MONTAUK, TOWN OF EAST HAMPTON
SUFFOLK COUNTY, N.Y.

SCALE: 1"=50'
TAX MAP REF: 0300-07-03-09
0300-07-02-9.7

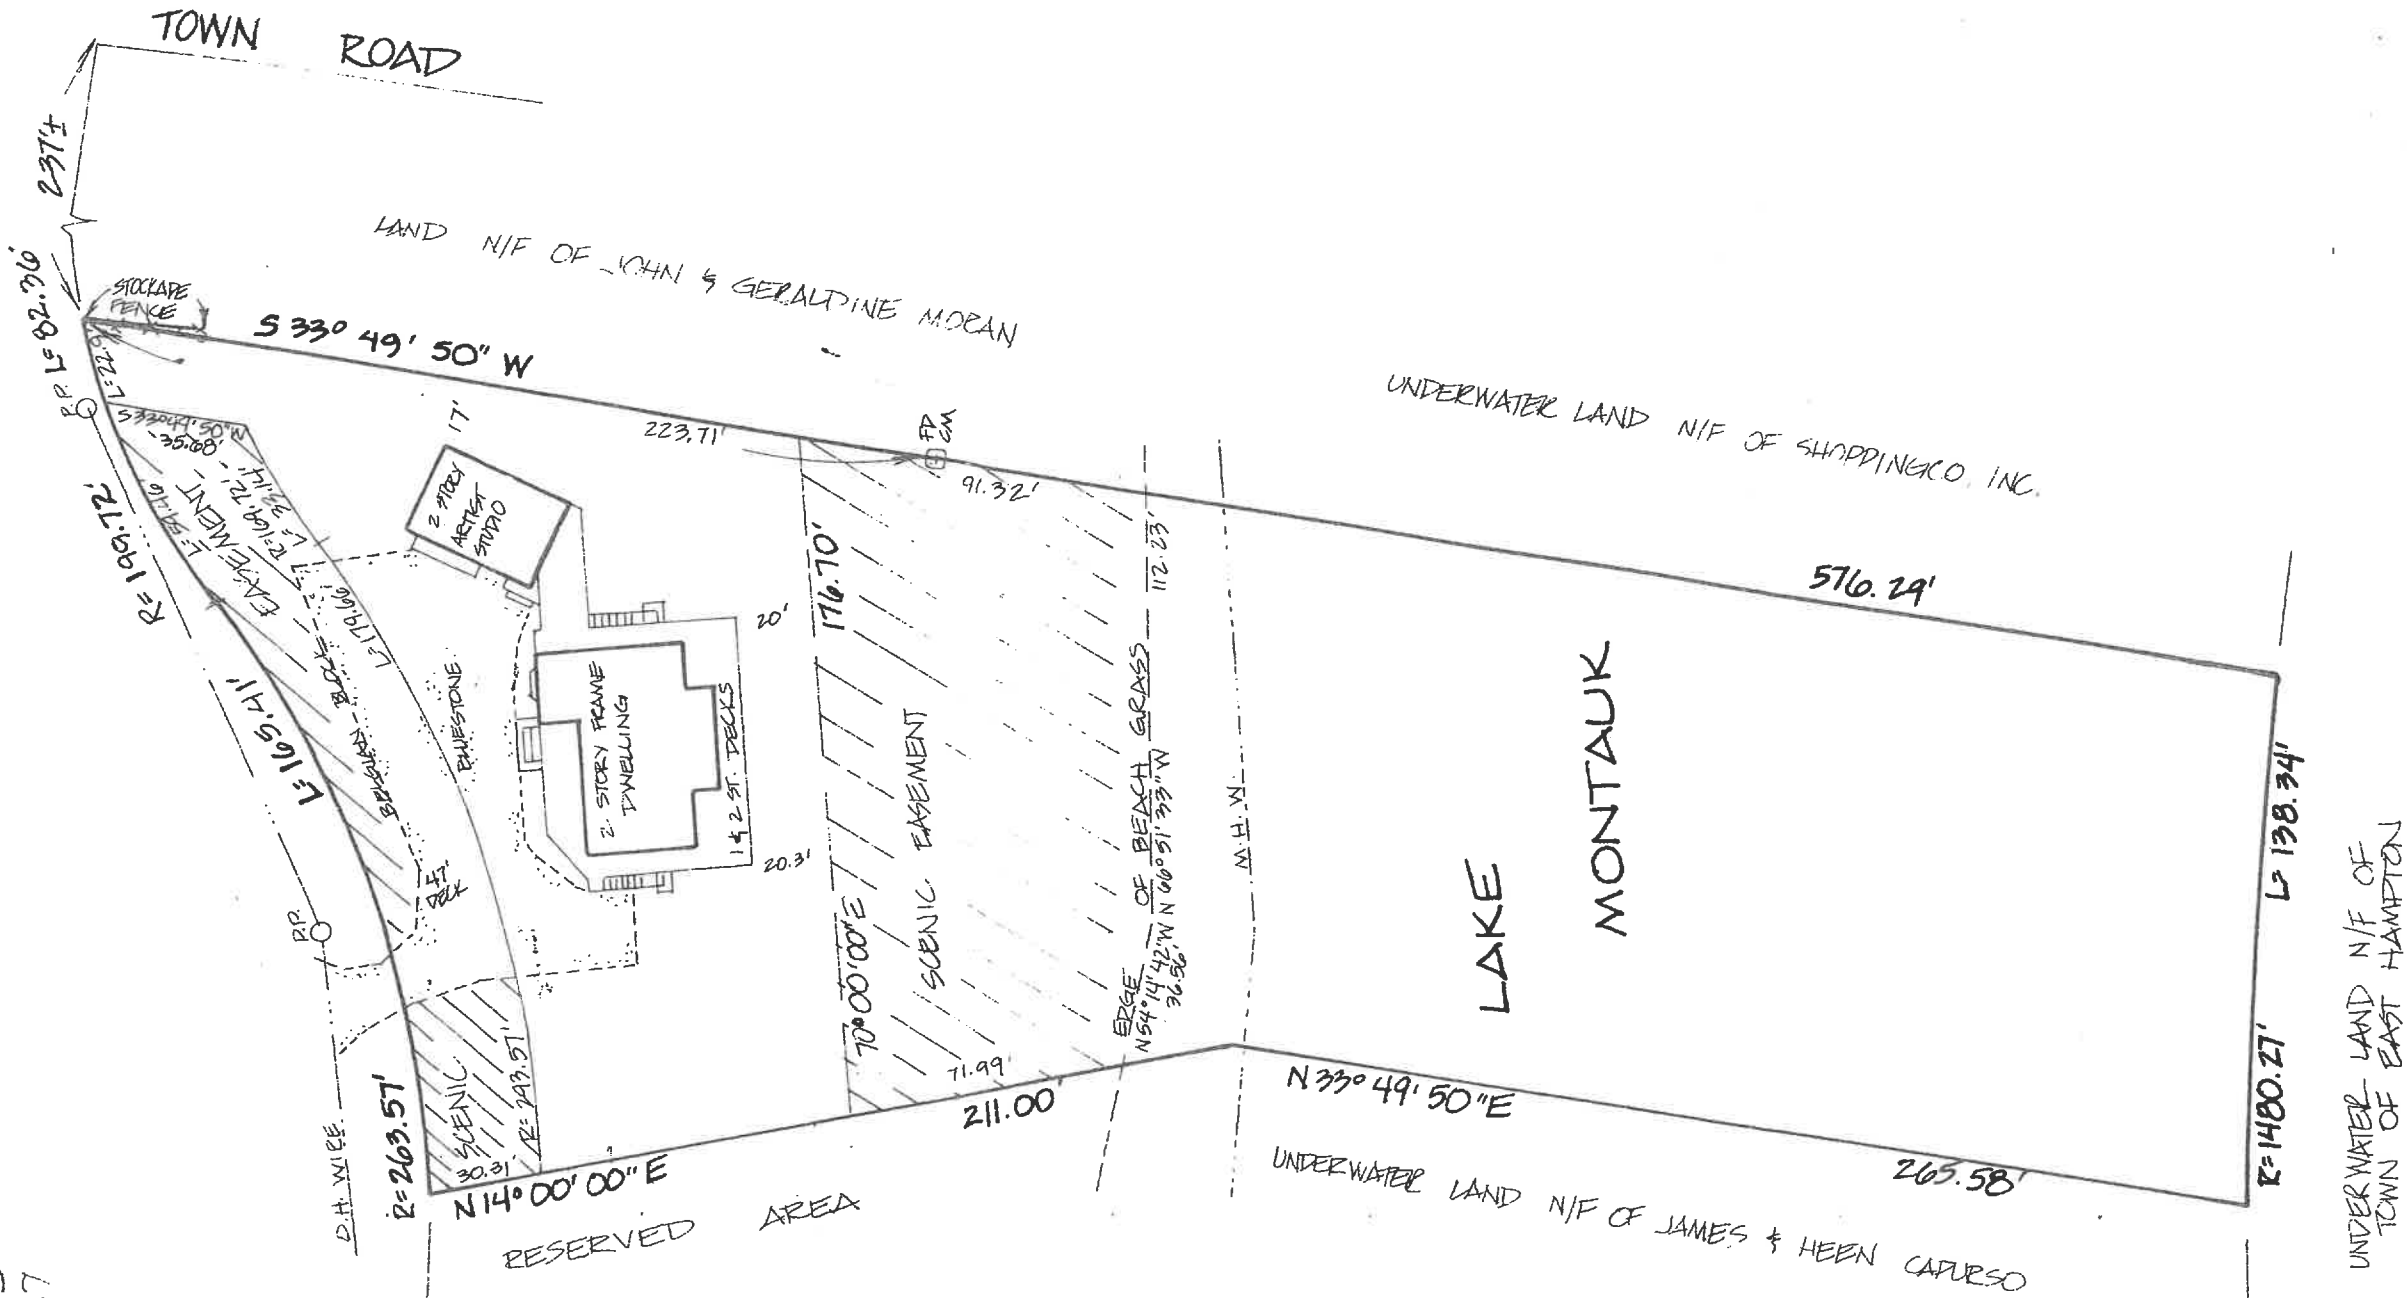

EASEMENTS, RIGHT OF WAYS
UNDERGROUND UTILITIES AND/OR
SANITARY FACILITIES NOT VISIBLE
AT THE TIME OF SURVEY HAVE NOT
BEEN SHOWN, LOCATED AND/OR
GUARANTEED

GUARANTEES OR WARRANTIES INDICATED ON
HALL RUN ONLY TO THE TOWN OR WHO THE SURVEY
IS PREPARED, & ON HIS BEHALF TO THE TITLE
COMPANY GOVERNMENTAL AGENCY & LENDING
INSTITUTIONS LISTED HEREON & TO THE ASSIGNEES
OF THE LENDING INSTITUTION, GUARANTEES OR
CERTIFICATIONS ARE NOT TRANSFERABLE TO
ADDITIONS OR SUCCESSION OWNERS.

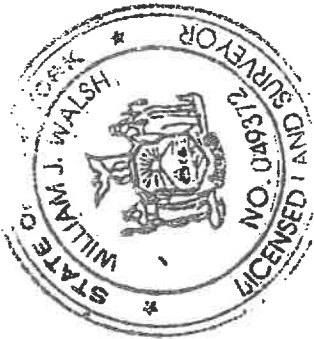

SURVEYED OCTOBER 24, 2000

WILLIAM J. WALSH,
LAND SURVEYOR
MONTAUK, N.Y.

William J. Walsh 25