


RED DASHED LINE:
PRINCIPAL BUILDING
ENVELOP. CONFIRM
PLEASE.

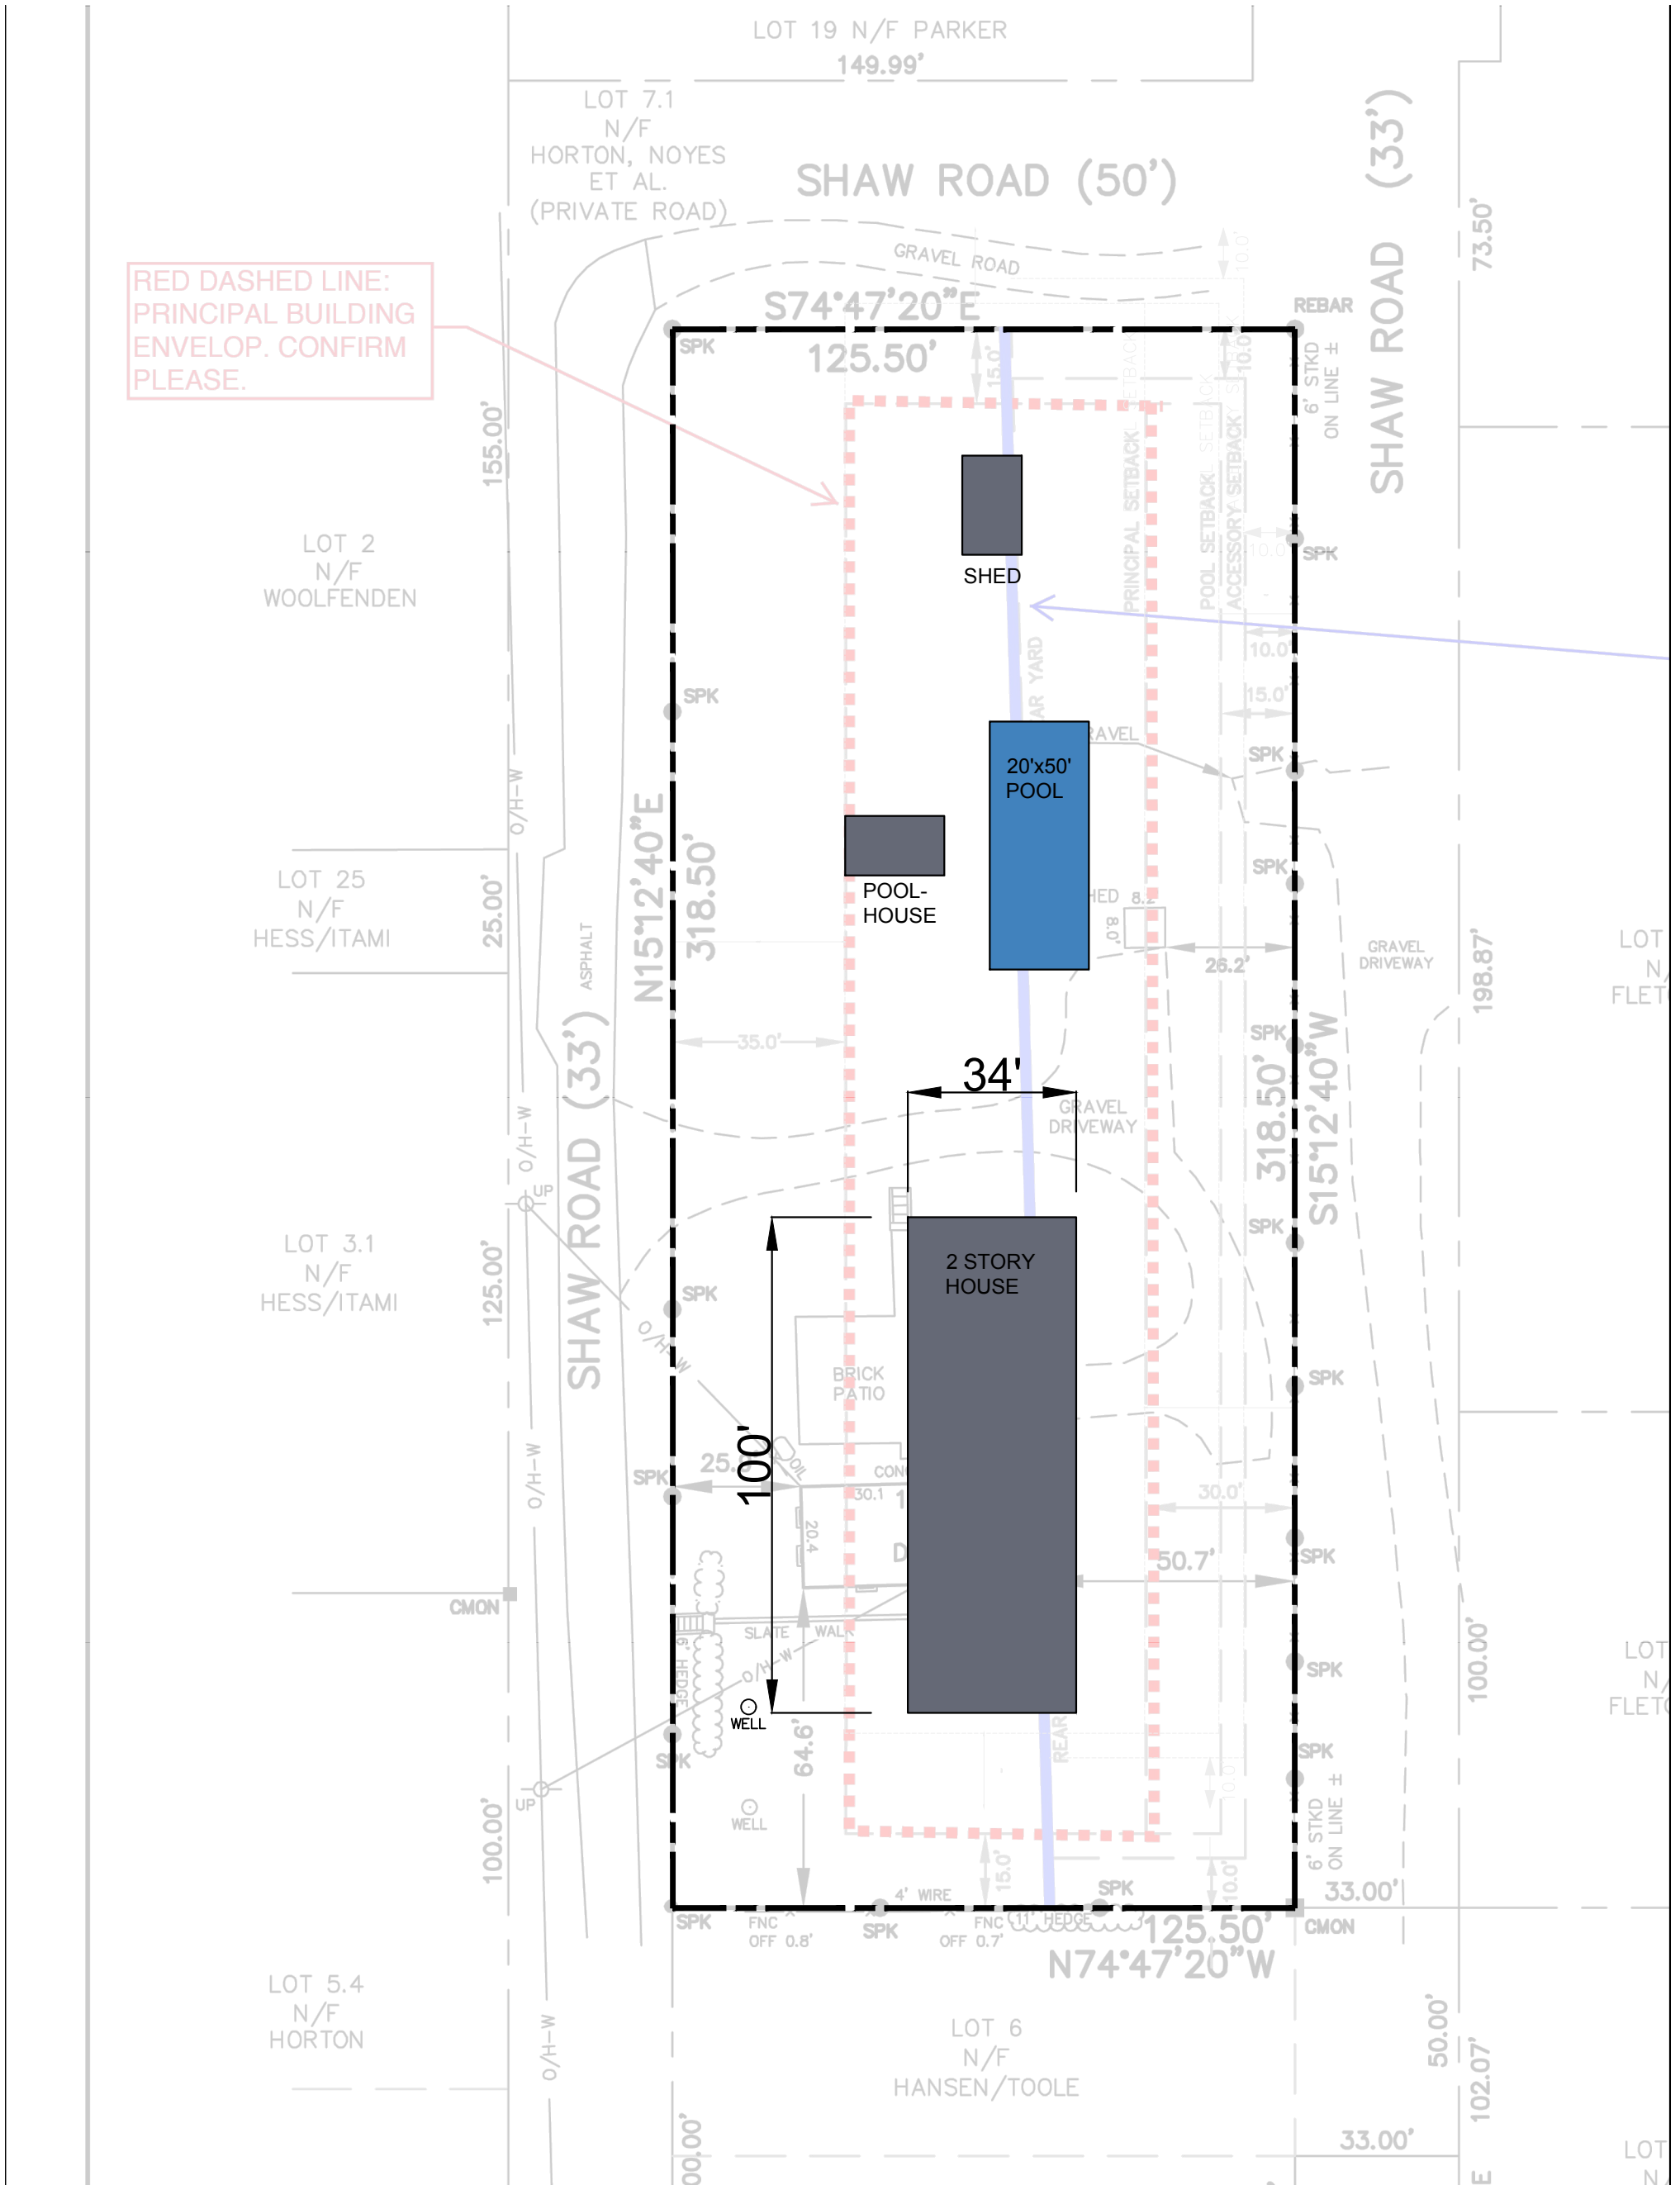

PROJECT NAME:

ARCHITECT:

SHEET TITLE:

DATE:
6/17/22

**A-101
SURVEY
with
BUILDING
AREA**

SCALE:
1" = 32':

OWNER:

DRAWN BY:
MB TEAM

SURVEY BY:
MICHAEL HEMMER, LS