


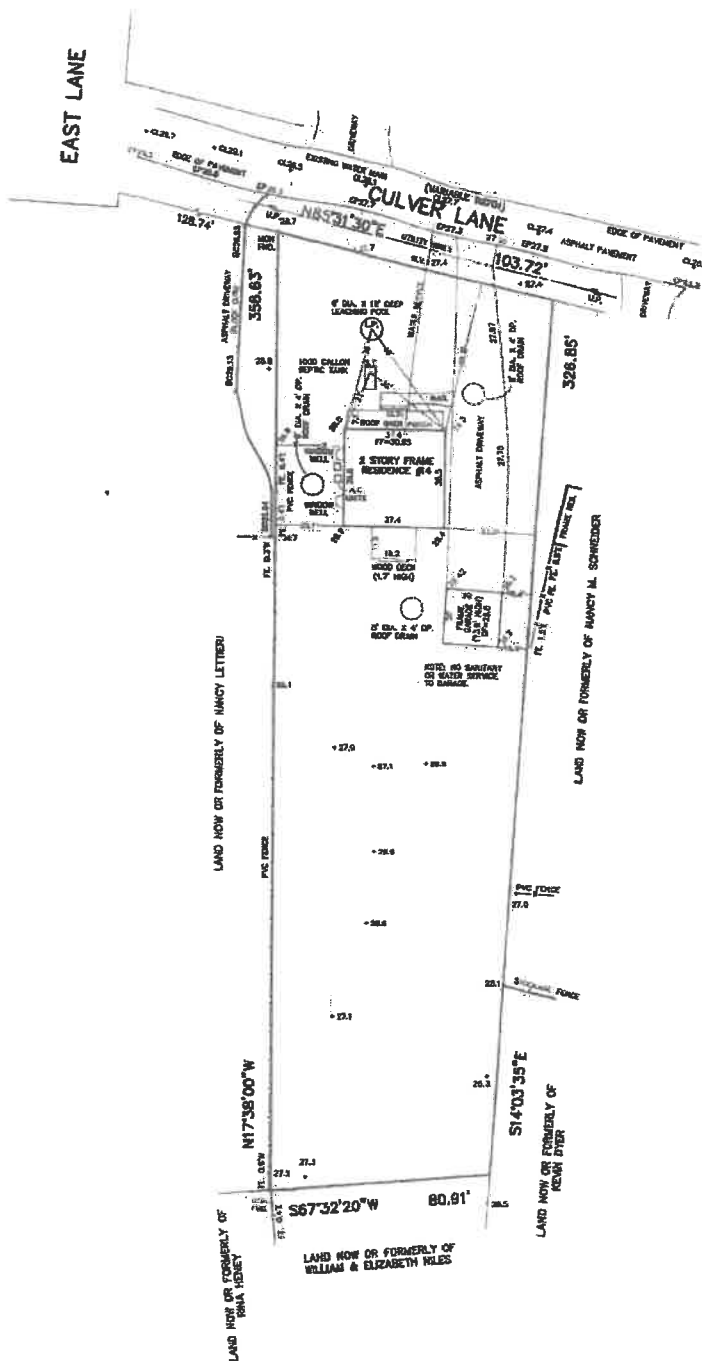

CERTIFIED TO:
 -MATTHEW RAVENHILL
 -GEORGETTE RAVENHILL
 -TELLUS ABSTRACT, INC.
 -STEWART TITLE INSURANCE
 COMPANY
 -WELLS FARGO HOME MORTGAGE,
 ITS SUCCESSORS AND/OR
 ASSIGNS AS THEIR INTERESTS
 MAY APPEAR





Boone A. Murrell

MAP OF
 DESCRIBED PROPERTY
 SITUATE
 EAST MORICHES
 TOWN OF BROOKHAVEN, SUFFOLK COUNTY N.Y.
 AREA = 31,090 SQ. FT.
 DATE: NOVEMBER 30, 2017 SCALE: 1"=30'
 REVISED PROPOSED RES.: 5/7/2018
 REVISED PER TOWN COMMENTS: 5/16/2018
 FINAL SURVEY: 2/11/2018

PREPARED BY
 SCHNEPF & MURRELL, P.C.
 LAND SURVEYORS - LAND PLANNERS
 120 MAIN STREET
 SAYVILLE, NEW YORK
 TEL. 631-589-1322 FAX 631-589-1778
 INFO@SCHNEPFANDMURRELL.COM

TAX MAP DESIGNATION NUMBER
 DISTRICT SECTION BLOCK LOT
 200 632 1 18.1