


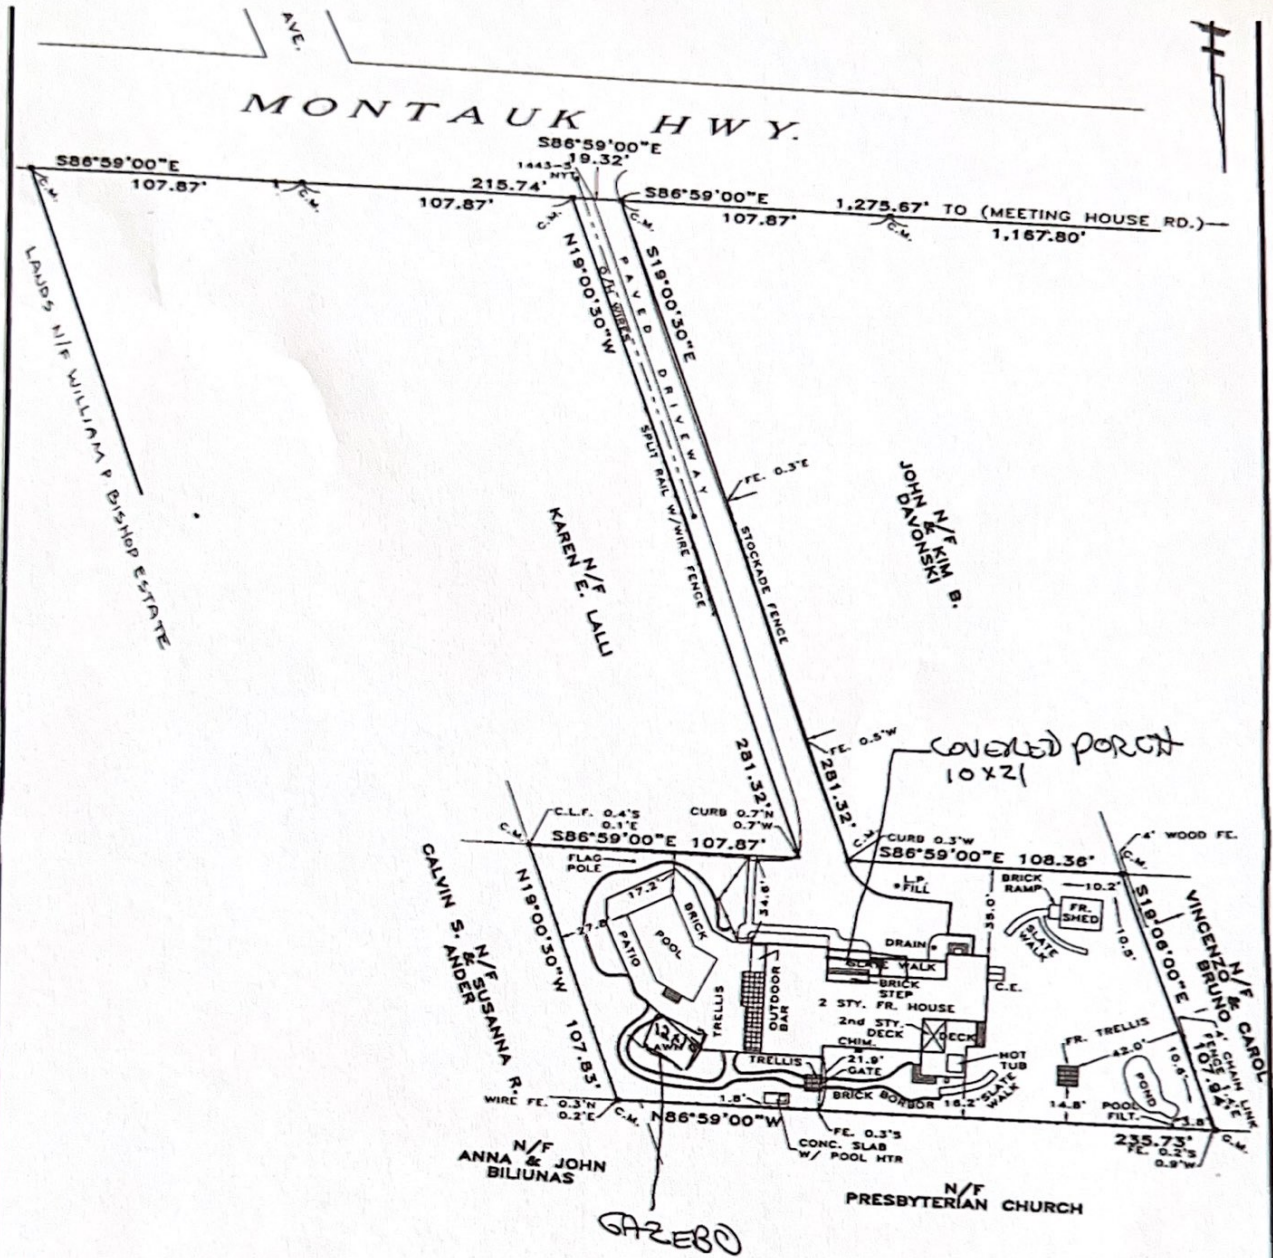

D-100-1

TAX	MAP
DISTRICT	0900
SECTION	370
BLOCK	03
LOT	18

MAP OF PROPERTY
FOR
JOHN HEATHER
SITUATE
QUIOGUE

UNAUTHORIZED ALTERATION OR ADDITION TO A SURVEY MAP BEARING A LICENSED LAND SURVEYOR'S SEAL IS A VIOLATION OF SECTION 7208, SUB-DIVISION 2, OF THE NEW YORK STATE EDUCATION LAW.

ONLY COPIES FROM THE ORIGINAL OF THIS SURVEY MARKED WITH AN ORIGINAL OF THE LAND SURVEYOR'S INKED SEAL OR EMBOSSED SEAL SHALL BE CONSIDERED TO BE VALID TRUE COPIES.

CERTIFICATIONS INDICATED HEREON SHALL RUN ONLY TO THE PERSON FOR WHOM THE SURVEY IS PREPARED, AND ON HIS BEHALF TO THE TITLE COMPANY, GOVERNMENTAL AGENCY AND LENDING INSTITUTION LISTED HEREON, AND TO THE ASSIGNEES OF THE LENDING INSTITUTION. CERTIFICATIONS ARE NOT TRANSFERABLE TO ADDITIONAL INSTITUTIONS OR SUBSEQUENT OWNERS.

TOWN OF SOUTHAMPTON - SUFFOLK COUNTY, N.Y.
SURVEYED: SEPT. 16, 1977 - SCALE: 1" INCH = 50' FT.
FINAL: MAY 2, 1978
LOCATE CORNERS & SET CONC. MON'S.: MAR. 12, 1987
REDATE: DEC. 12, 1988
AMEND (ADD) TIE: APR. 20, 1993
REDATE: JAN. 29, 2002

RAYNOR & MARCKS
SURVEYING & ENGINEERING P.C.
QUOGUE, N.Y.
631-653-4066

515 MONTAUK HIGHWAY
AREA: 28,599 SQ. FT.
BK:183 PG:66,67,68

CERTIFIED TO:
JOHN HEATHER
NORTH FORK BANK
PECONIC ABSTRACT

D42-C-49
DRAWN BY: M.V.C.
(ARCHIV38 HEATHER)