


TAX MAP NO. 900-345-02-11
AREA 39,728 S.F.
ZONE R-40

Note: Interior Fences
are not shown.

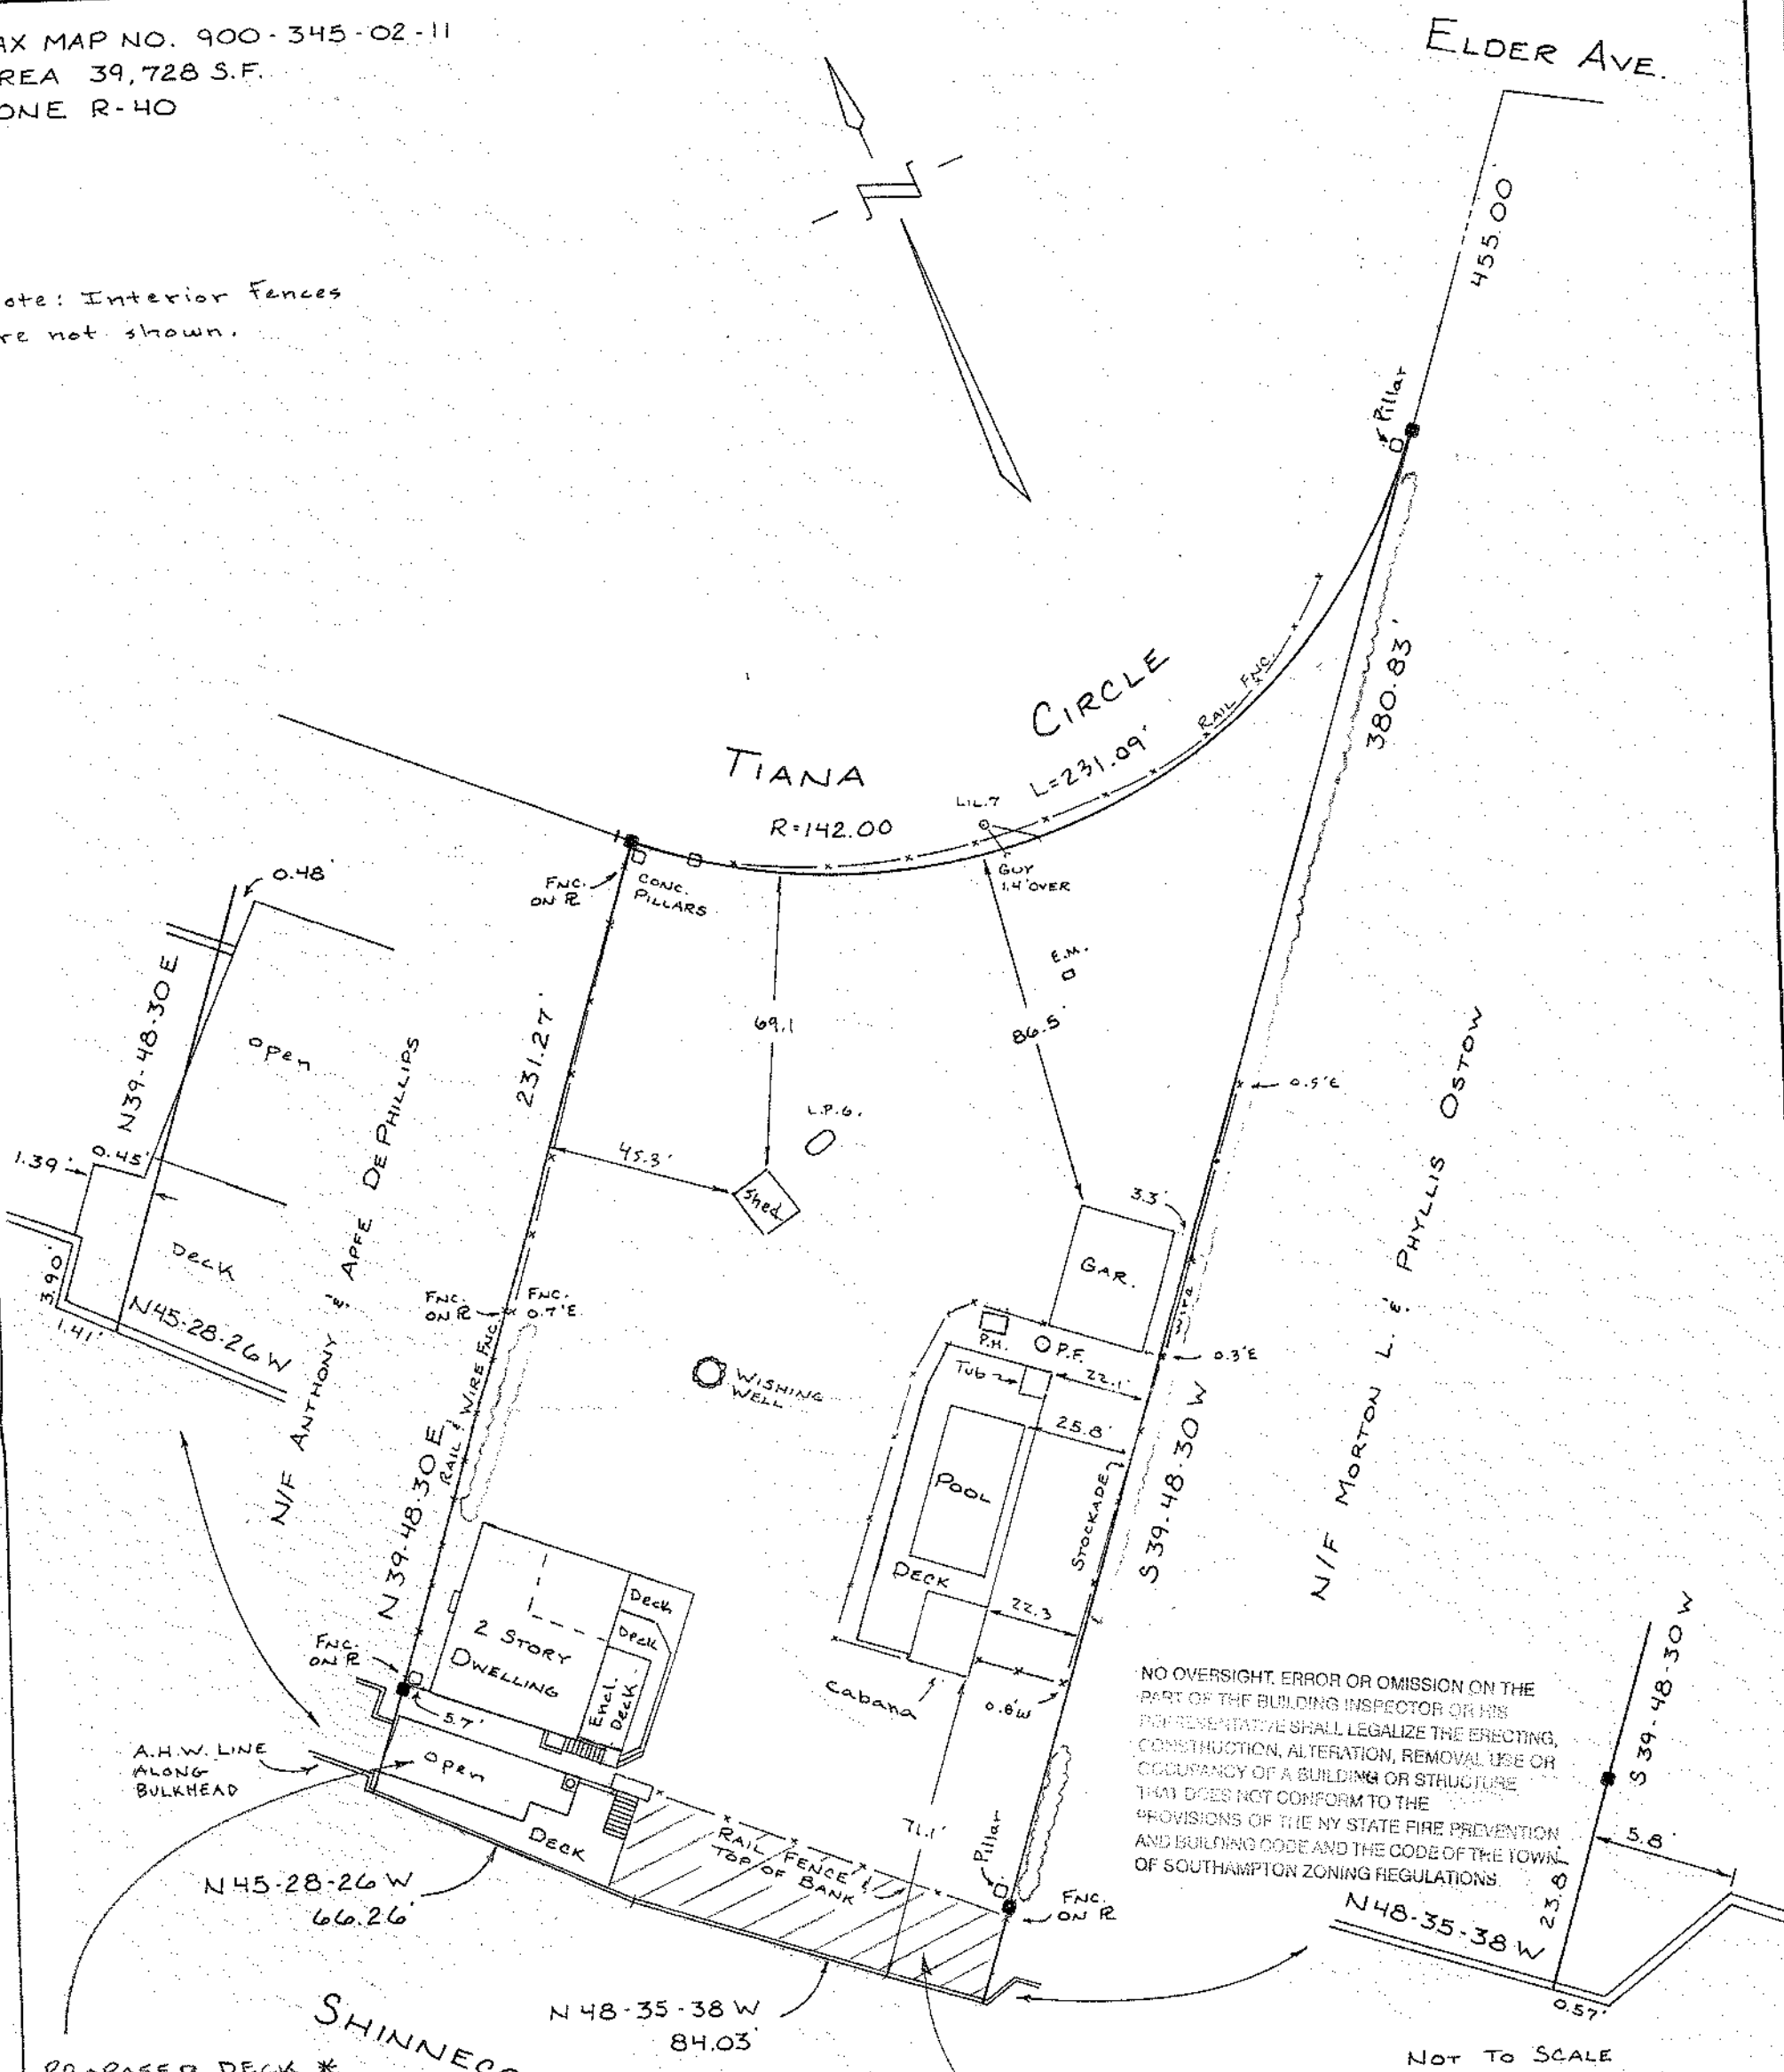

PROPOSED DECK *
IN "OPEN" AREA
(FORMER COTTAGE)
535 S.F.


* NON-TREATED LUMBER

SURVEY OF PROPERTY
SITUATE

TIANA CIRCLE
HAMPTON BAYS

TOWN OF SOUTHAMPTON
SUFFOLK COUNTY, NEW YORK

CERTIFIED TO:
HENRIETTE J. KILIAN

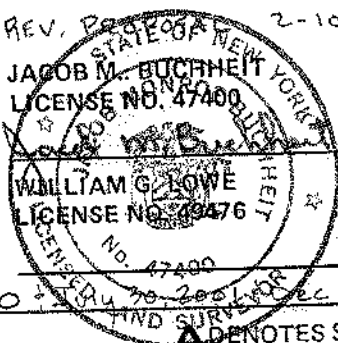

PROPOSED NON-DISTURBANCE,
NON-FERTILIZATION BUFFER.

UNAUTHORIZED ALTERATION OR ADDITION TO
THIS SURVEY IS A VIOLATION OF SECTION
7308 OF THE NEW YORK STATE EDUCATION
LAW.
COPIES OF THIS SURVEY MAP NOT BEARING
THIS LAND SURVEYOR'S INKED SEAL OR EM-
BOSSED SEAL SHALL NOT BE CONSIDERED TO
BE A VALID TRUE COPY.
GUARANTEES INDICATED HEREON SHALL RUN
ONLY TO THE PERSON FOR WHOM THE SURVEY
IS PREPARED AND ON HIS BEHALF TO THE
TITLE COMPANY, GOVERNMENTAL AGENCY AND
LENDING INSTITUTION LISTED HEREON AND
TO THE ASSIGNEES OF THE LENDING INSTITU-
TION. GUARANTEES ARE NOT TRANSFERABLE
TO ADDITIONAL INSTITUTIONS OR SUBSEQUENT
OWNERS.
R.O.W. EASEMENTS, AND UNDERGROUND UTIL-
ITIES WHETHER ABANDONED OR IN USE UNLESS
OTHERWISE NOTED ARE NOT SHOWN ON THIS
SURVEY.

DOLLIVER ASSOCIATES
LAND SURVEYORS
HAMPTON BAYS, N. Y.

235 66
189 35
BK 151 PG 57-59

PREPARED 1-26-90 SURVEYED JAN. 16, 1990
SCALE 1" = 40' DENOTES MONUMENTS DENOTES STAKES