


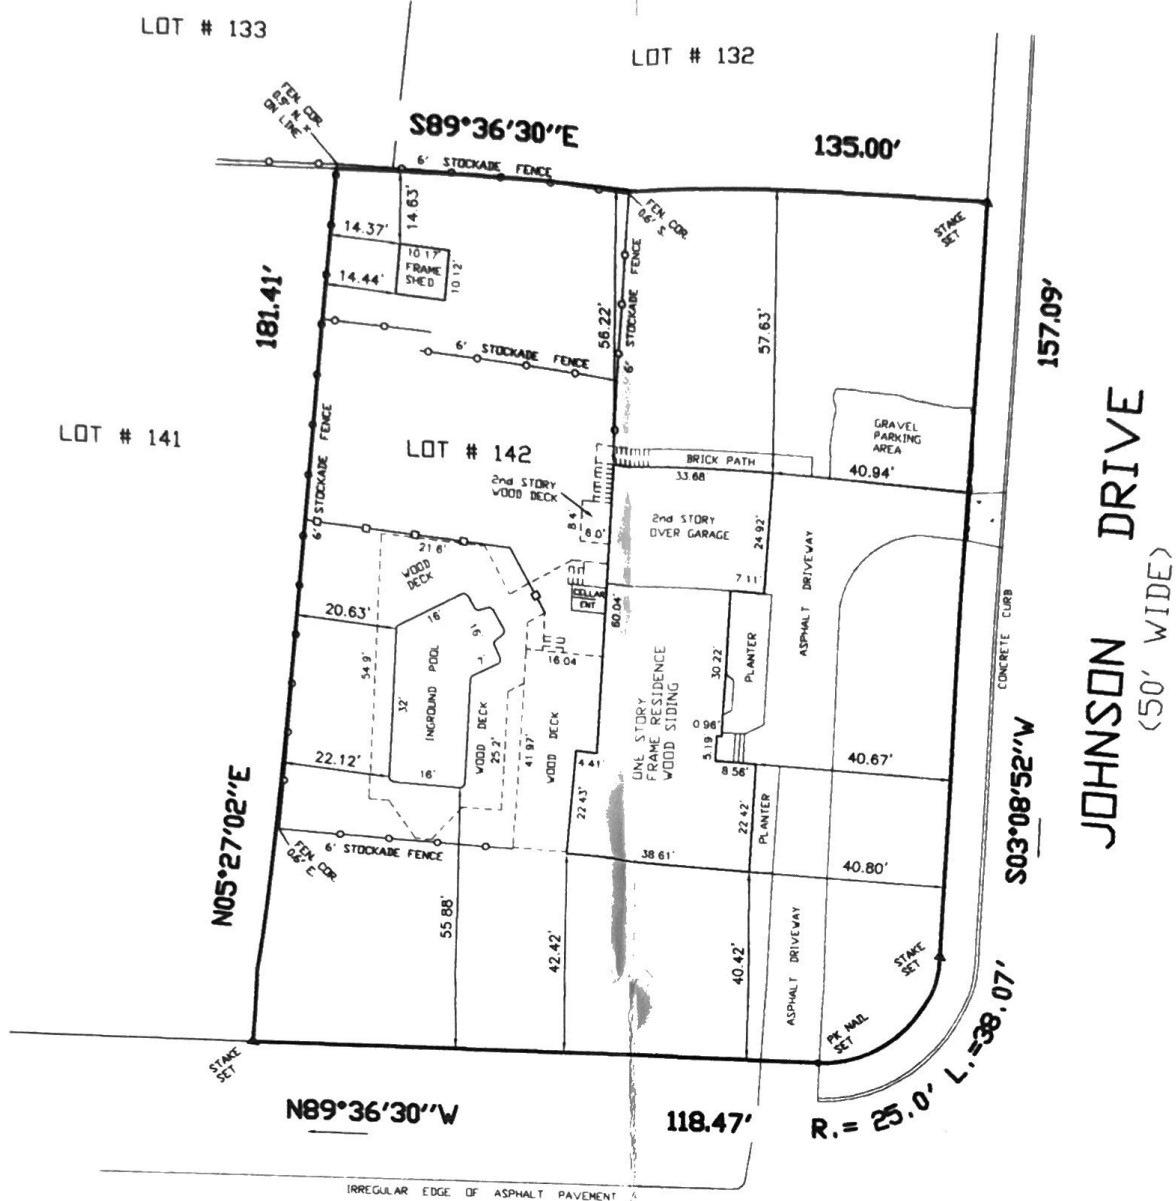

HEAD OF LOTS ROAD
(66' WIDE)

GUARANTEED TO: ANNA K. VANDERSLICE
& TO: COMMONWEALTH LAND TITLE INSURANCE COMPANY
& TO: CHASE MANHATTAN MORTGAGE



PARCEL AREA = 24,934.57 SQUARE FEET

A	07-29-03	OUTLINE SURVEY
REV.	DATE	DESCRIPTION

UNAUTHORIZED ALTERATION OR ADDITION TO THIS SURVEY IS A VIOLATION OF SECTION 7209 OF THE NEW YORK STATE EDUCATION LAW. COPIES OF THIS SURVEY MAP NOT BEARING THE SURVEYOR'S INKED SEAL OR EMBOSSED SEAL SHALL NOT BE CONSIDERED A VALID TRUE COPY. GUARANTEES INDICATED HEREON SHALL RUN ONLY TO THE PERSON FOR WHOM THE SURVEY IS PREPARED, AND ON HIS BEHALF TO THE TITLE COMPANY, GOVERNMENTAL AGENCY, OR LENDING INSTITUTION. GUARANTEES ARE NOT TRANSFERABLE TO ADDITIONAL INSTITUTIONS OR SUBSEQUENT OWNERS.

Surveyed by:
Francis X. Karl L.S.
27 Arthur Avenue
Blue Point, N.Y.
11715
(631) 363-2891 Phone
(631) 363-2892 Fax
Scale 1" = 30'

SUFFOLK COUNTY TAX MAP
DISTRICT 0900
SECTION 318.00
BLOCK 03.00
LOT 039.058
DRAWING NAME: 8JOHNS2K.DWG
FILE NAME: 8JOHNS.ASC

LOT # 142
ON THE MAP OF
"BAY ESTATES - SECTION THREE"
FILED MAP # 6429 - FILED AUGUST 19, 1976
SITUATED AT:
EAST QUOGUE,
TOWN OF SOUTHAMPTON,
SUFFOLK COUNTY, NY