


now or formerly Joseph C. Musnicki, Jr.

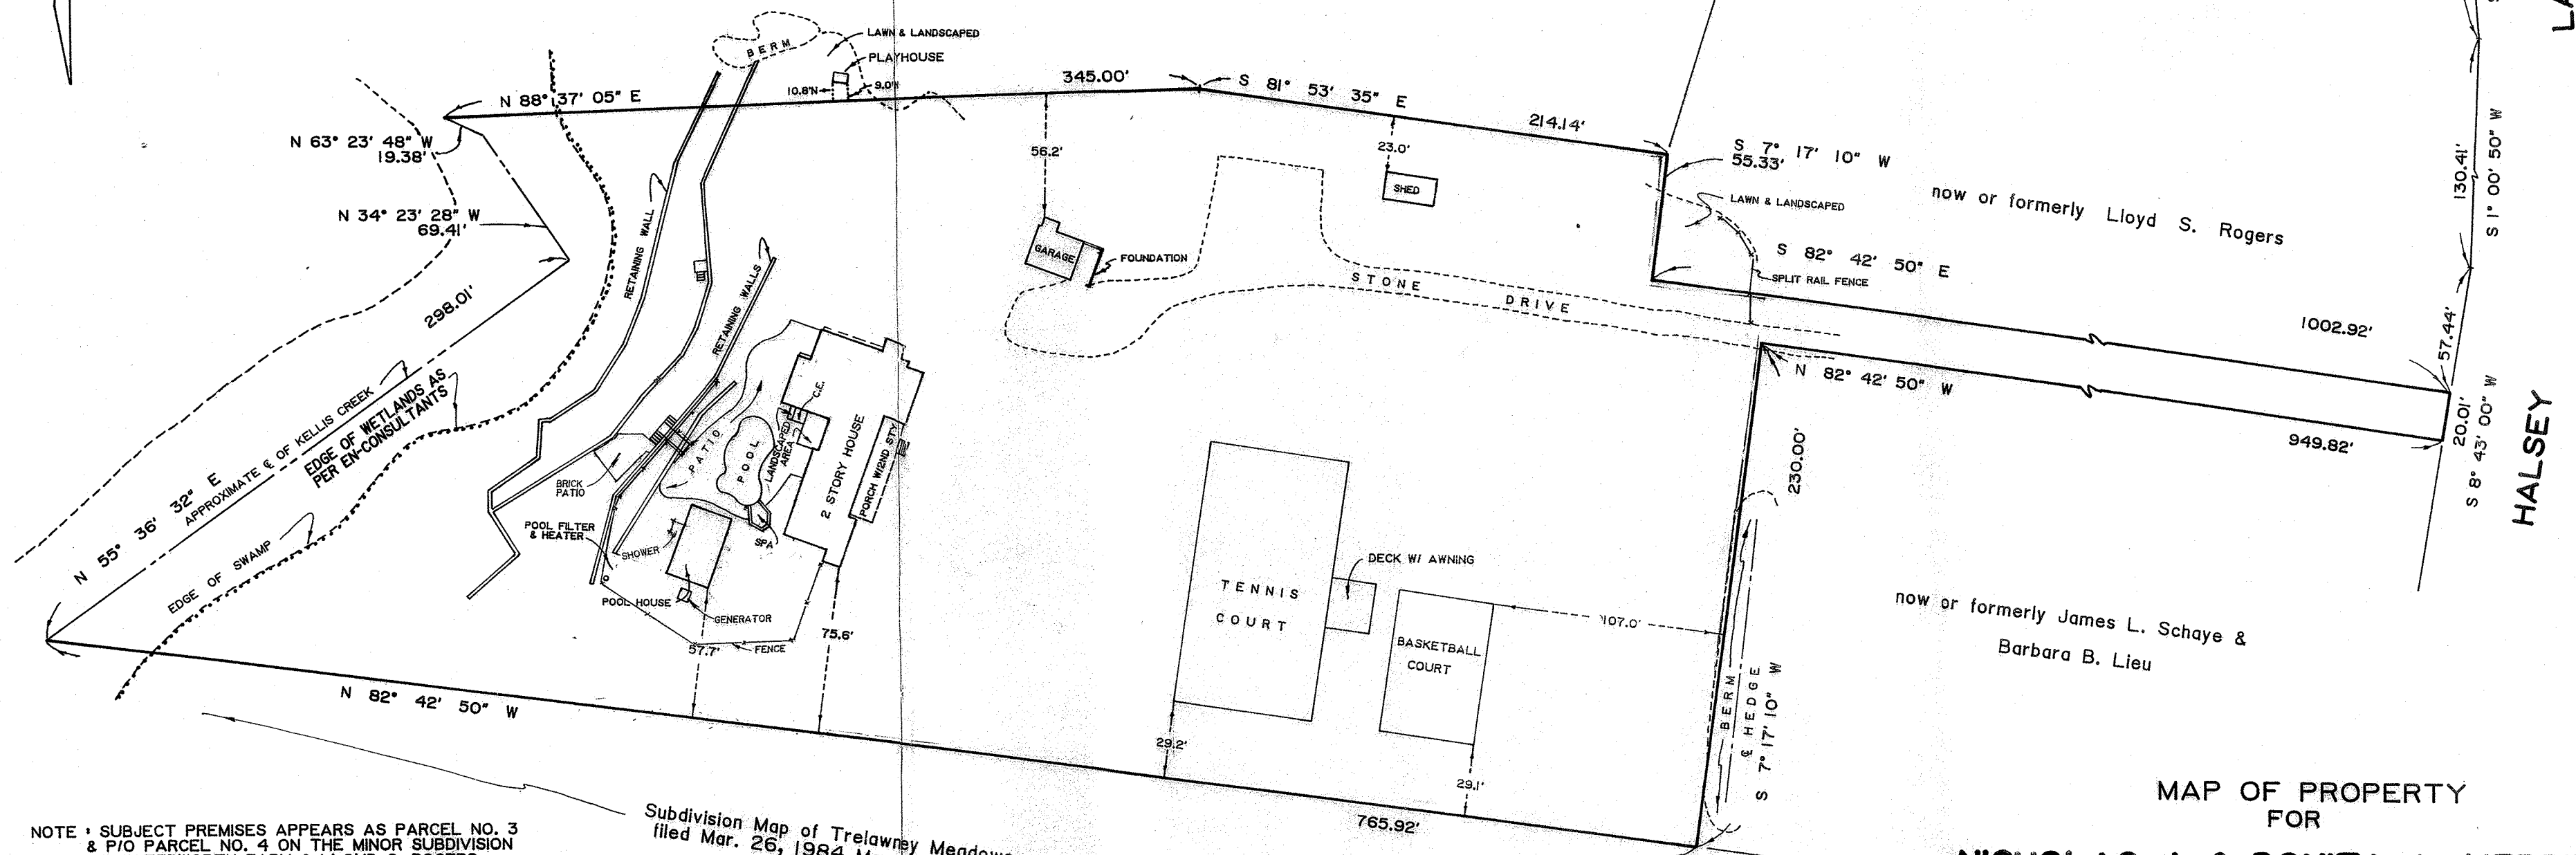

NOTE: SUBJECT PREMISES APPEARS AS PARCEL NO. 3 & P/O PARCEL NO. 4 ON THE MINOR SUBDIVISION OF WATERWORTH FARM & LLOYD S. ROGERS.

Subdivision Map of Trelawney Meadows
filed Mar. 26, 1984 Map No. 7719

MAP OF PROPERTY
FOR
NICHOLAS J. & BONITA A. VERBITSKY
SITUATE

BRIDGEHAMPTON
TOWN OF SOUTHAMPTON
SUFFOLK COUNTY, N.Y.
AREA = 4.620 ACRES
SCALE 1" = 60'

SQUIRES, HOLDEN, WEISENBACHER & SMITH
LAND SURVEYORS ENGINEERS
SOUTHAMPTON, NEW YORK

SUFFOLK COUNTY TAX MAP
DISTRICT 0900
SECTION 085.00
BLOCK 02.00
PARCEL 018.010