

641-42  
1000 - 116-119


DC 13181  
L203

# **MAP OF PROPERTY** **PART OF LOTS 19 & 20** **A.H. LARKIN ESQ.**

Filed: August 12, 1911 - Map No. 395  
SITUATE

INCORPORATED VILLAGE OF EAST HAMPTON  
Town of East Hampton, Suffolk Co., N.Y.  
Area: 66,361 S.F. or 1.523 Acres  
Village Area: 40,622 S.F. or 0.933 Acres  
Town Area: 25,719 S.F. or 0.590 Acres

Certified To:  
James T. Penny

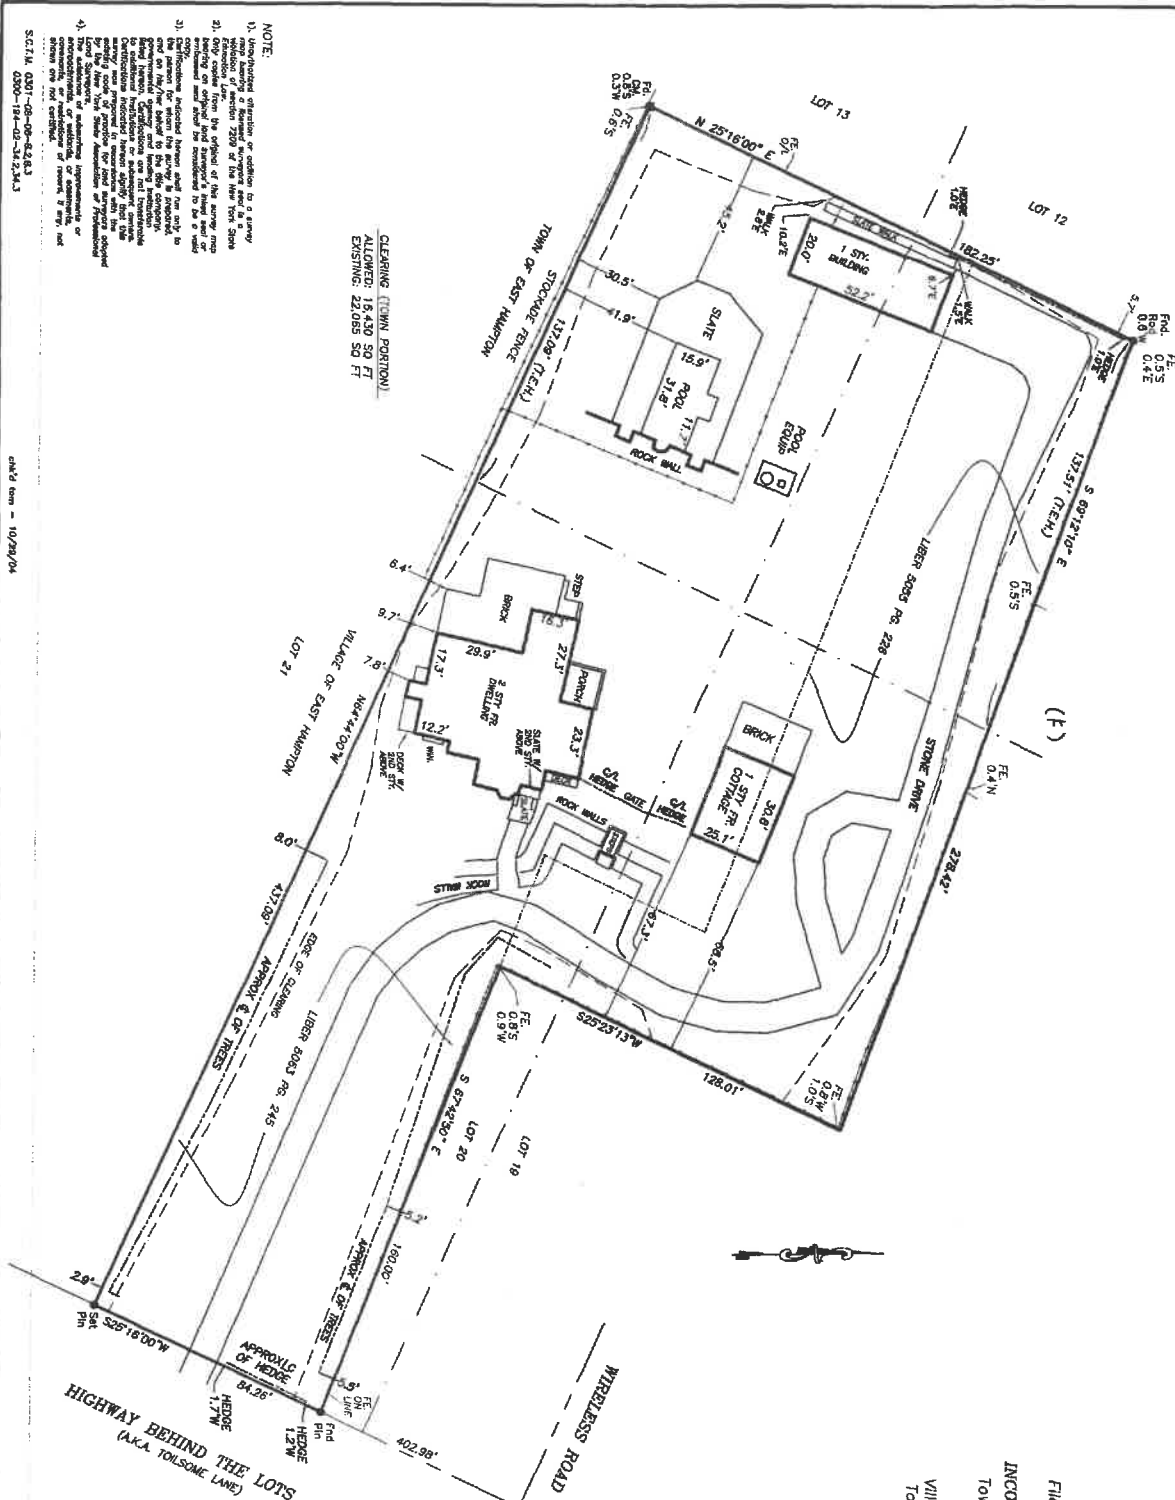

**GEORGE WALBRIDGE SURVEYORS, P.C.**  
Land Surveyors & Land Planners  
300 Peconic Place - Suite 116  
East Hampton, Long Island, N.Y. 11937  
Phone: (631) 324-0412 Fax: (631) 324-9849  
E-mail: gwsurvey@aol.com

Revised: May 2, 2006 - Update  
Surveyed: September 13, 2004

c:\land projects-grg\penny-james\long survey-5-2-06

DC 13181