


PROPERTY LOCATED NORTH OF BRIDGEHAMPTON
TOWN OF SOUTHAMPTON
SUFFOLK COUNTY, NEW YORK
S.C.T.N. # 988-837-BI-2.4
AREA = 41.883 SF = 0.9558 AC
SCALE: 1"=48'

NOTE: THE EXISTENCE OF RIGHT OF WAYS,
WETLANDS AND/OR EASEMENTS OF RECORD
IF ANY, NOT SHOWN ARE NOT GUARANTEED.

LOPERS PATH

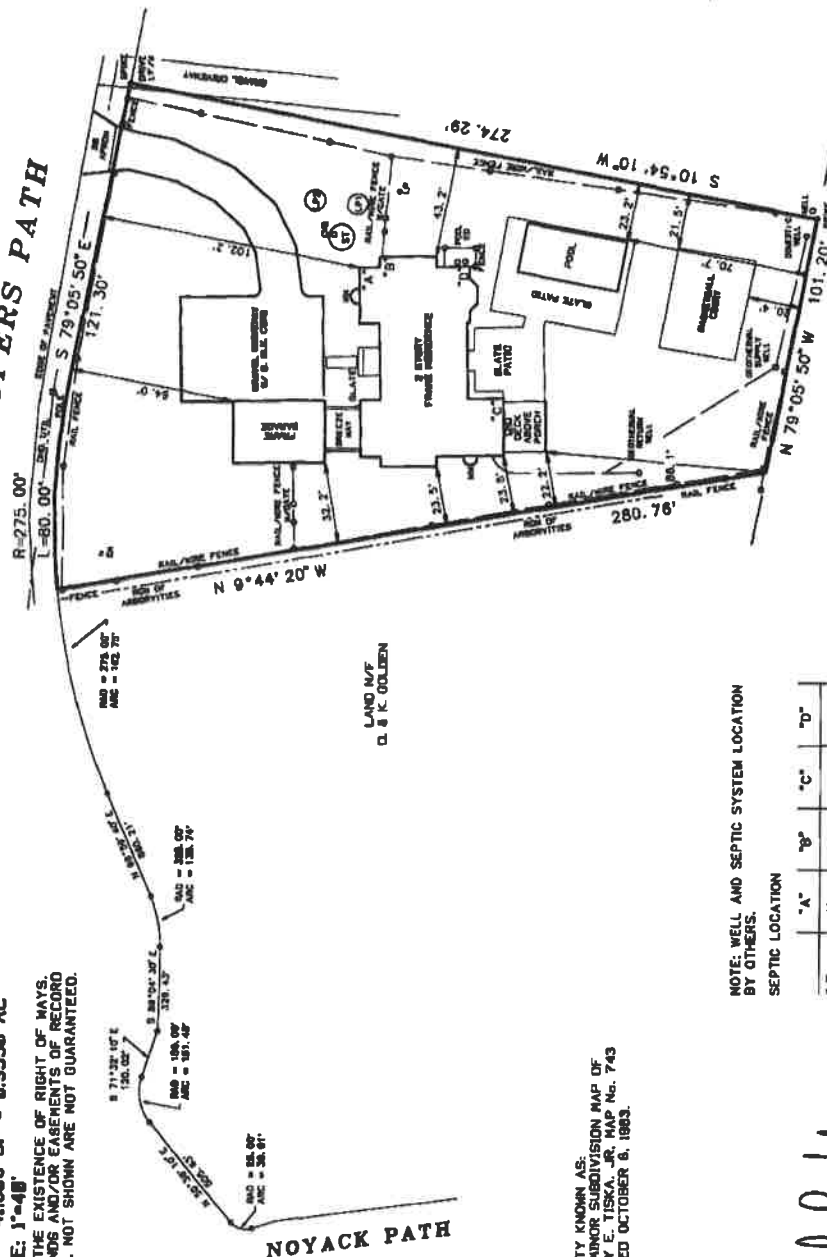

LAND M/F

LAND M/F
V. DELING

PROPERTY KNOWN AS:
LOT 2, MINOR SUBDIVISION MAP OF
APPROVED OCTOBER 8, 1983.

NOTE: WELL AND SEPTIC SYSTEM LOCATION
BY OTHERS.

SEPTIC LOCATION

	"A"	"B"	"C"	"D"
S.T.	18	20		
L.P. 1	24	22		
L.P. 2	30	32		
WELL			134	132

John B. Biele

22573-5993 (22573-3)



1
2
