

D 1282

MT. WIND. TOWN. SUFF. CO. NY

D 7323

Map Of Property

Situate

Wainscott, Town of East Hampton
Suffolk County, N.Y.

Scale 1" = 50'

Guaranteed to
Evelyn B. Walker
Roger M. Walker
Pegasus Abstract, Inc.
The Bank of the Hamptons, N.A.

UNLESS SHOWN OTHERWISE ON ADDITION
TO THIS MAP, THE LOCATION OF
THE PROPERTY IS AS SHOWN ON THE
RECORD MAP.

NOTES: THIS SURVEY MAP NOT BEARING
THE LAND SURVEYOR'S SEAL OR
EMBOSSED SEAL SHALL BE CONSIDERED
AS A FALSIFIED COPY.

THIS SURVEY MAP IS NOT TRANSFERABLE
TO ANY OTHER TRANSACTION OR SUBSEQUENT
SURVEY.

GEORGE H. WALBRIDGE CO.


George H. Walbridge



Revised: Dec. 4, 1987 Add'n, Deck, Patio
Surveyed: Sept 13, 1977

George H. Walbridge Co.
Land Surveyors and Land Planners
East Hampton, N.Y.

0300-197-06-18

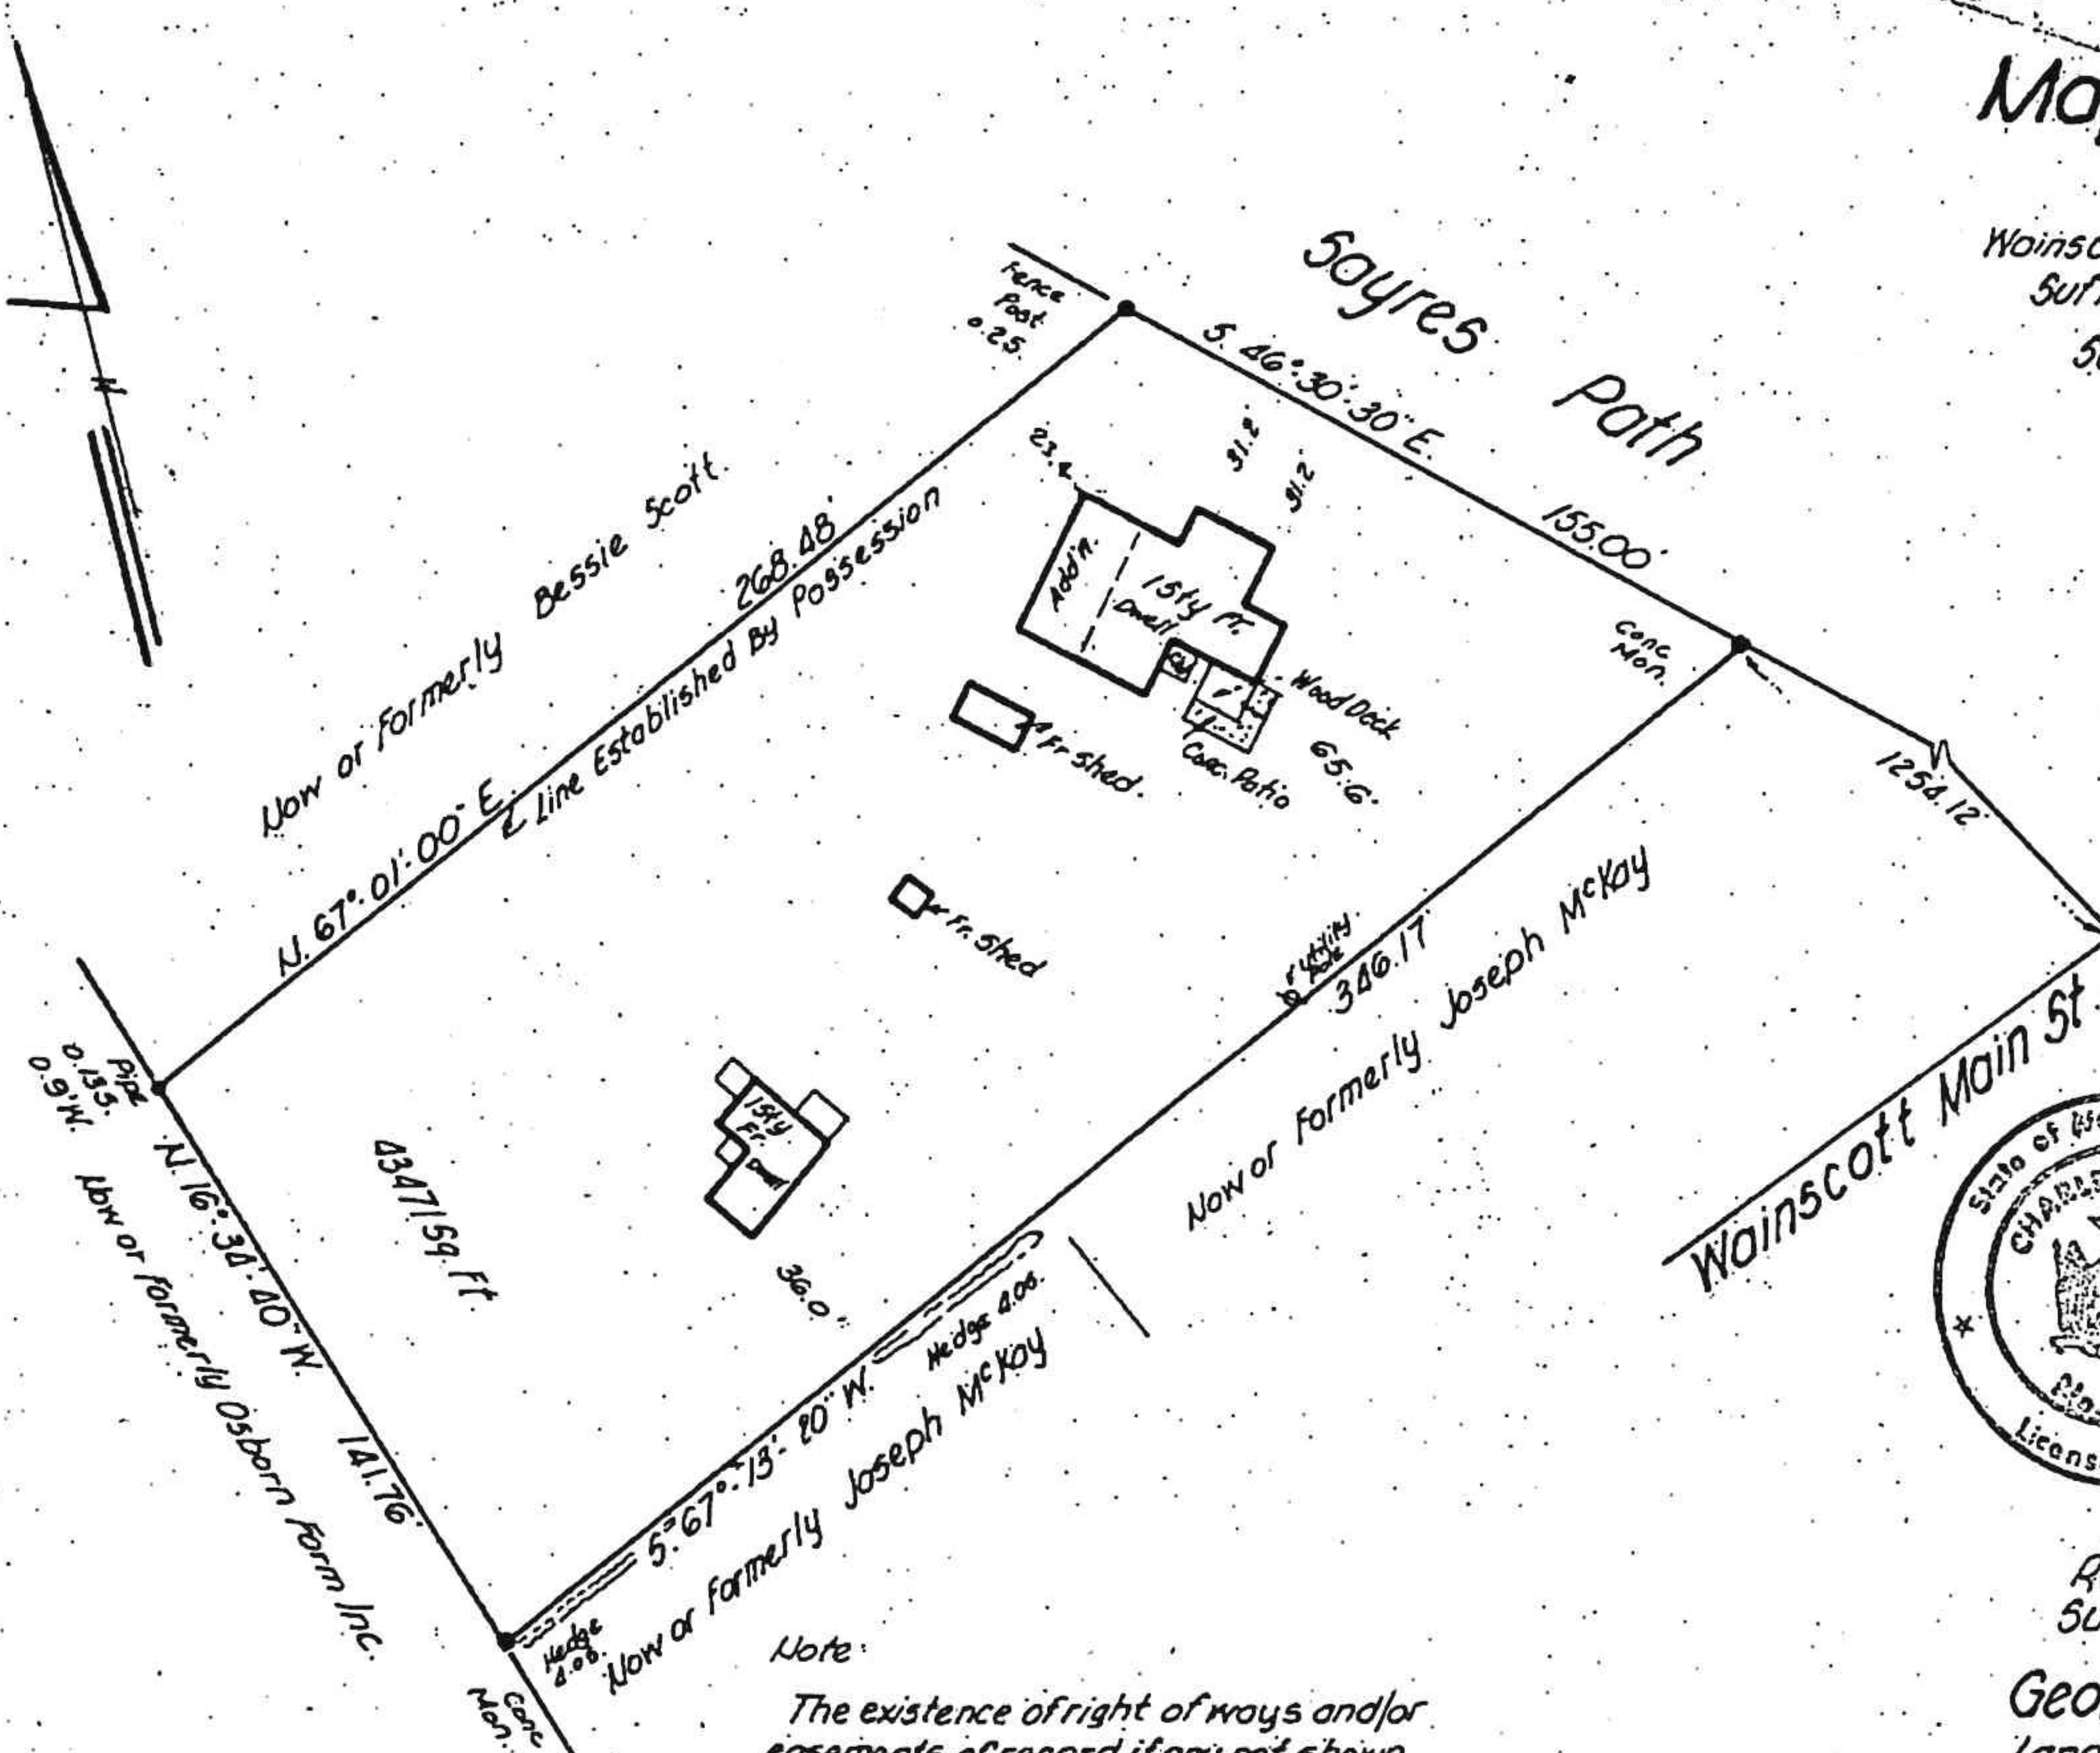

Note:

The existence of right of ways and/or
easements of record if any not shown
are not guaranteed.