


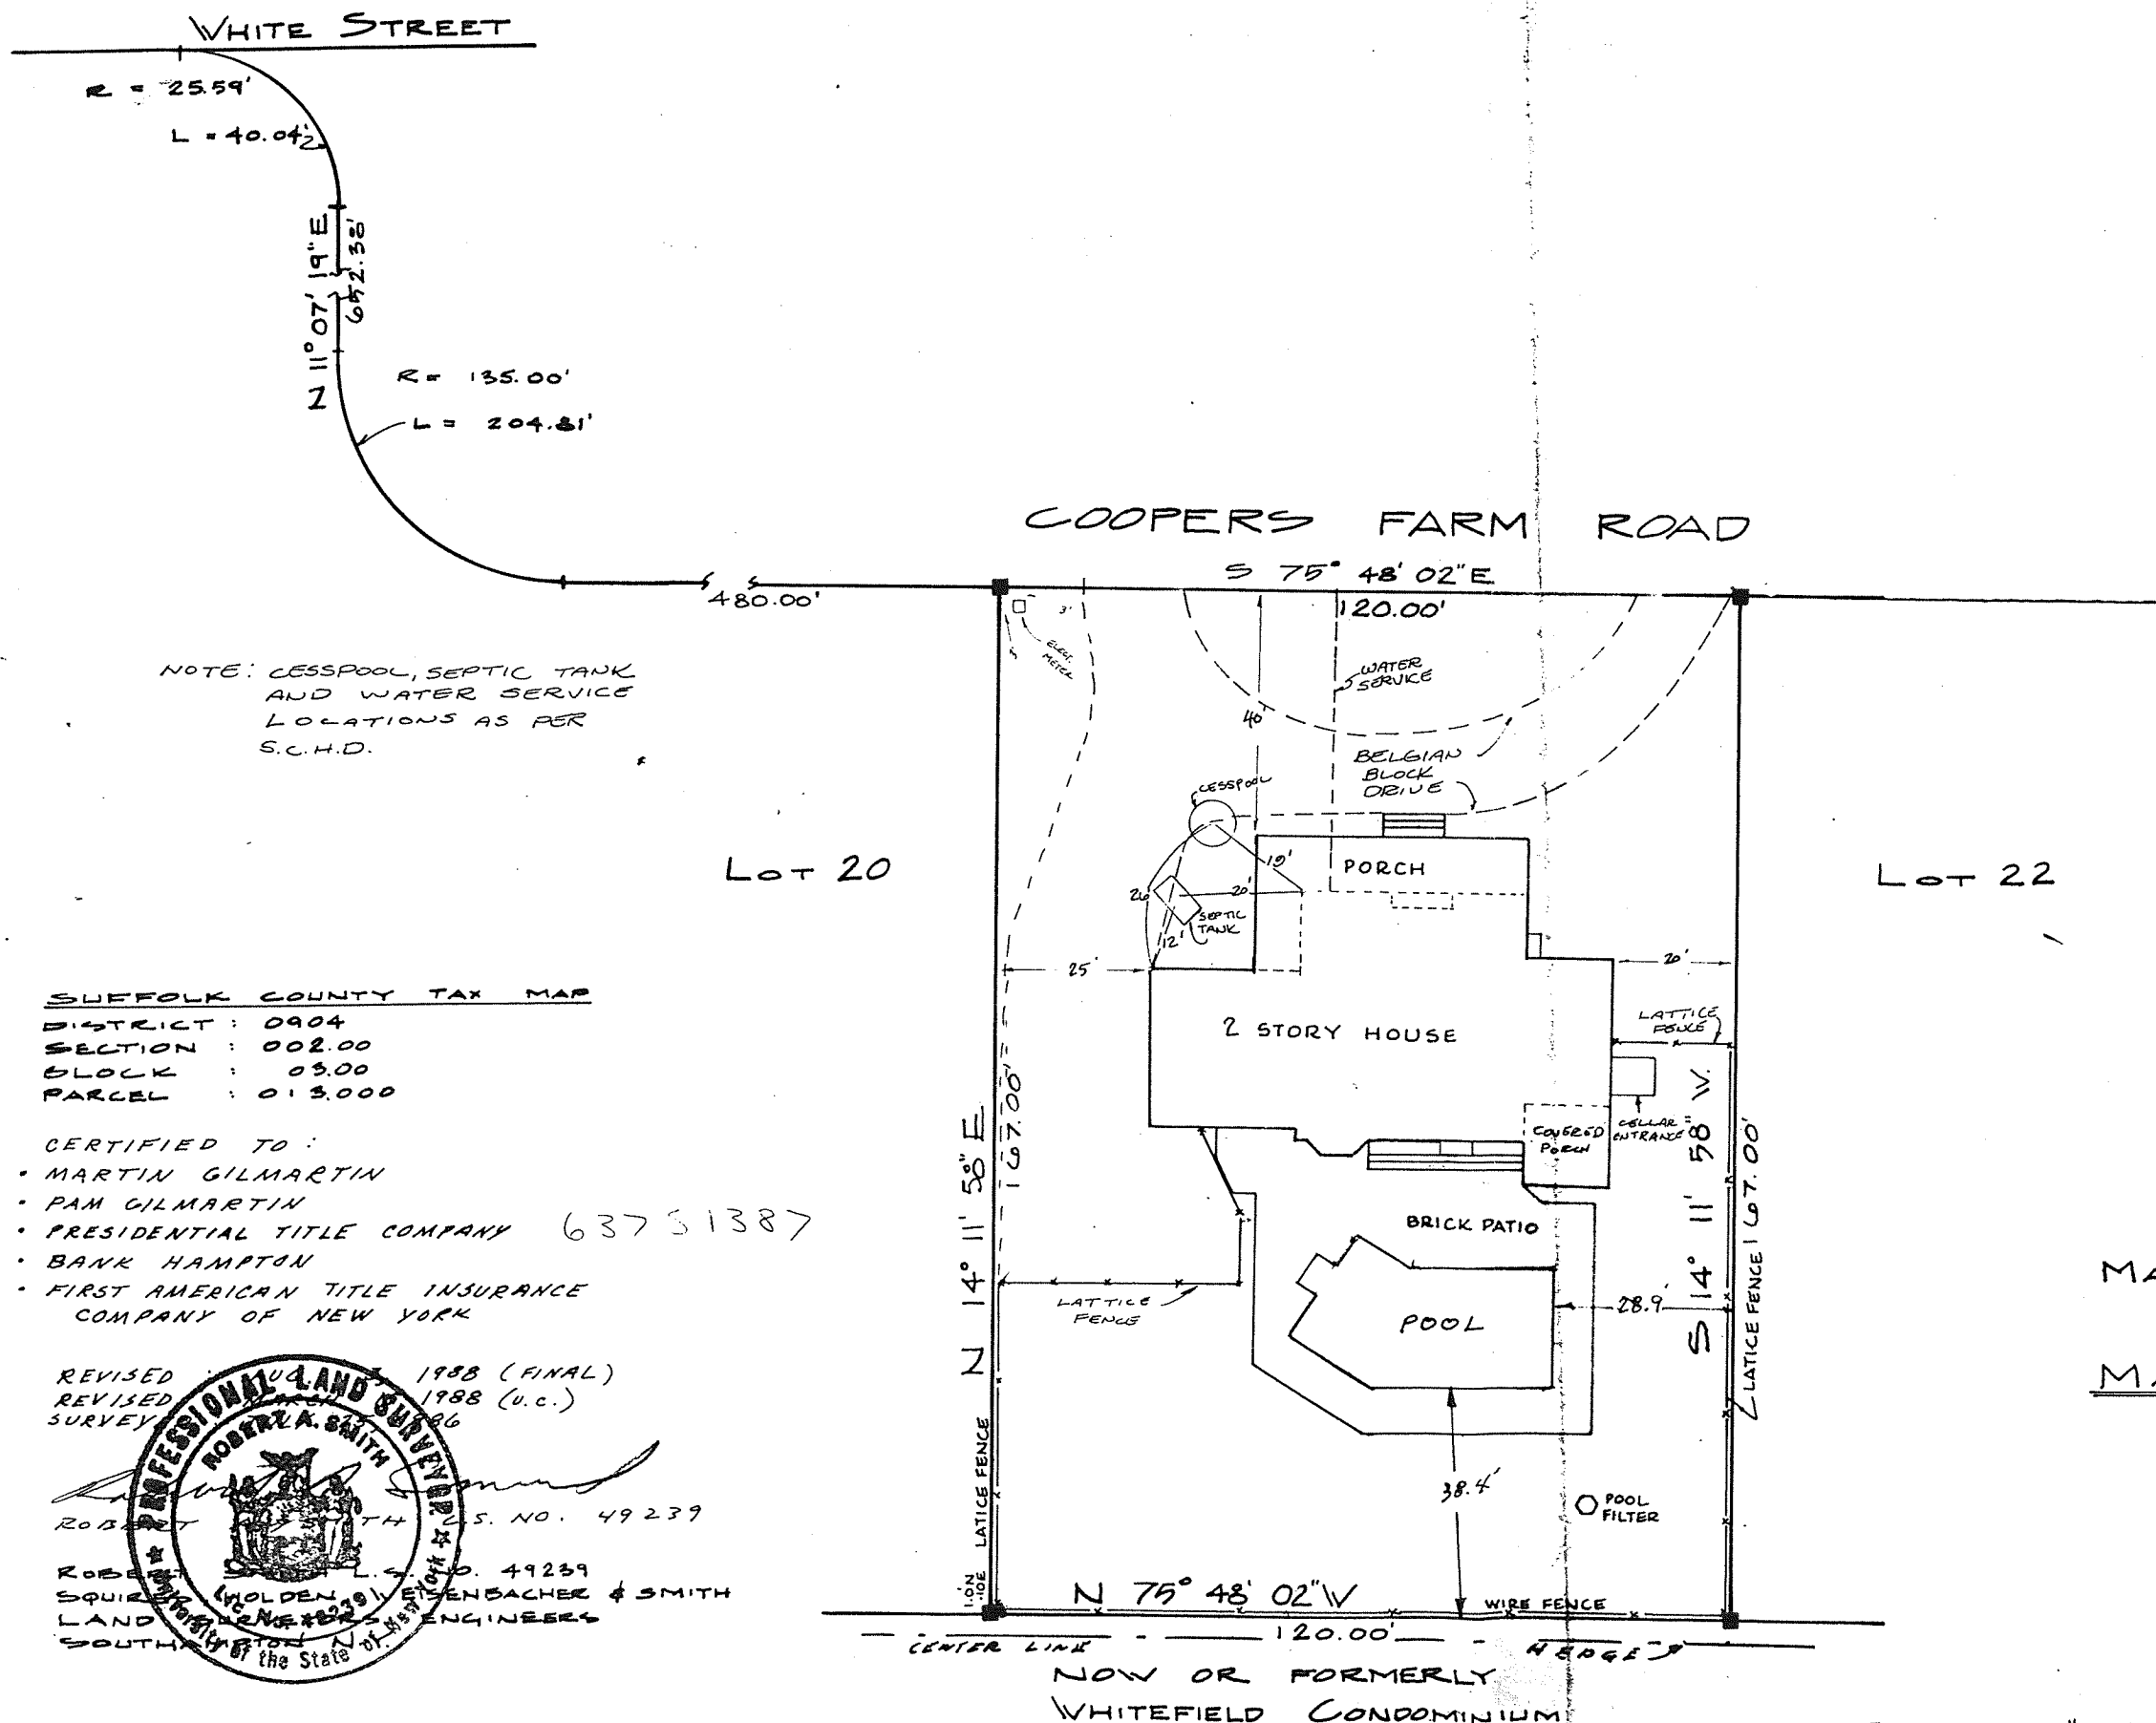

UNAUTHORIZED ALTERATION OR ADDITION TO A SURVEY MAP BEARING A LICENSED LAND SURVEYOR'S SEAL IS A VIOLATION OF SECTION 7209, SUB-DIVISION 2, OF THE NEW YORK EDUCATION LAW.

COPIES OF THIS SURVEY MAP NOT BEARING THE LAND SURVEYOR'S GREEN INKED SEAL OR EMBOSSED SEAL SHALL NOT BE CONSIDERED TO BE A VALID TRUE COPY.

CERTIFICATIONS INDICATED HEREON SIGNIFY THAT THIS SURVEY WAS PREPARED IN ACCORDANCE WITH THE EXISTING CODE OF PRACTICE FOR LAND SURVEYS ADOPTED BY THE NEW YORK STATE ASSOCIATION OF PROFESSIONAL LAND SURVEYORS. SAID CERTIFICATIONS SHALL RUN ONLY TO THE PERSON FOR WHOM THE SURVEY IS PREPARED, AND ON HIS BEHALF TO THE TITLE COMPANY, GOVERNMENTAL AGENCY AND LENDING INSTITUTION LISTED HEREON, AND TO THE ASSIGNEES OF THE LENDING INSTITUTION. CERTIFICATIONS ARE NOT TRANSFERABLE TO ADDITIONAL INSTITUTIONS OR SUBSEQUENT OWNERS.


SUFFOLK COUNTY TAX MAP

DISTRICT : 0904
SECTION : 002.00
BLOCK : 05.00
PARCEL : 013.000

CERTIFIED TO :

- MARTIN GILMARTIN
- PAM GILMARTIN
- PRESIDENTIAL TITLE COMPANY 63751387
- BANK HAMPTON
- FIRST AMERICAN TITLE INSURANCE COMPANY OF NEW YORK

REVISED 1988 (FINAL)
REVISED 1988 (U.C.)
SURVEY

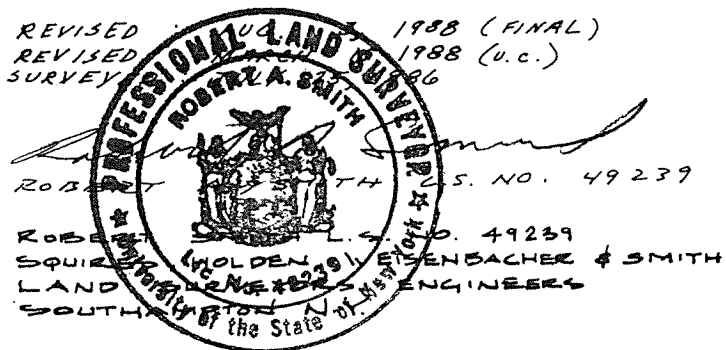

MAP OF LOT NO. 21
SUBDIVISION MAP OF
COOPERS FARM
MAP NO. 7986 ~ FILED OCT. 15 1985
FOR
MARTIN & PAM GILMARTIN
SITUATE
INC. VILLAGE OF SOUTHAMPTON
SUFFOLK COUNTY, N.Y.

BOOK	PAGE
514	126
526	111
523	132

SCALE : 1" = 30'

Klu