


Red Bridge Road (50')
S 60°14'10" E

SURVEY OF PROPERTY
MAP OF
DESCRIBED PROPERTY

N 30°24'00" E 60.00

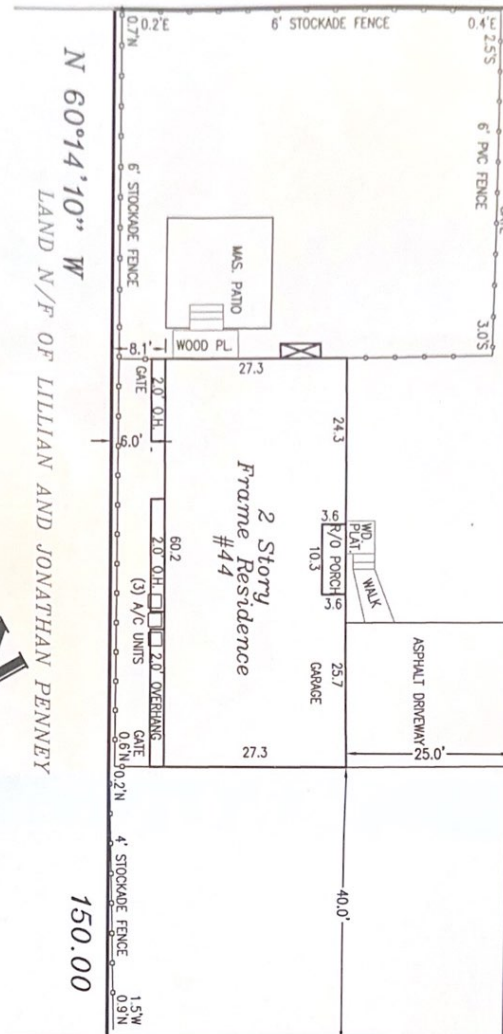

S 30°24'00" W 60.00
Ocean Avenue (50')

SITUATE
CENTER MORICHES
TOWN OF BROOKHAVEN
SUFFOLK COUNTY, N.Y.

SURVEYED: APR. 21, 2017

NOTES:

1. PROPERTY KNOWN AS TAX MAP# 0200--B87--02--52A
2. LOT AREA 9.000 SQ.FT. (0.207 ACRE(S))
3. THIS SURVEY WAS PREPARED USING A TRIMBLE
ST. ROBOTIC TOTAL STATION.
4. PROPERTY CORNER MONUMENTS WERE NOT SET AS
PART OF THIS SURVEY.

SURVEYED: APR. 21, 2017

COPIES OF THIS SURVEY MAP NOT BEARING THE LAND SURVEYOR'S INKED OR EMBOSSED SEAL SHALL NOT BE CONSIDERED TO BE A VALID COPY.

2. UNAUTHORIZED REPRODUCTION OR ADAPTATION TO THIS SURVEY MAY BE FINED A FINE OF \$1000.00 OR IMPRISONMENT FOR A TERM OF 1 YEAR OR BOTH.
3. SECTION 2 OF THE NEW YORK STATE EDUCATION LAW
200 BELLE VIEW AVENUE,
CENTER MORICHES, NEW YORK 11934
VOICE: 631.874.0156 - FAX: 631.909.3845
www.wickslandsurveying.com
RECORDS OF RICHARD C. DRAKE

SCALE: 1"=20'	SURVEYED BY: B.W./S.S.	DRAWN BY: S.S.	SHEET: 1 OF 1
------------------	---------------------------	-------------------	------------------