


GREAT PLAINS ROAD

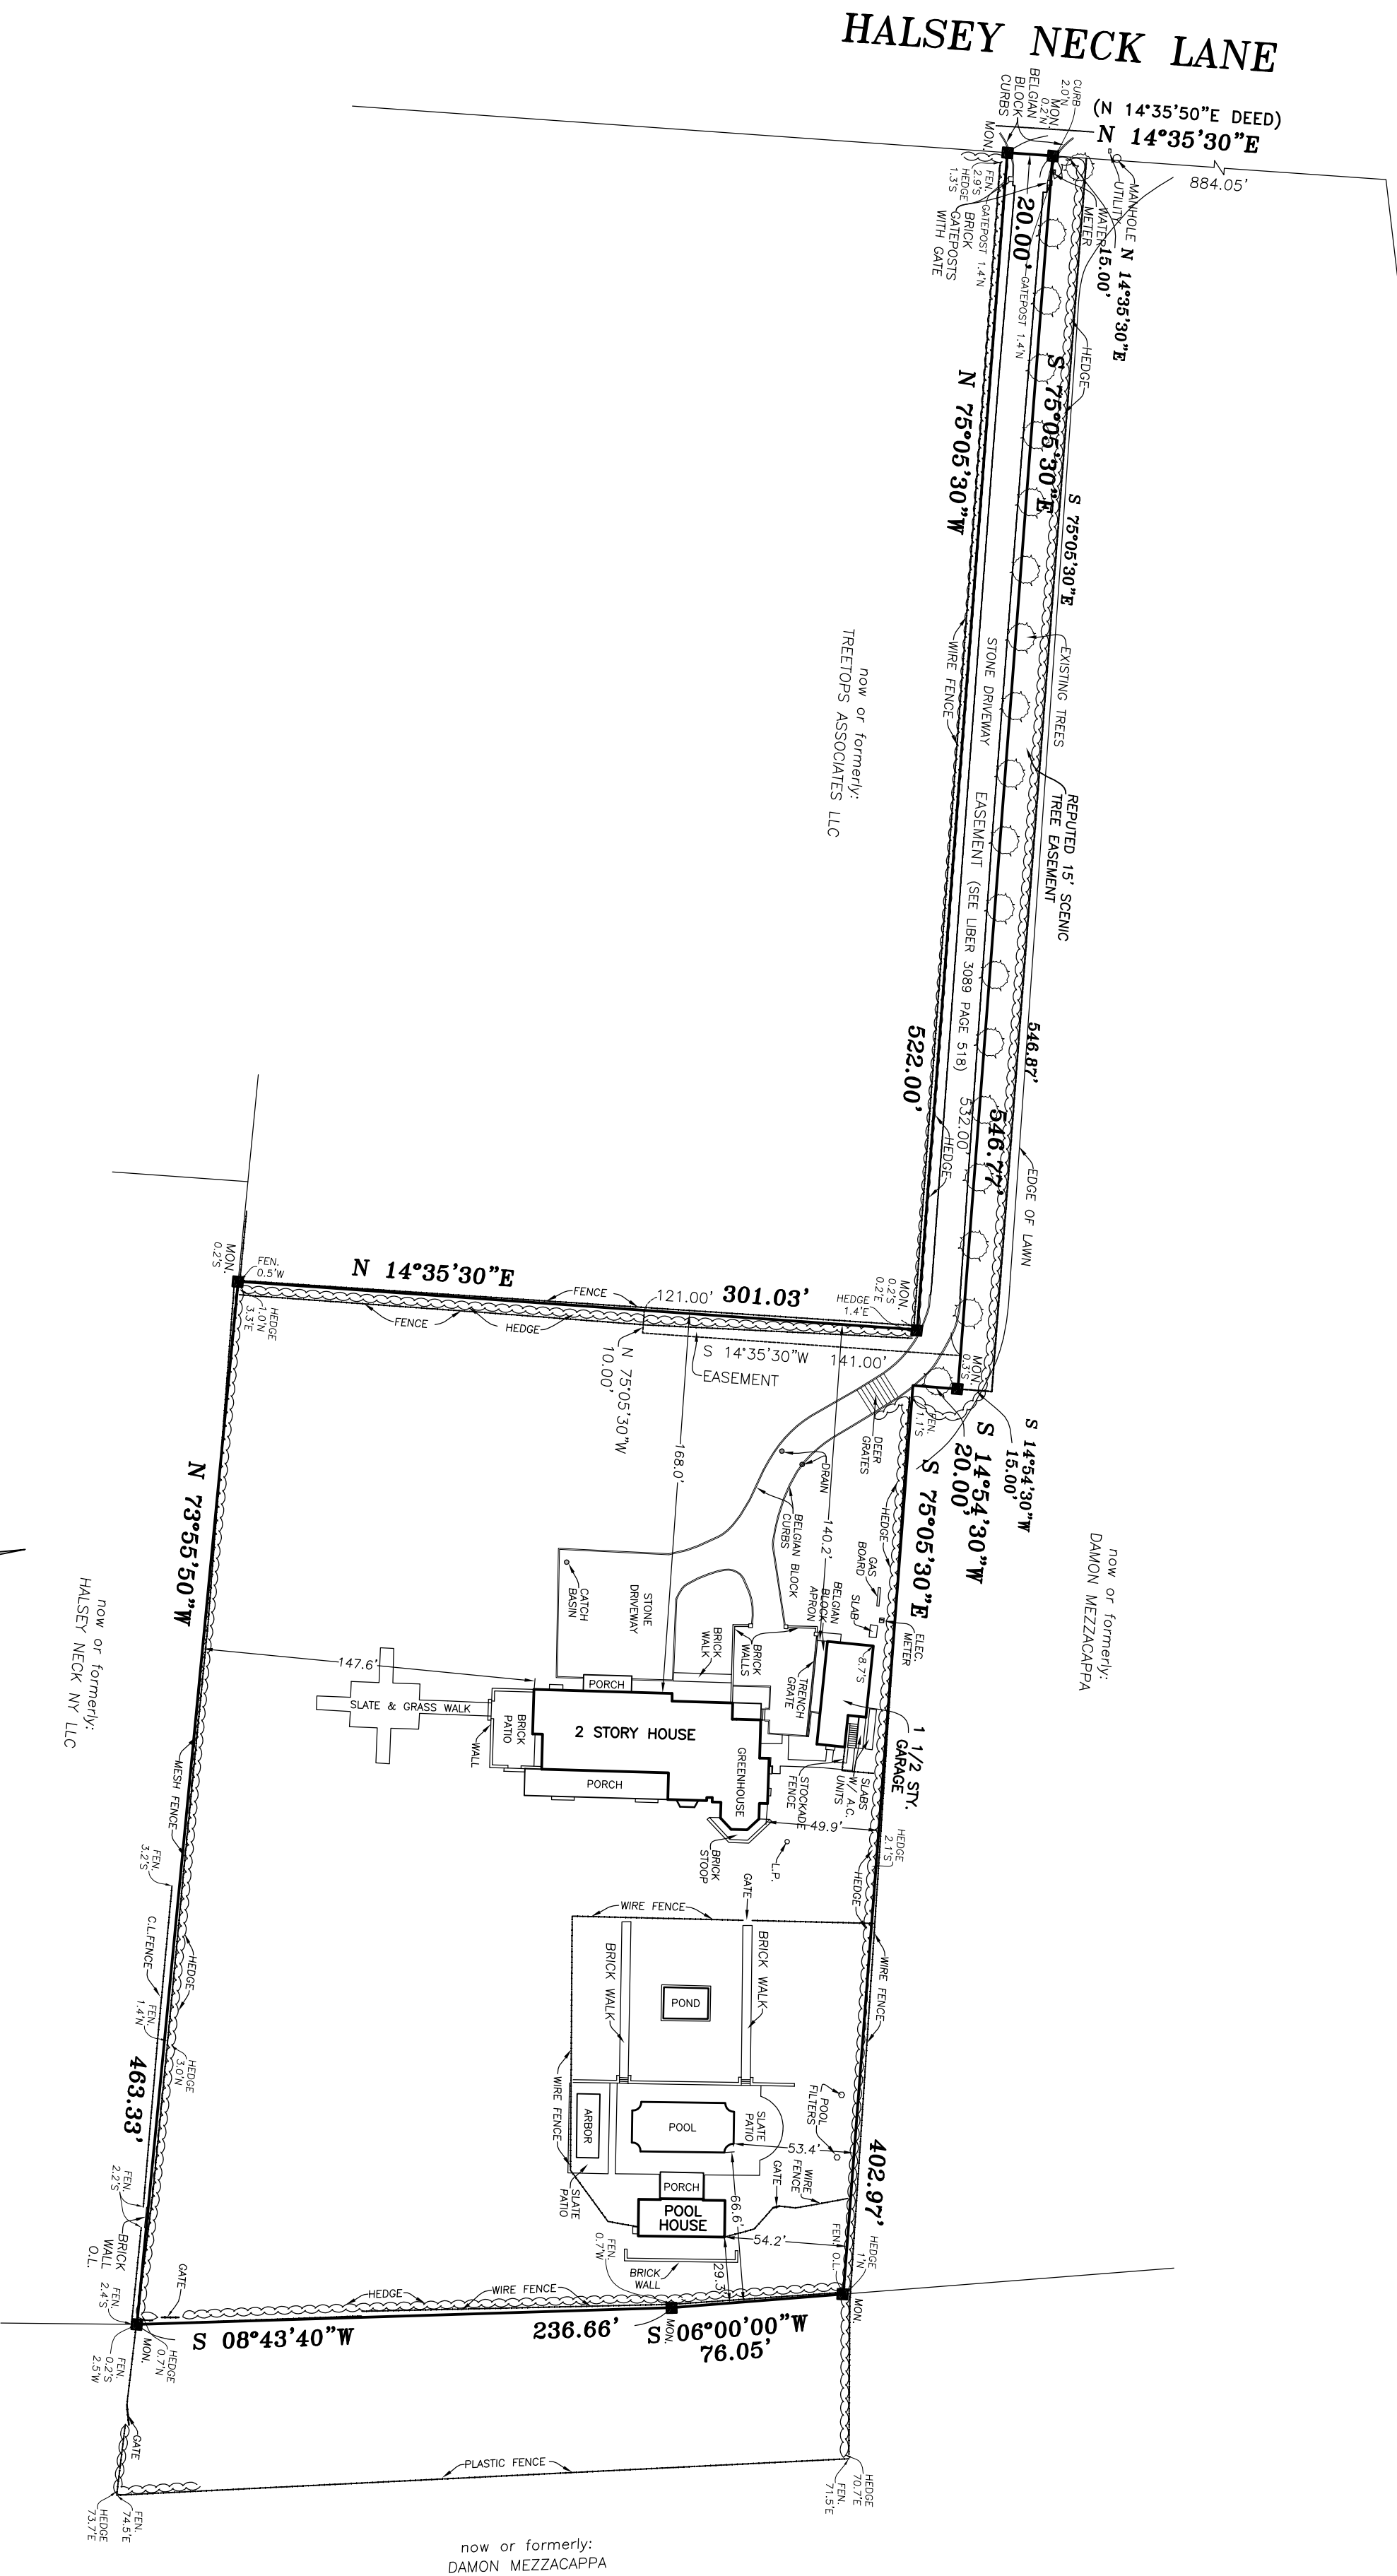

REVISED: AUGUST 2, 2016 (FINAL ON IMPROVEMENTS,
SURVEYED: SEPTEMBER 8, 2015

THOMAS D. BURKE, L.S. No. 50325
S. H. W. and S., LAND SURVEYORS P.C.
SQUIRES, HOLDEN, WEISENBACHER & SMITH
LAND SURVEYING ~ LAND PLANNING ~ ENGINEERING
SOUTHAMPTON ~ NEW YORK

MAP OF PROPERTY
FOR
NORTH FIFTH LLC
SITUATE
INC. VILLAGE OF SOUTHAMPTON
TOWN OF SOUTHAMPTON
SUFFOLK COUNTY, NEW YORK

