






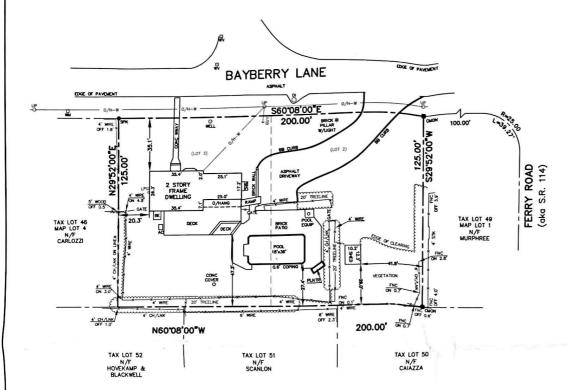

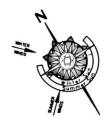

File Map North TOTAL LOT AREA 25,000± SQ.FT.

## NOTES:

- SURVEY CONDUCTED WITHOUT BENEFIT OF COMPLETE TITLE REPORT. EASEMENTS OF RECORD FOR WHICH DOCUMENTATION HAS BEEN PROVIDED ARE SHOWN HEREON. OTHER EASEMENTS, IF ANY, ARE NOT SHOWN.
- 2. SUBJECT PROPERTY SHOWN AS LOTS 2 AND 3 ON "SUBDIVISION MAP: OF: BROADACRES; STUTATE: NORTH HAVEN; TOWN OF SOUTHAMPTON; SUFFOLK COUNTY, N.Y." BY THEODORE F. SOUTHS, SOUTHAMPTON, NY, FILED AUG 26, 1953 AS FILE MAP No. 2111.
- 3. SUBJECT PROPERTY IN ZONE "R2" PER ZONING MAP FOR THE INCORPORATED VILLAGE OF NORTH HAVEN, OCTOBER 2015. ALL ZONING REGULATIONS AND RESTRICTIONS SHOWN HEREON MUST BE VERHIED WITH APPROPRIATE AUTHORITIES.
- 4. SUBJECT PROPERTY IN FEDERAL EMERGENCY
  MANAGEMENT AGENCY FLOOD ZONE "X OUTSIDE 0.2% FLOOD
  PLAIN" AS SHOWN ON FLOOD INSURANCE RATE MAP
  FMS6103C0193H, LAST REVISED SEPTEMBER 25, 2009.
- FM36103C0193H, LAST REVISED SEPTEMBER 25, 2009.

ARE DEPICTED ACCORDING TO RECORDS SUPPLIED BY OTHERS. USERS OF THIS SURVEY MAP ARE CAUTIONED THAT NO CERTIFICATION, WARRANTY OR GUARANTY, ETHER EXPRESS OF IMPORTANT OF THE LOCATION OR COMPLETENESS OF INFORMATION WITH RESPECT TO UNDERGROUND UTILITIES SHOWN HEREON. CERTIFICATION IS EXTENDED TO THE LOCATION OR COMPLETENESS OF INFORMATION WITH RESPECT TO UNDERGROUND UTILITIES SHOWN HEREON. CERTIFICATION IS EXTENDED TO THE LOCATION OR DATA AS PROVIDED IN SKETCH FORMAT OR AS LOCATED BY FIELD MEASUREMENT OF SURFACE MARK OUT.

CERTIFIED TO: FRANCIS G. SCHIAVONI



UNAUTHORIZED A	TERATION OR ADDITION TO A SURVEY MAP BEARING A
LICENSED LAND S	URVEYOR'S SEAL IS A VIOLATION OF SECTION 7209,
	OF THE NEW YORK STATE EDUCATION LAW. ONLY COPIES
	AL OF THIS SURVEY MARKED WITH AN ORIGINAL OF THE
LAND SURVEYOR'S	INKED SEAL OR EMBOSSED SEAL SHALL BE CONSIDERED
	E COPIES. CERTIFICATIONS INDICATED HEREON SIGNIFY
	Y MAP WAS PREPARED IN ACCORDANCE WITH THE
	CODE OF PRACTICE FOR LAND SURVEYS ADOPTED BY
	TATE ASSOCIATION OF PROFESSIONAL LAND SURVEYORS.
SAID CERTIFICATIO	INS SHALL RUN ONLY TO THE PERSON(S) FOR WHOM THE
SURVEY IS PREPA	RED, AND ON THEIR BEHALF TO THE TITLE COMPANY,
LENDING INSTITUTI	ON AND/OR COVERNMENTAL AGENCY LISTED HEREON, AND
THE SUCCESSORS	AND/OR ASSIGNEES OF THE LENDING INSTITUTION.
CERTIFICATIONS A	RE NOT TRANSFERABLE TO ADDITIONAL INSTITUTIONS OR
SUBSECUENT OWN	ERS. LOCATIONS OF UNDERGROUND IMPROVEMENTS OR
	IF ANY EXIST EXCEPT AS SHOWN HEREON, ARE NOT

, i

ENGROACHMENTS, IF ANY EXIST EXCEPT AS SHOWN HEREON, ARE NOT KNOWN AND ARE NOT COVERED BY THIS CERTIFICATION.

COPYRIGHT 2023 F. MICHAEL HEMMER, LS, P.G. ALL RIGHTS RESERVED.

TABLE OF AREAS	25, 000
EXISTING TOTAL CLEARING ALLOVED TOTAL CLEARING (25,000 = 0.60)	21, 482 15, 000
EXISTING TOTAL LOT COVERAGE ALLOWED TOTAL LOT COVERAGE (25,000 = 0.20)	4, 862 5, 000
EXISTING DVELLING GFA ALLOVED DVELLING GFA ((25,000-10,000) m0,100+2,000	3, 500
EXISTING ADDITIONAL GFA ALLOWED ADDITIONAL GFA (0.15 ≥ 3,500)	N/A 525
EXISTING TOTAL GFA ALLOVED TOTAL GFA	N/A 4, 025

JLA PDB	Project No. 16-045	
FMH JER ACP	16-045.DWG	1
Checked By: FMH	Scale 1 - 30'	
Reviewed Bys KMS	15 JUL 2016	1
24JUL23 CO UPDATE 03AUG23 CERTIFICATION		VILLA( COUNT DISTR
		F. MIC

PROPERTY SITUATE AT
5 BAYBERRY LANE
AGE OF NORTH HAVEN, NEW YOR
JNTY OF SUFFOLK, TOWN OF SOUTHAMPTO

**SCHIAVONI** 

COUNTY OF SUFFOLK, TOWN OF SOUTHAMPTO DISTRICT 901, SECTION 4, BLOCK 2, LOT 48.1 PREPARED BY F. MICHAEL HEMMER, LS, P.C.

PROFESSIONAL SURVEYING SERVICES
PO SEX 1225, SAD HARBOR, NEW YORK 11943
(931) 738-7199
INFO@Frients.com
Steet Title:
CERTIFICATE OF OCCUPANCY SURVEY

Sheet 1 OF 1