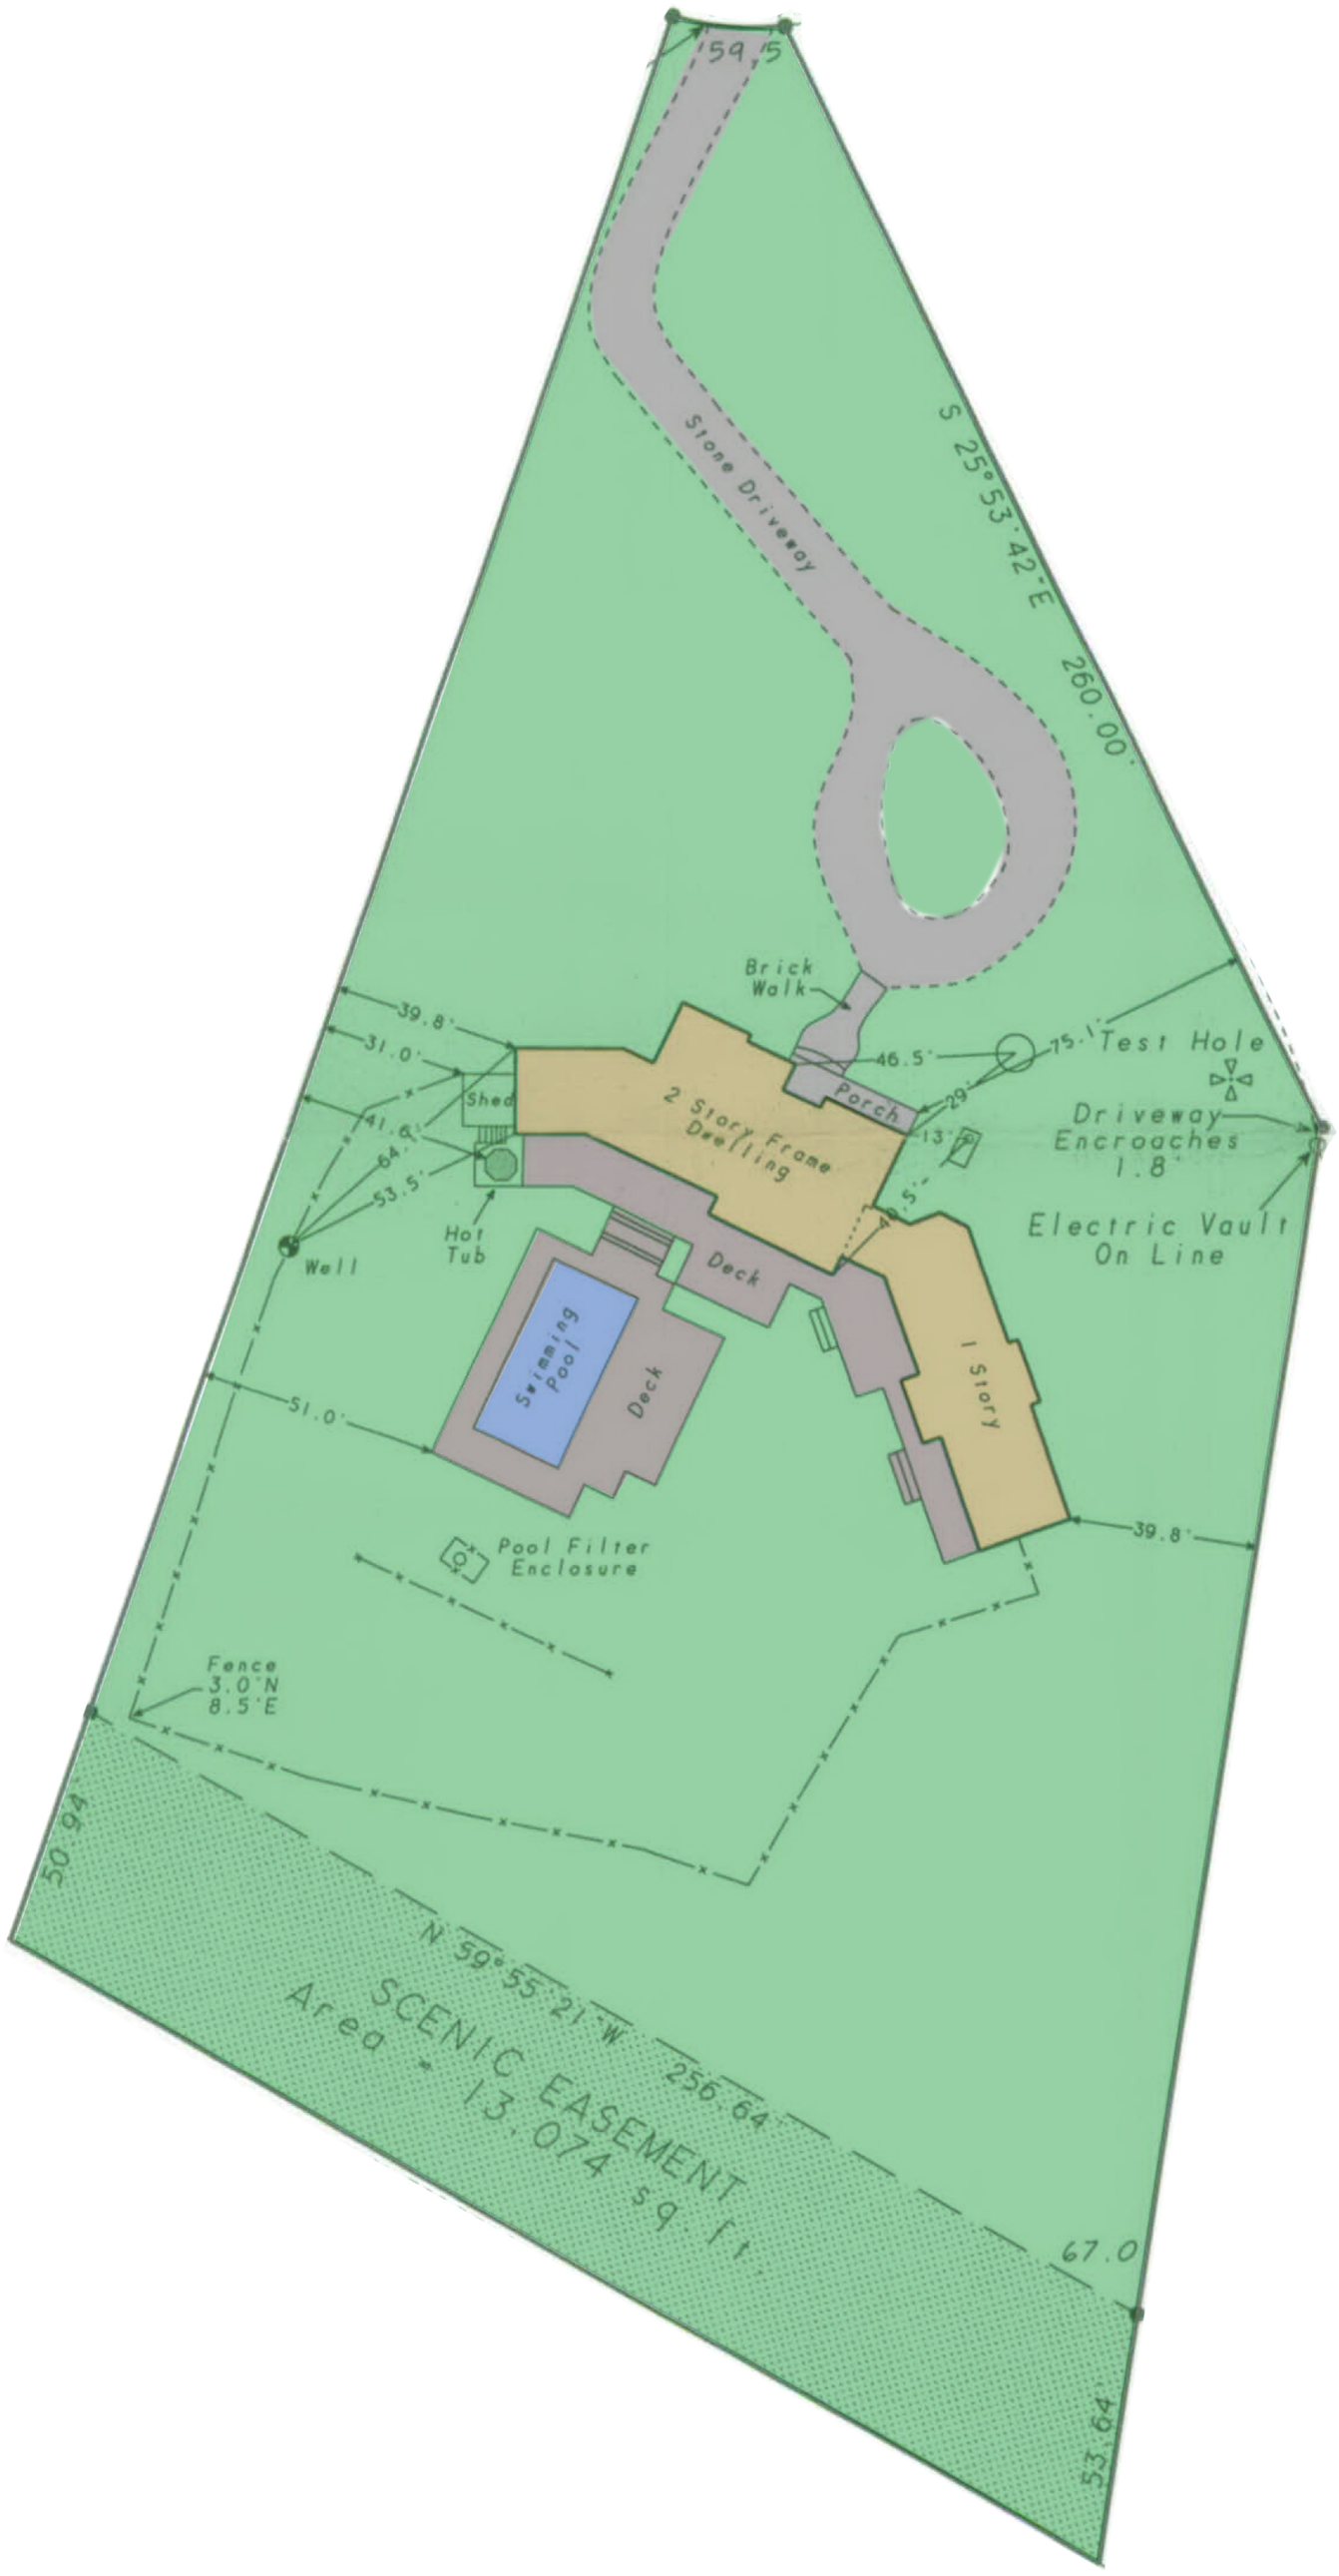

159.5'
S 25°53'42"E
260.00'
Stone Driveway
Brick Walk
39.8'
31.0'
41.9'
64.1'
53.5'
Shed
2 Story Frame Dwelling
Porch
46.5'
29'
13'
4.5'
75.1'
Test Hole
Driveway Encroaches 1.8'
Electric Vault On Line
Hot Tub
Well
Deck
Swimming Pool
Deck
1 Story
51.0'
39.8'
Pool Filter Enclosure
Fence 3.0'N 8.5'E
50.94'
N 59°55'21"W 256.64'
SCENIC EASEMENT
Area = 13,074 sq ft
67.0'
53.64'