

SURVEY OF PROPERTY
 PROPERTY LOCATED IN THE VILLAGE OF SOUTHAMPTON
 LOT No. 6
 MAP OF HEADY CREEK PARK
 FILED: MARCH 18, 1965; FILE No. 4288
 TOWN OF SOUTHAMPTON
 SUFFOLK COUNTY, NEW YORK
 S.C.T.M. # 904-011-01-2
 AREA = 21.459 SF. = 0.4926 ACRES
 SCALE: 1"=30'

NOTE: THE EXISTENCE OF RIGHT OF WAYS,
 WETLANDS AND/OR EASEMENTS OF RECORD
 IF ANY, NOT SHOWN ARE NOT GUARANTEED

NOTE: WATER SERVICE AND SEPTIC SYSTEM
 LOCATION BY OTHERS B.O.M. REF. No. R09-03-0783

SEPTIC LOCATION (MAIN RESIDENCE)

	A	B	C
S.T.	22'	13.5'	
L.P. 1	30.5'	21'	
L.P. 2		13.5'	29.5'

SEPTIC LOCATION (POOL HOUSE)

	A	B
S.T.	13.5'	22'
L.P.	17'	36'



LAND N/F
 H. & L. KAIROUZ

CERTIFIED TO
 JOHN ANTON
 FIDELITY NATIONAL TITLE INS. CO.

UNAUTHORIZED ALTERATION OR ADDITION TO THIS SURVEY IS A VIOLATION
 OF SECTION 7205 OF THE NEW YORK STATE EDUCATION LAW.

COPIES OF THIS SURVEY MAY NOT BE MADE BY ANY OTHER SURVEYOR, ENGINEER,
 OR EMBROIDERED SEAL SHALL NOT BE CONSIDERED TO BE A VALID TRUE COPY.

GUARANTEES OR CERTIFICATIONS INDICATED HEREON SHALL RUN ONLY TO
 THE PERSON FOR WHOM THE SURVEY IS PREPARED, AND ON HIS BEHALF TO
 THE TITLE COMPANY, GOVERNMENTAL AGENCY AND LENDING INSTITUTION
 LISTED HEREON, AND TO THE ASSIGNEES OF THE LENDING INSTITUTION.
 GUARANTEES OR CERTIFICATIONS ARE NOT TRANSFERABLE TO ADDITIONAL
 INSTITUTIONS OR SUBSEQUENT OWNERS.

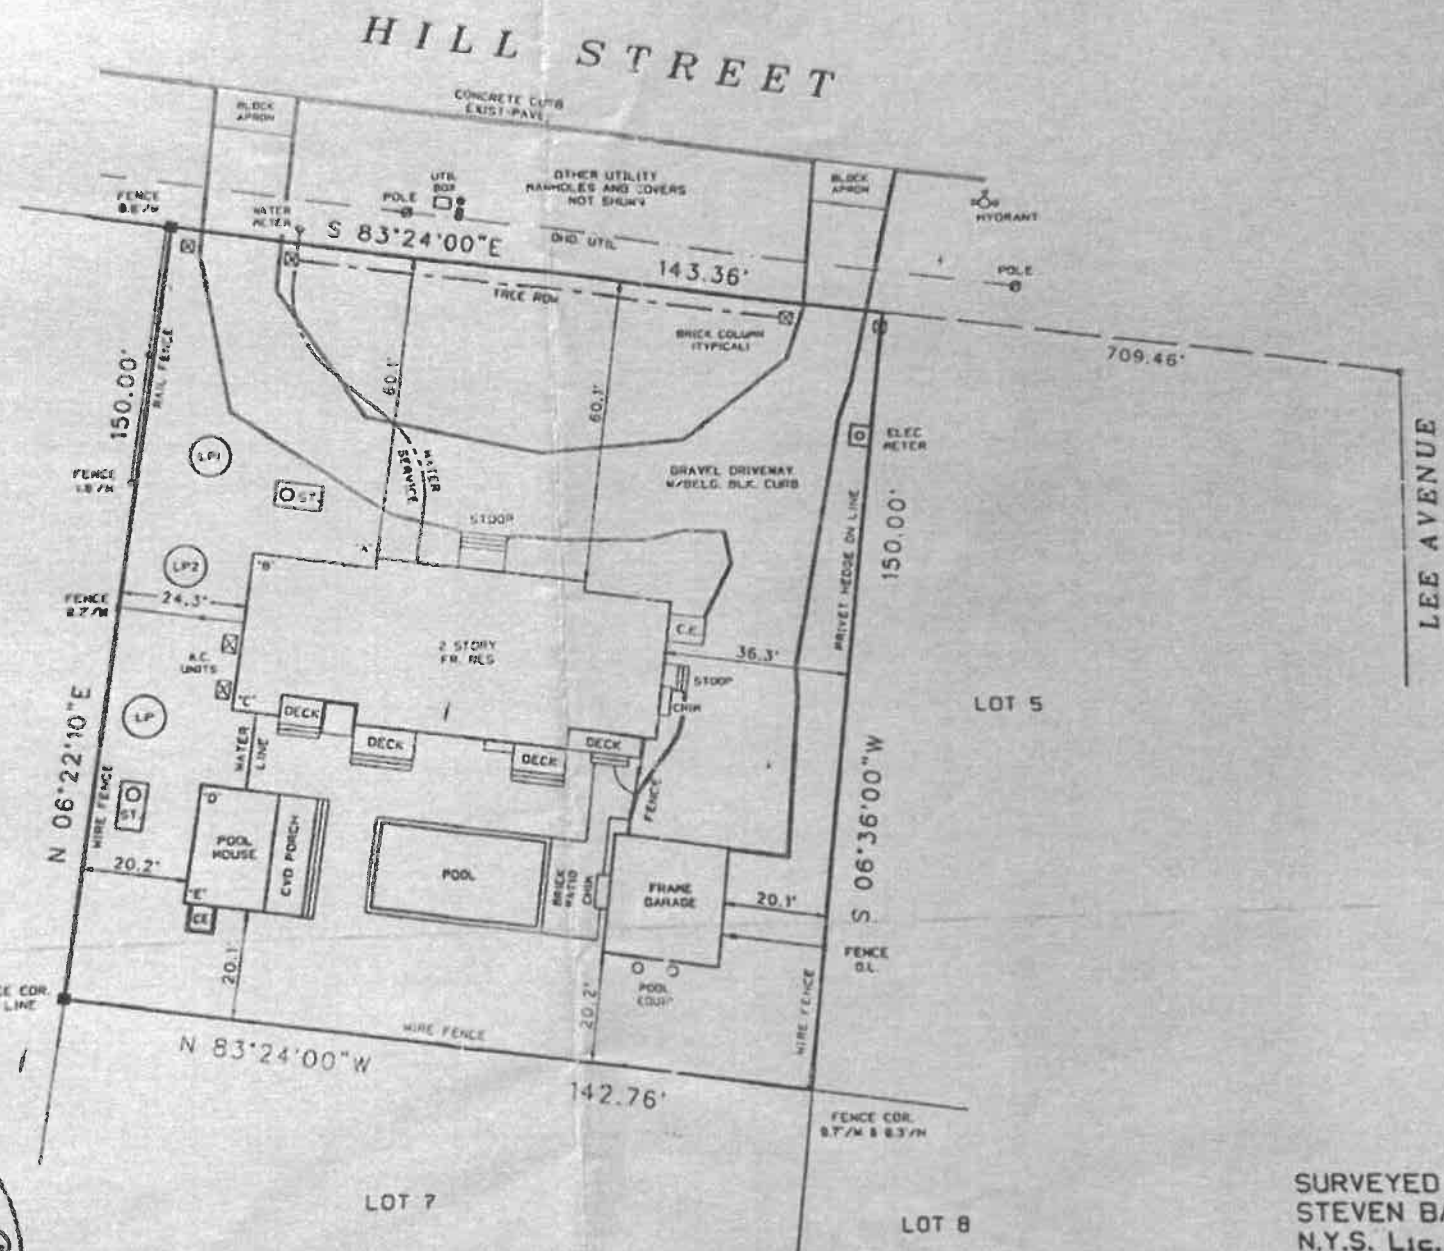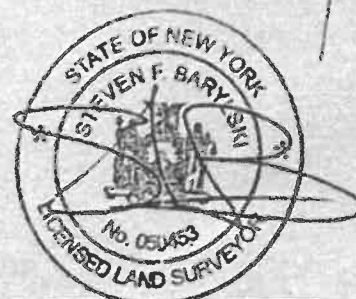

SURVEYED BY:
 STEVEN BARYLSKI
 N.Y.S. Lic. No. 050453
 41 MEETING HOUSE LANE
 SOUTHAMPTON, NY 11968
 NOVEMBER 14, 2005