


NOTE:

- 1. SUBJECT PARCEL FALLS WITHIN THE AGRICULTURAL OVERLAY DISTRICT AND THE STORMWATER MANAGEMENT DISTRICT BOUNDARIES.

SUFFOLK COUNTY TAX MAP

| | |
|----------|---------|
| DISTRICT | 0900 |
| SECTION | 113.00 |
| BLOCK | 02.00 |
| PARCEL | 008.000 |

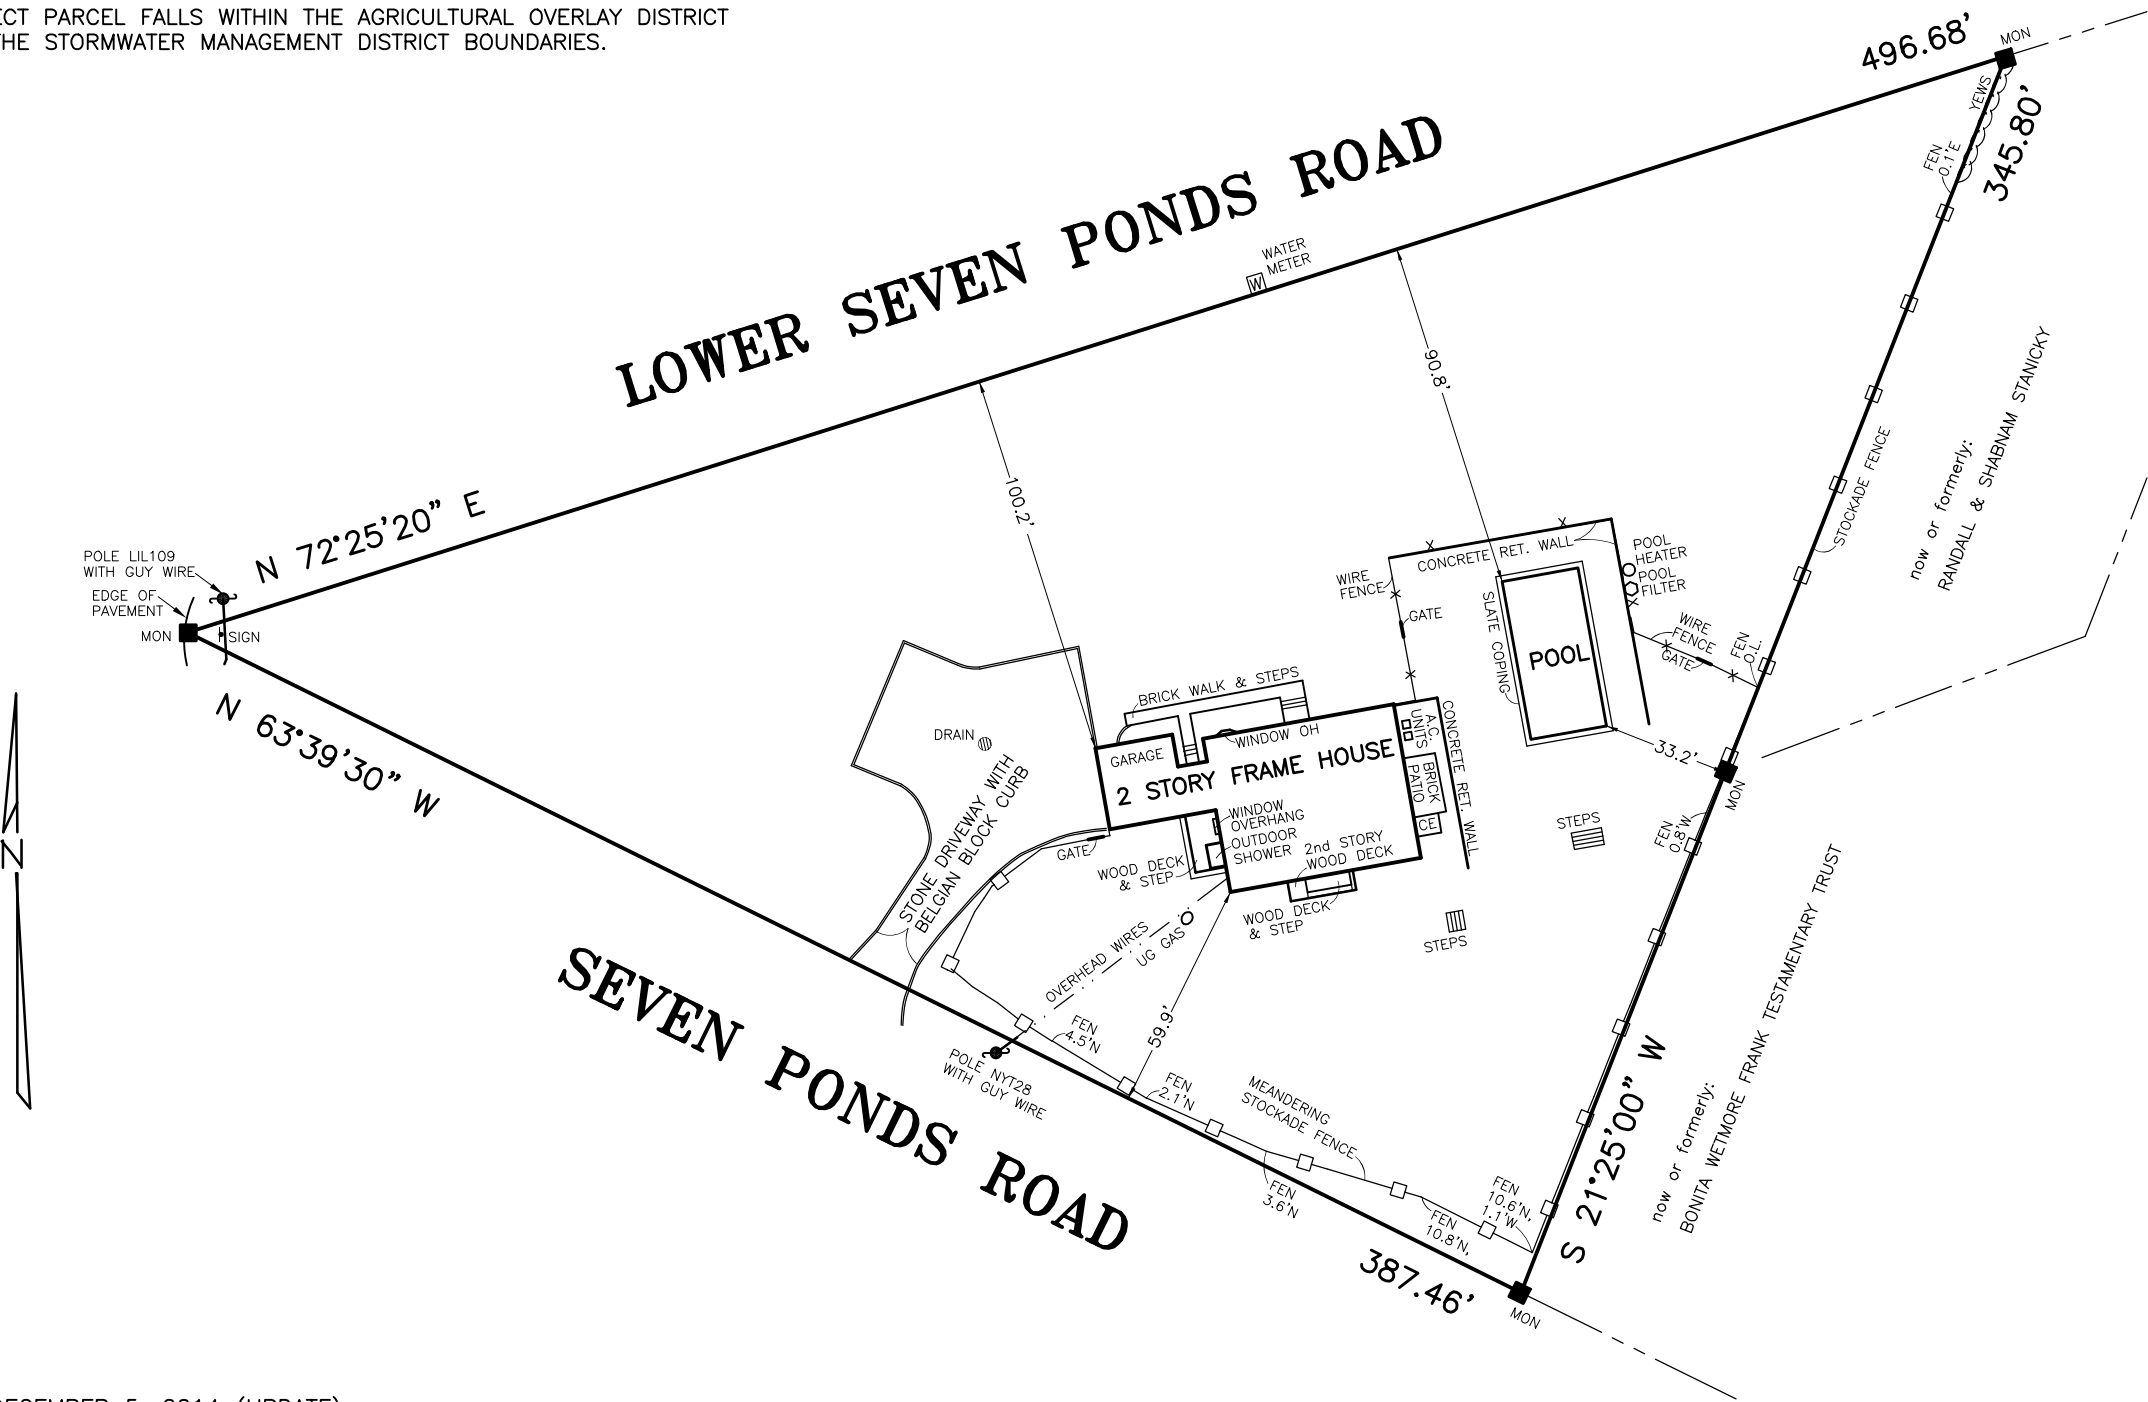

MAP OF PROPERTY
FOR
JAY HERBERT
SITUATE
WATER MILL
TOWN OF SOUTHAMPTON
SUFFOLK COUNTY, NEW YORK

AREA = 66,744 S.F. (1.532 ACRES)
SCALE: 1" = 50'

REVISED: DECEMBER 5, 2014 (UPDATE)
SURVEYED: SEPTEMBER 28, 2012