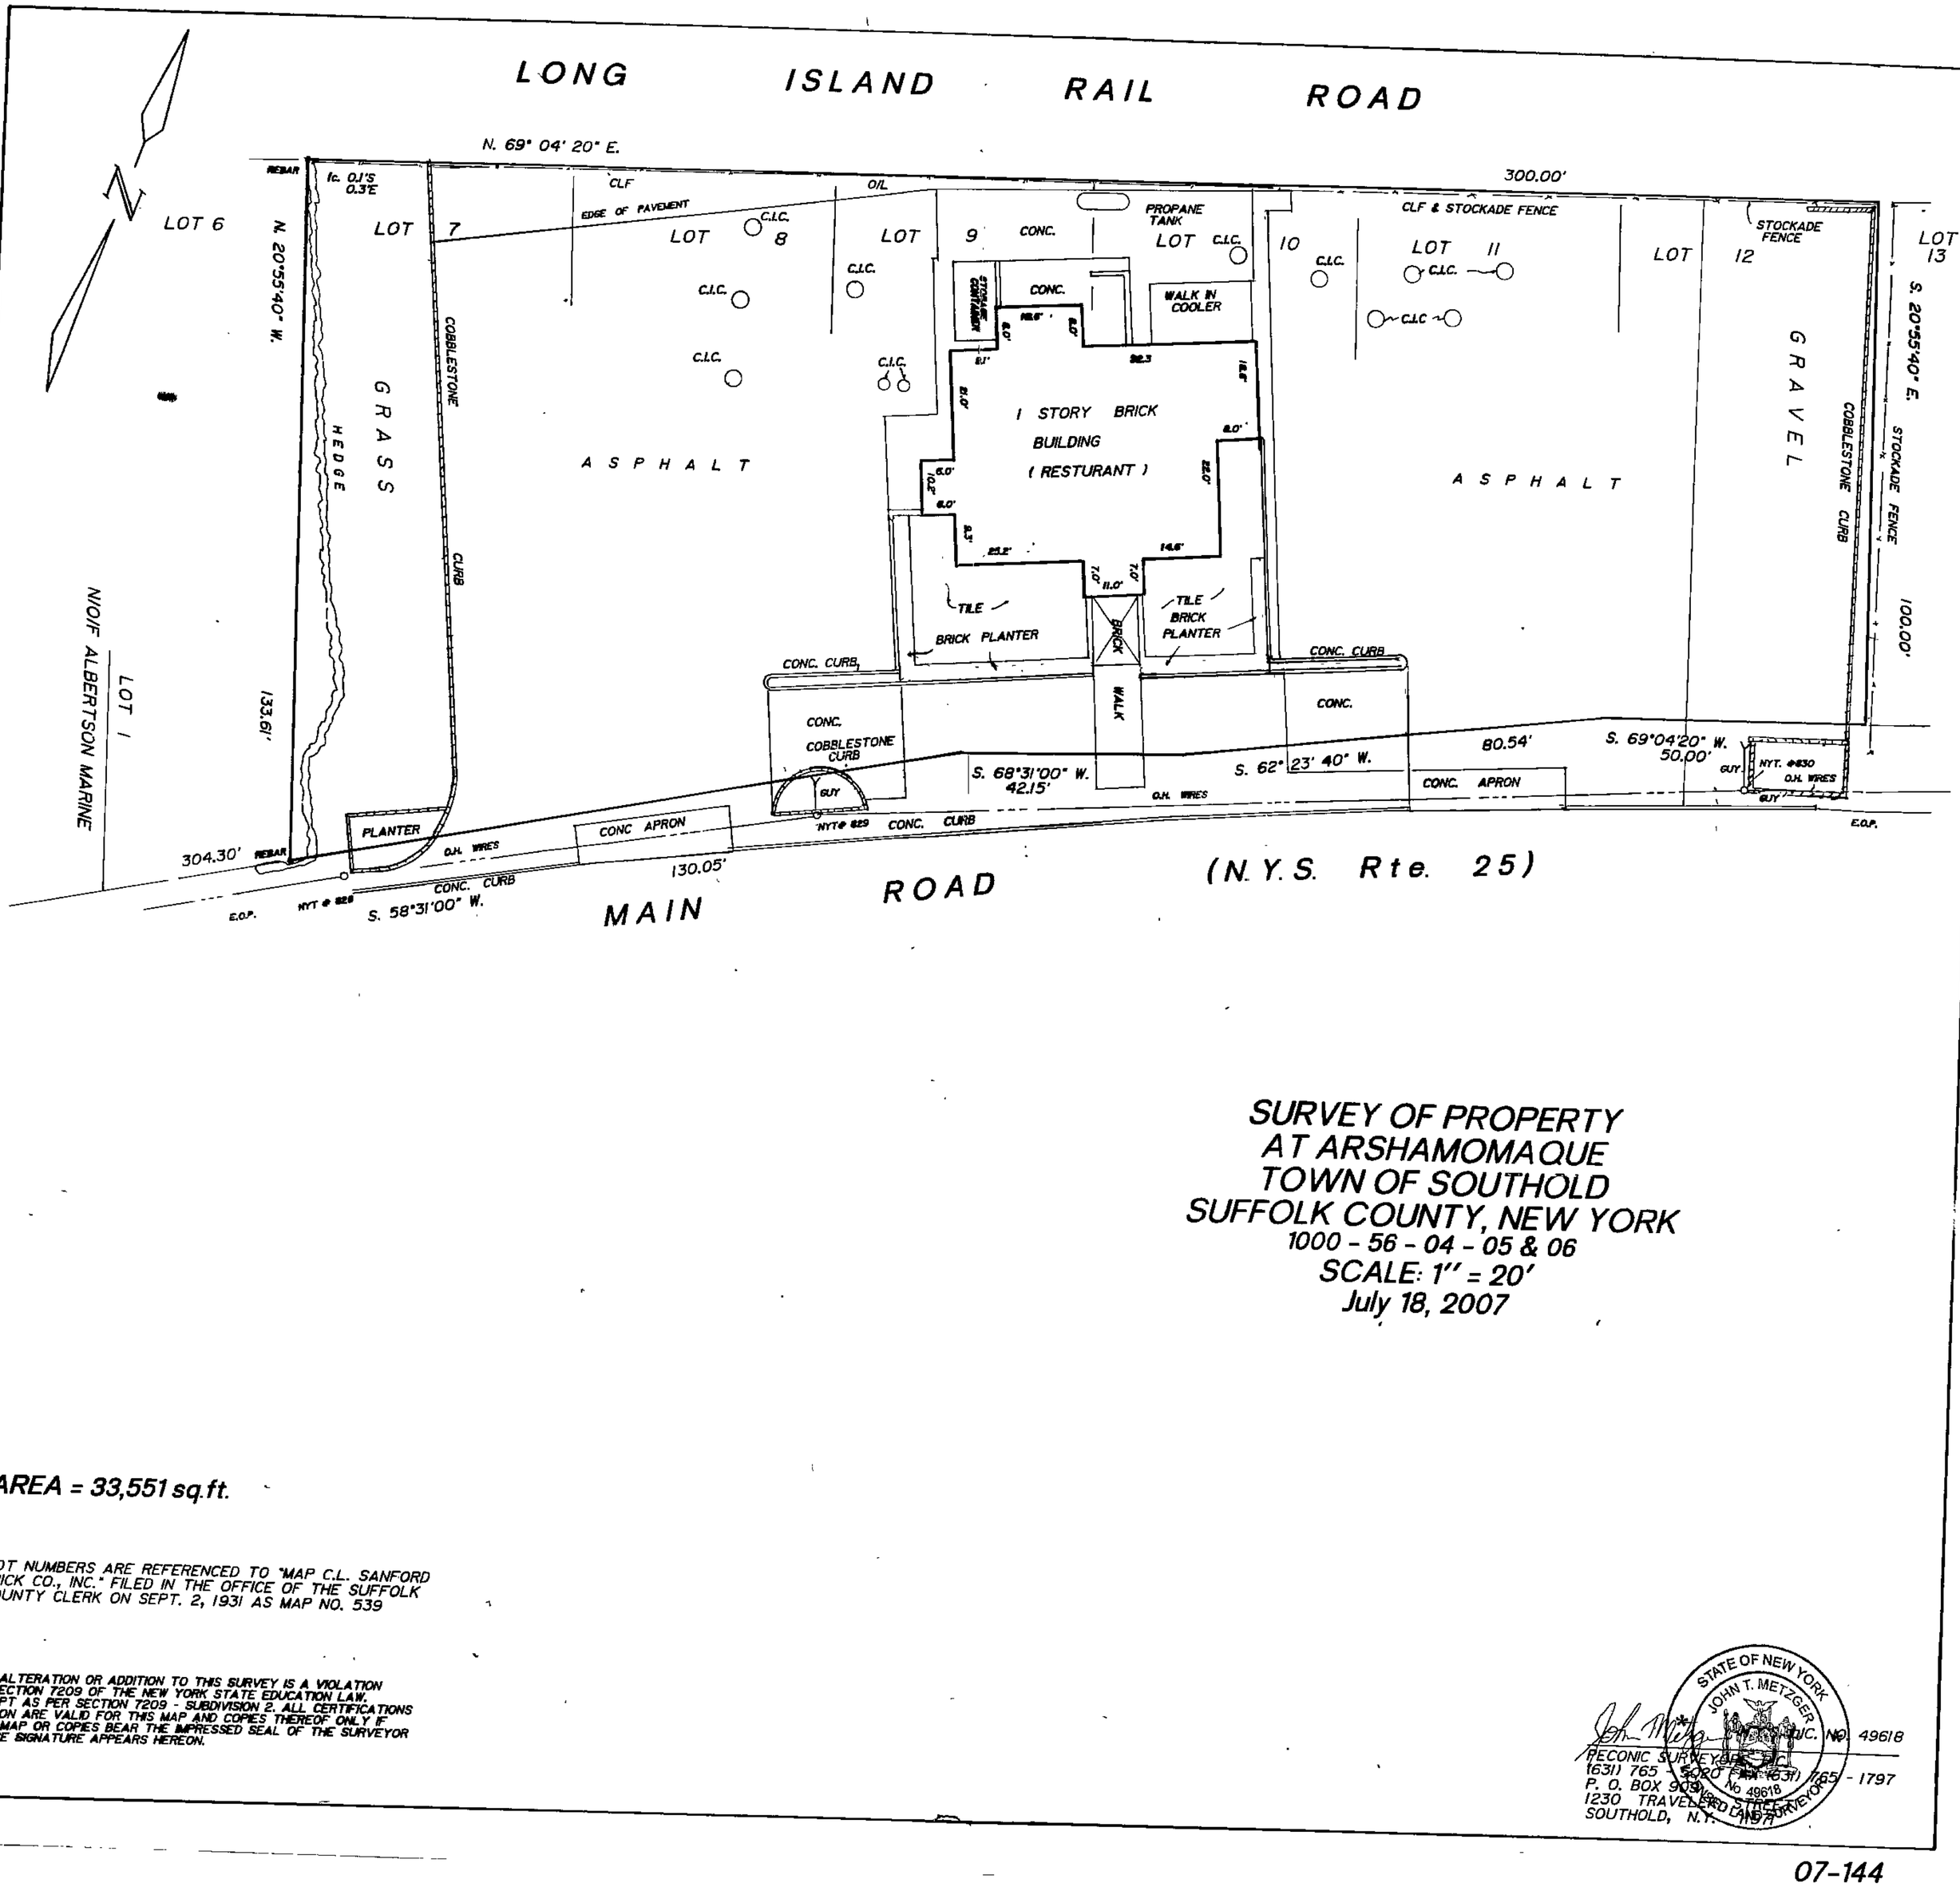

SURVEY OF PROPERTY
AT ARSHAMOMAQUE
TOWN OF SOUTHOLD
SUFFOLK COUNTY, NEW YORK
1000 - 56 - 04 - 05 & 06
SCALE: 1" = 20'
July 18, 2007

AREA = 33,551 sq.ft.

LOT NUMBERS ARE REFERENCED TO "MAP C.L. SANFORD BRICK CO., INC." FILED IN THE OFFICE OF THE SUFFOLK COUNTY CLERK ON SEPT. 2, 1931 AS MAP NO. 539

ANY ALTERATION OR ADDITION TO THIS SURVEY IS A VIOLATION OF SECTION 7209 OF THE NEW YORK STATE EDUCATION LAW. EXCEPT AS PER SECTION 7209 - SUBDIVISION 2. ALL CERTIFICATIONS HEREON ARE VALID FOR THIS MAP AND COPIES THEREOF ONLY IF SAID MAP OR COPIES BEAR THE IMPRESSED SEAL OF THE SURVEYOR WHOSE SIGNATURE APPEARS HEREON.

STATE OF NEW YORK
JOHN T. METZGER
No 49618
LICENSED LAND SURVEYOR

LIC. NO. 49618
PECONIC SURVEYORS, P.C.
(631) 765 - 5020 FAX (631) 765 - 1797
P. O. BOX 909
1230 TRAVELED LANE
SOUTHOLD, N.Y. 11971

07-144