

SHELTER ISLAND SOUND

N/O/F
SHELTER ISLAND HEIGHTS ASSOCIATION

S. 80°10'50" E.

N. 58°36'30" W.

N/O/F MARGARET S. THERINGER

BLUFF


AVENUE

MAP OF PROPERTY
AT
SHELTER ISLAND HEIGHTS
TOWN OF SHELTER ISLAND
SUFFOLK COUNTY, N.Y.

700 - 05 - 02 - 05
SCALE: 1" = 40'
MAY 24, 2000




BEVAN PLACE

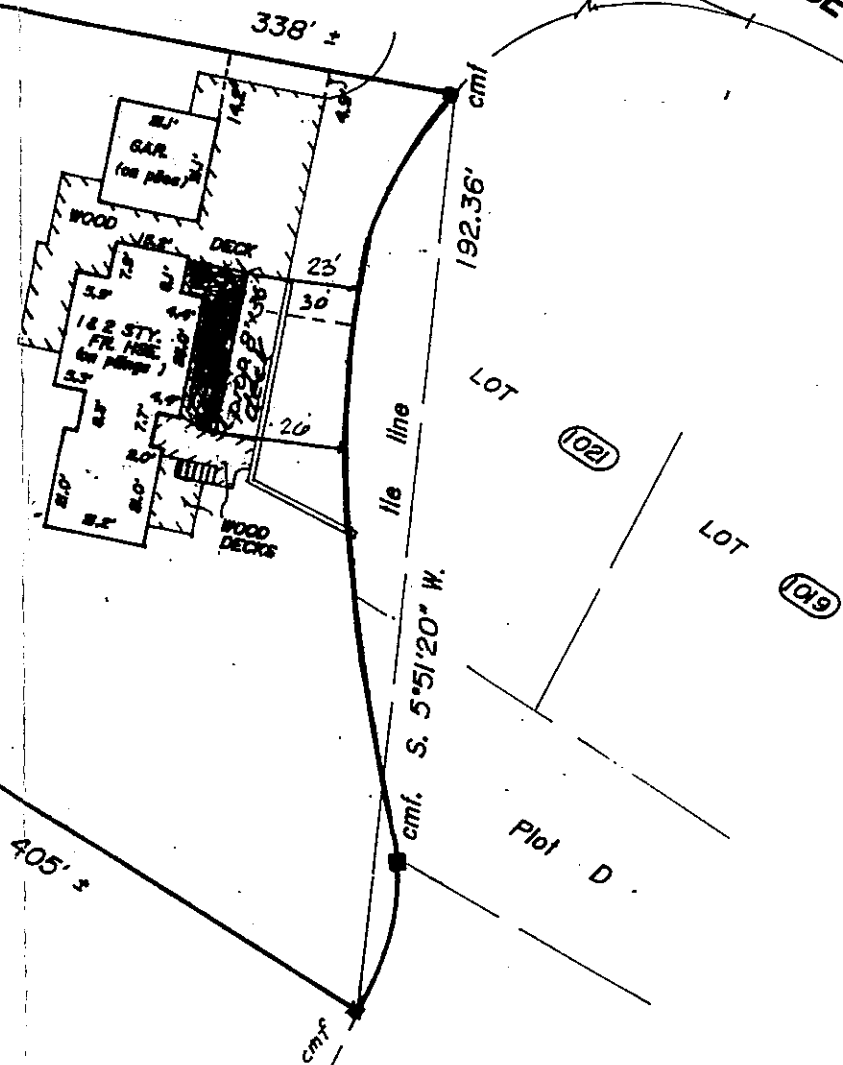

ANY ALTERATION OR ADDITION TO THIS SURVEY IS A VIOLATION OF SECTION 7209 OF THE NEW YORK STATE EDUCATION LAW. EXCEPT AS PER SECTION 7209 - SUBDIVISION 2, ALL CERTIFICATIONS HEREON ARE VALID FOR THIS MAP AND COPIES THEREOF ONLY IF SAID MAP OR COPIES BEAR THE IMPRESSED SEAL OF THE SURVEYOR WHOSE SIGNATURE APPEARS HEREON.

ADDITIONALLY TO COMPLY WITH SAID LAW THE TERM "ALTERED BY" MUST BE USED BY ANY AND ALL SURVEYORS UTILIZING A COPY OF ANOTHER SURVEYOR'S MAP. TERMS SUCH AS "INSPECTED" AND "BROUGHT - TO - DATE" ARE NOT IN COMPLIANCE WITH THE LAW.

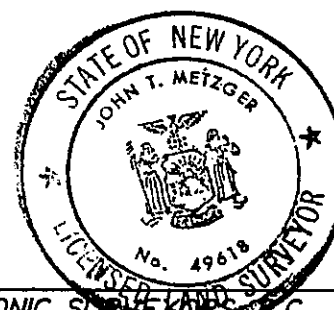

PECONIC SURVEYING, INC.
(631) 765 - 5020 FAX (631) 765 - 1797
P. O. BOX 909
1230 TRAVELER STREET
SOUTHOLD, N.Y. 11971